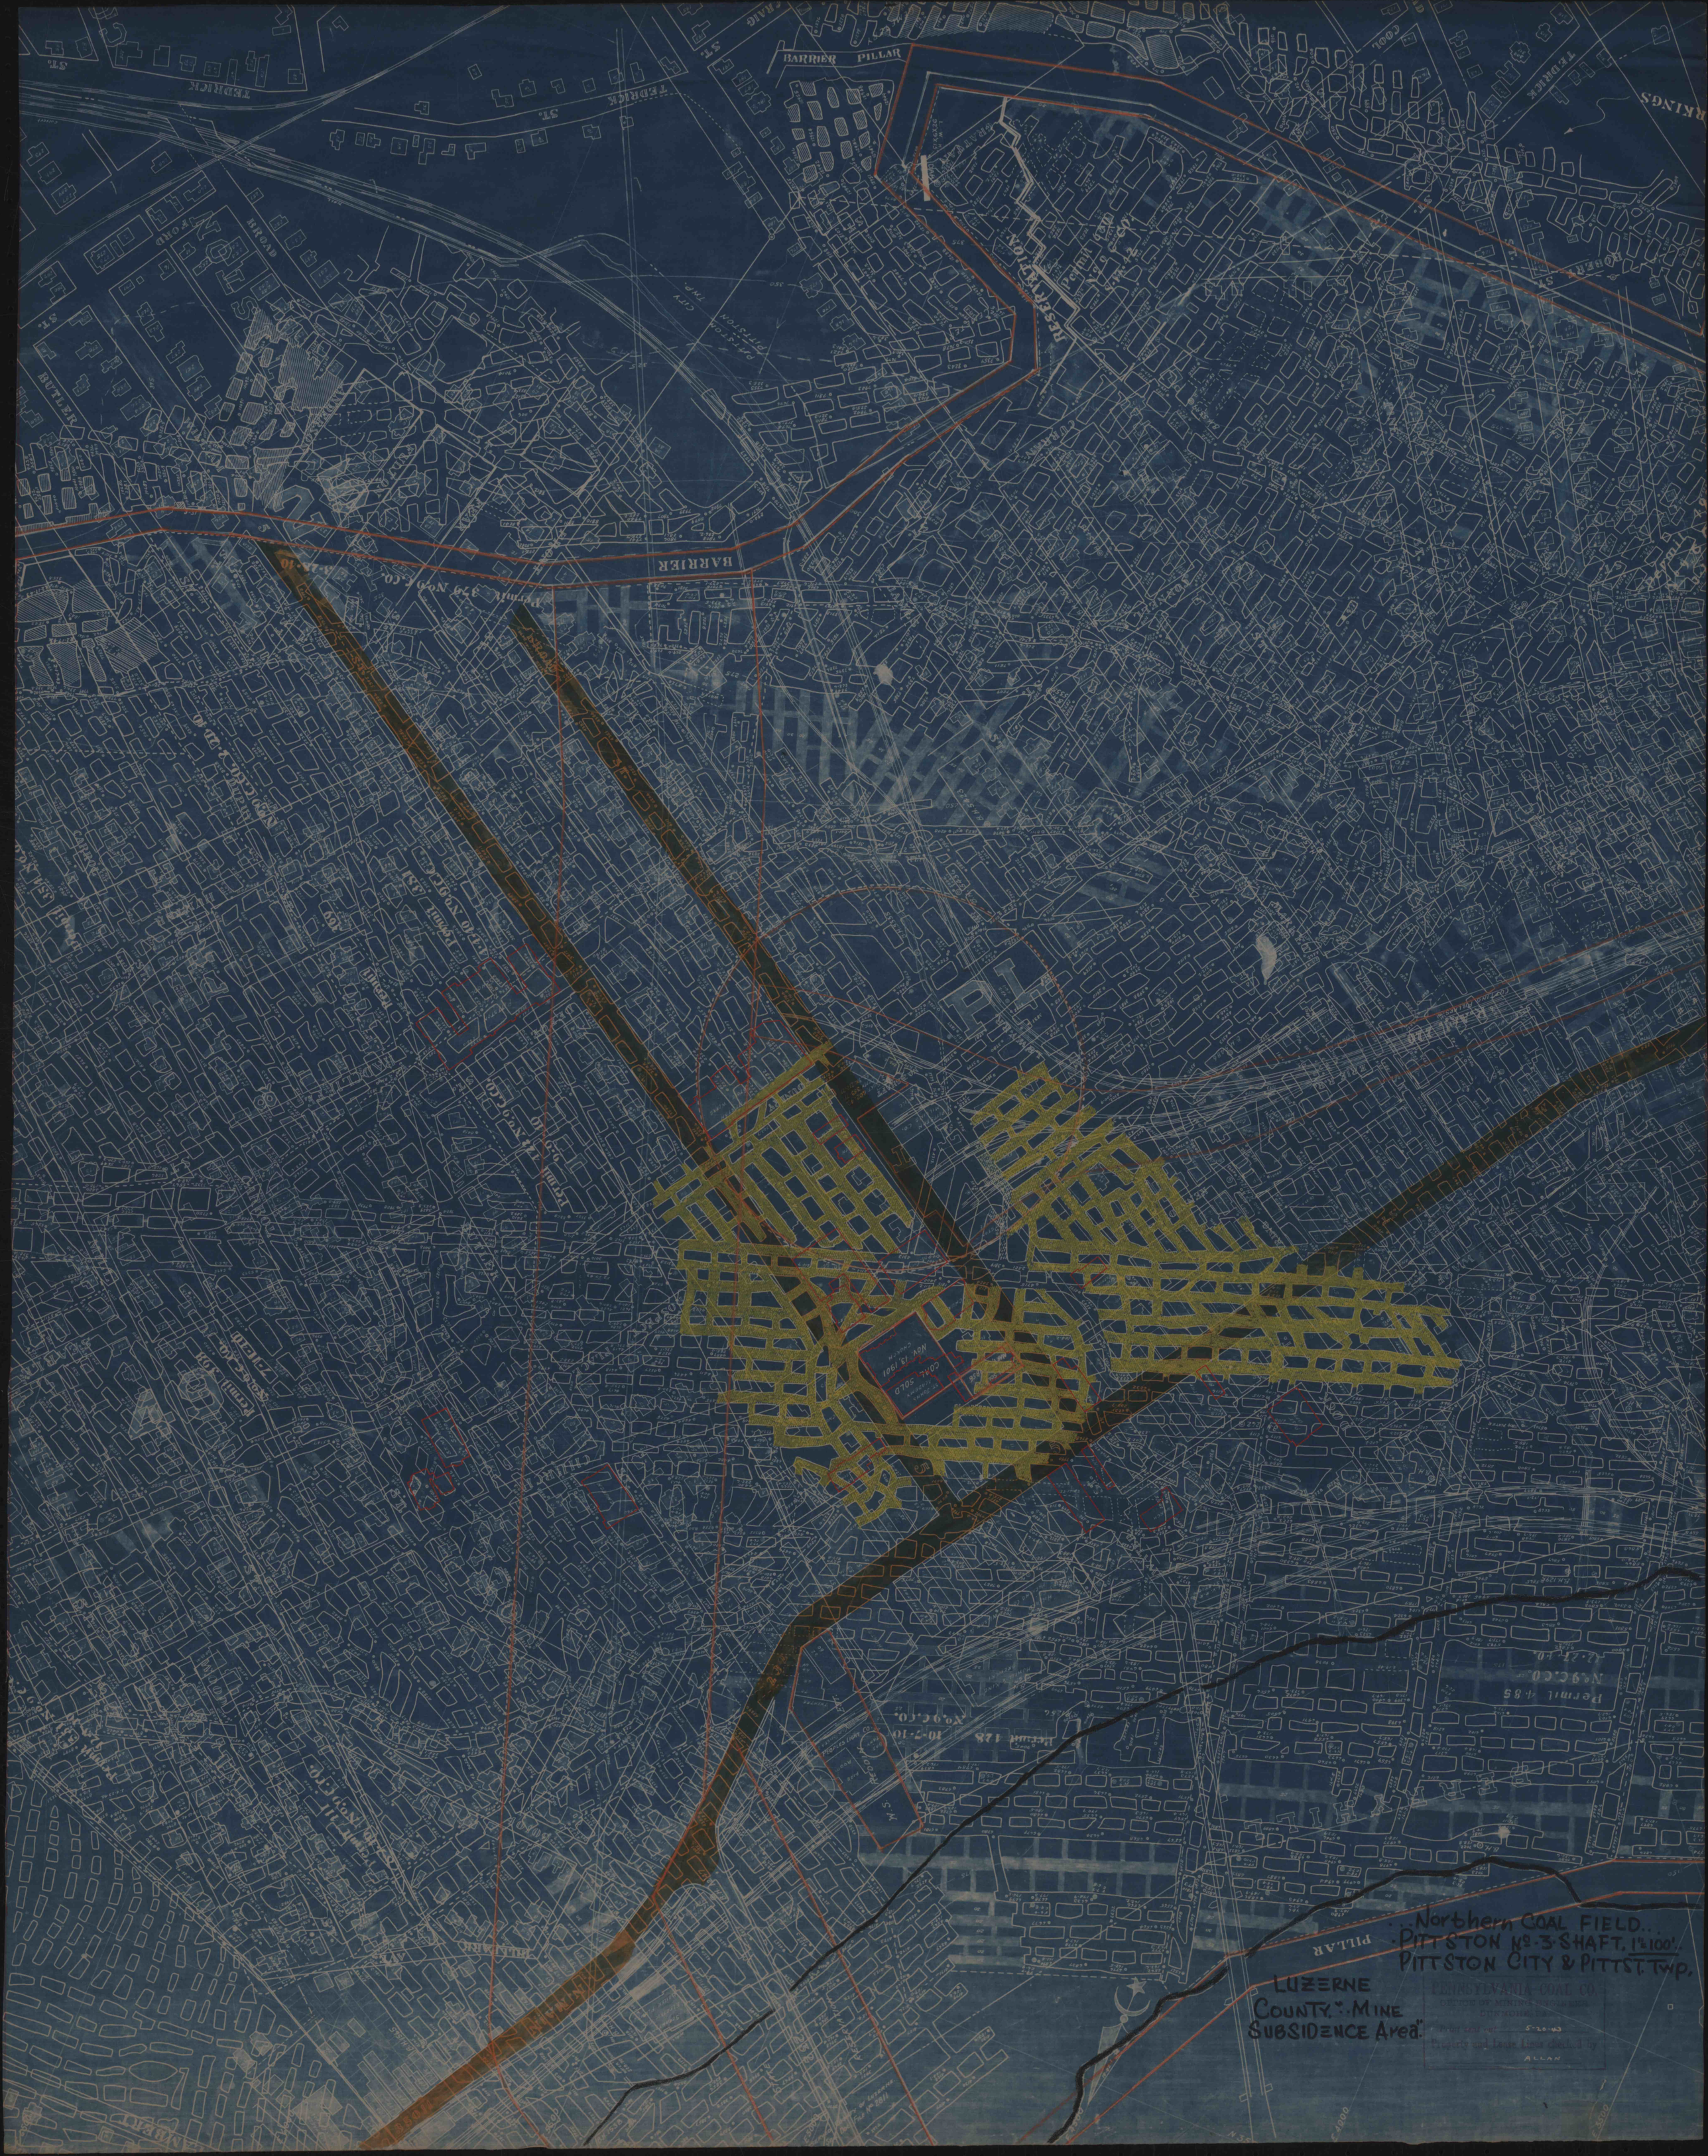
Northern Coal Field.
Pittston No. 3 Shaft. 1" = 100'.
Pittston City & Pittst. Twp.
Luzerne County "Mine Subsidence Area"
Pennsylvania Coal Co.
Office of Mining Engineer
Dunmore
Plot and map 5-20-43
Property and Lease Lines checked by
Allan
Barrier Pillar
Reservation
Permit 428 No. 9 C.O.
Permit 485 No. 9 C.O.
Permit 229 No. 9 C.O.
Permit 231 No. 9 C.O.
Permit 229 No. 9 C.O.
Permit 128 No. 9 C.O.
Permit 229 No. 9 C.O.
Permit 229 No. 9 C.O.
Permit 229