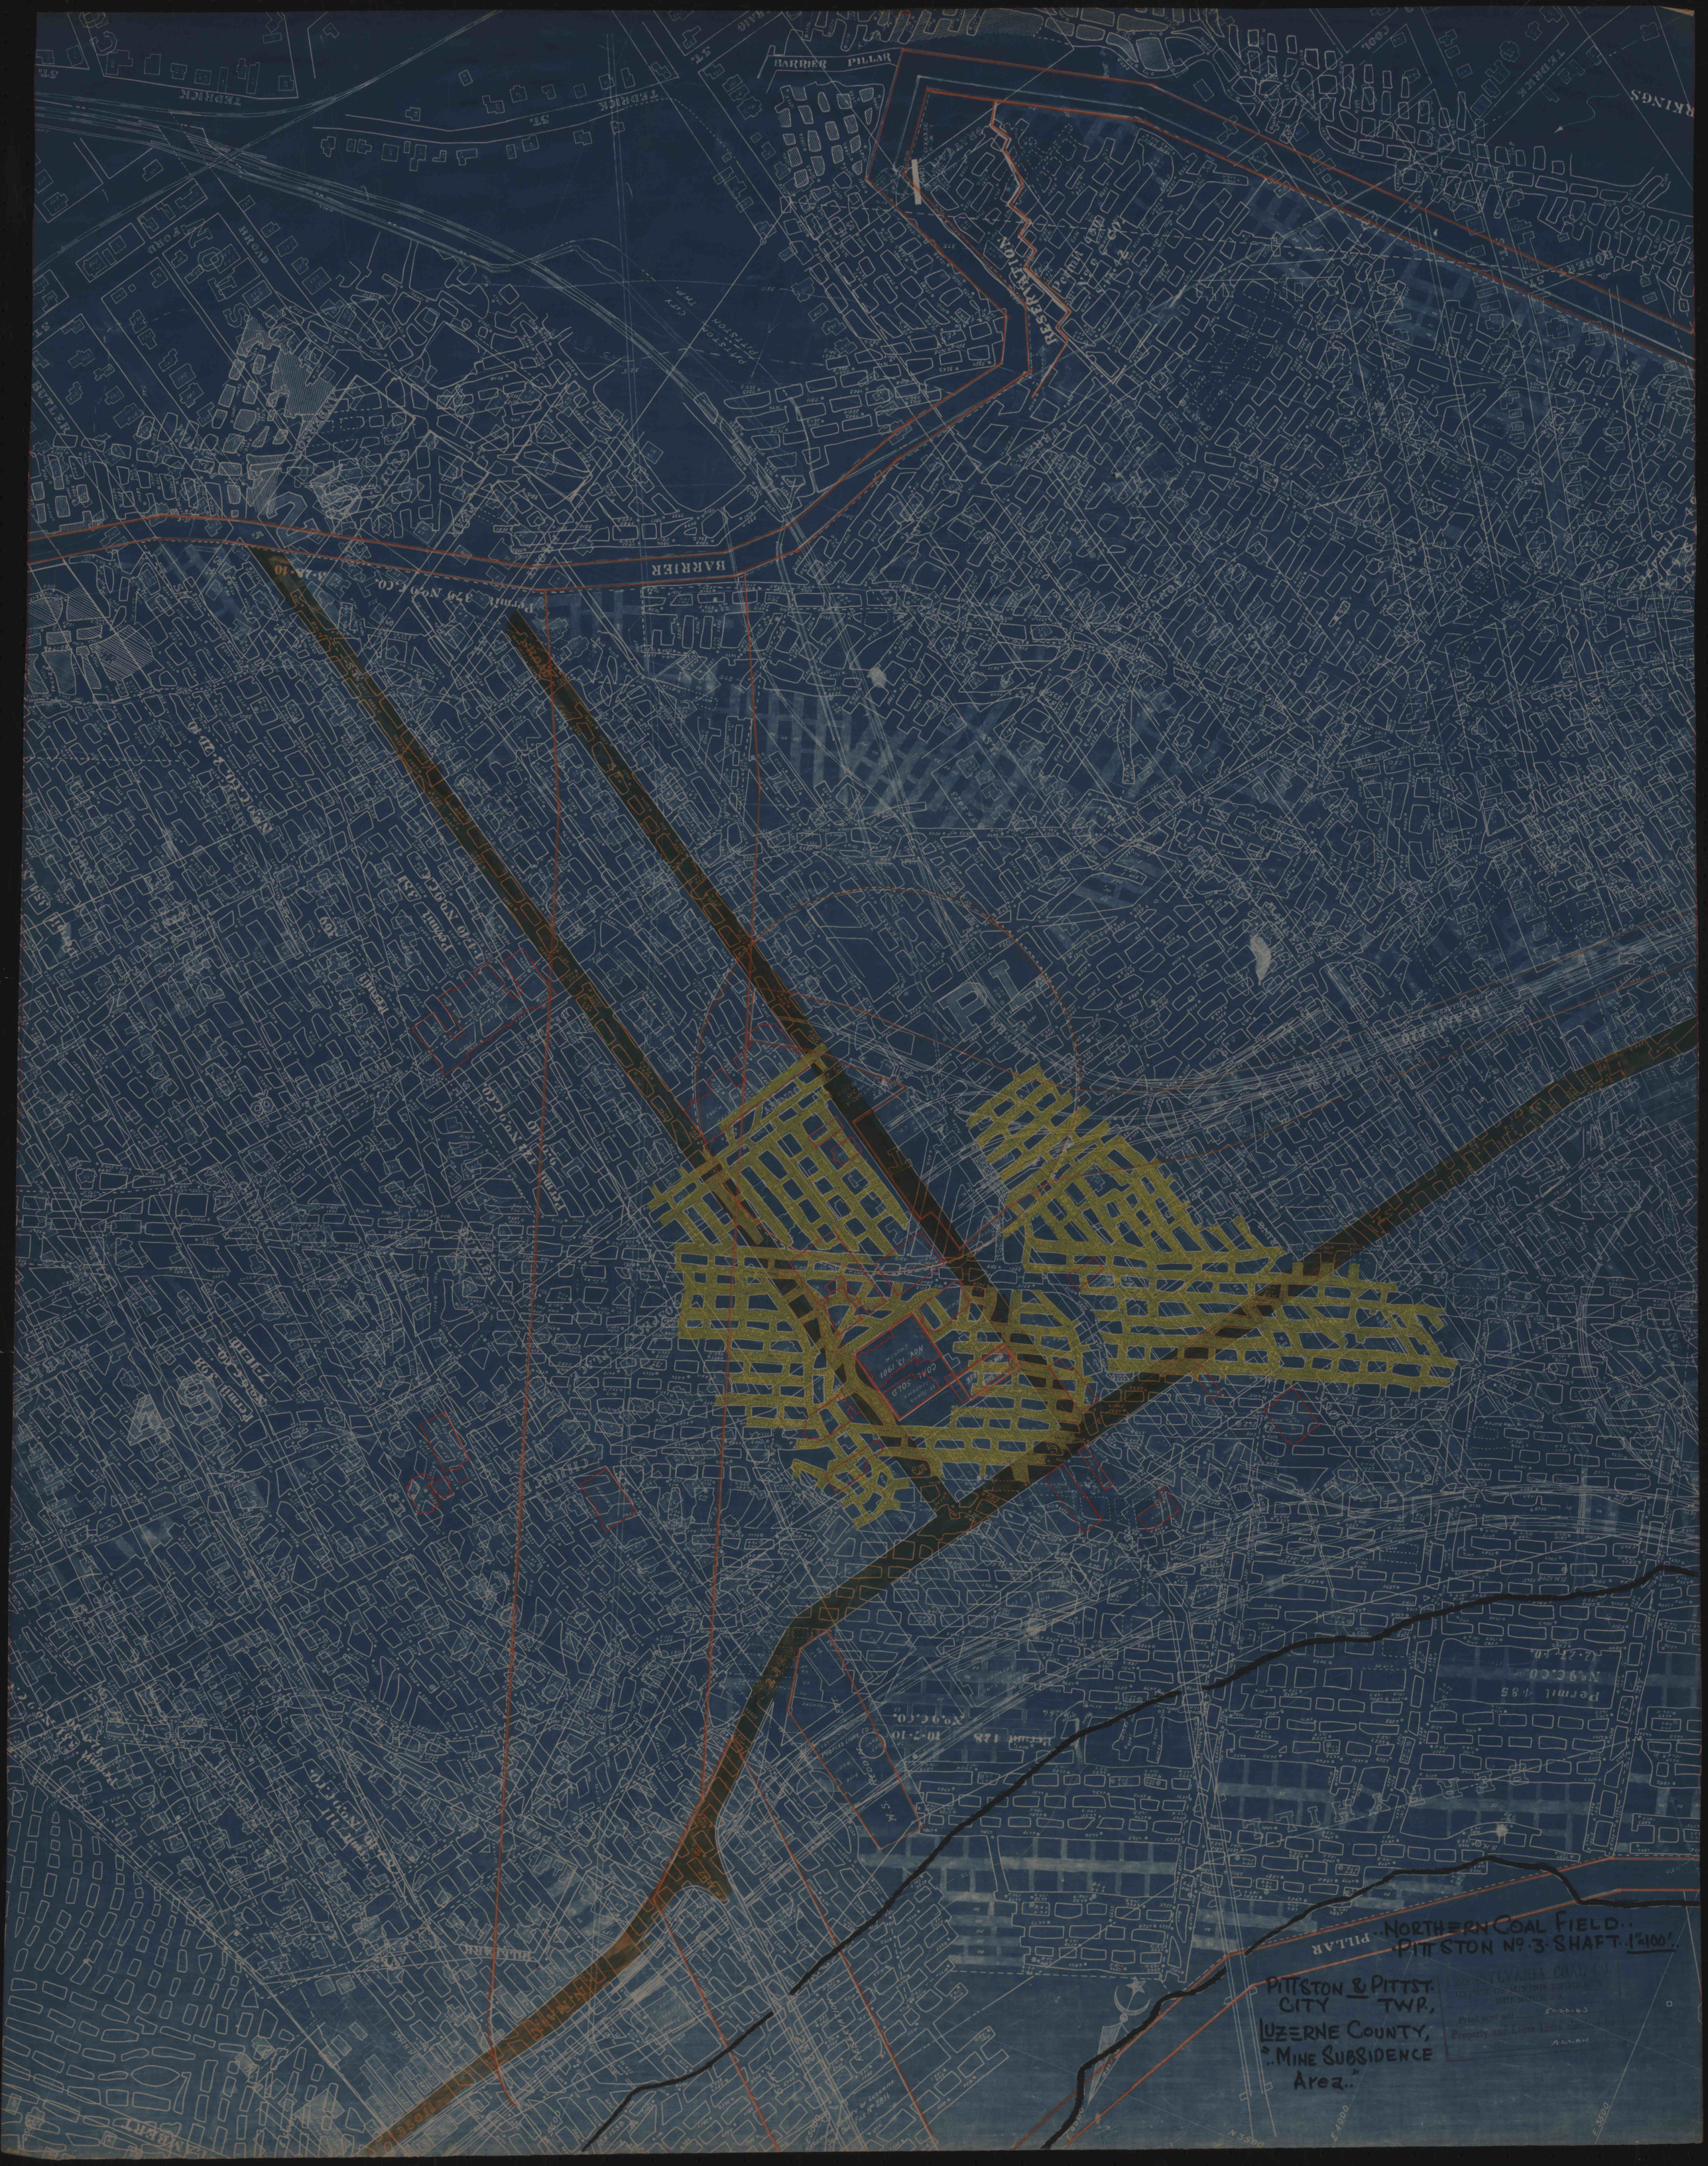
NORTHERN COAL FIELD
PITTSTON No. 3 SHAFT 1"=100'
PITTSTON & PITTST. CITY TWP.,
LUZERNE COUNTY,
"MINE SUBSIDENCE Area"
BARRIER PILLAR
BARRIER
PILLAR
PRESERVATION
Permit 376 No. 9 Co.
Permit 331 No. 9 Co.
Permit 128 No. 9 Co.
Permit 485 No. 9 Co.
COAL SOLD
Nov. 13, 1901
PENNSYLVANIA COAL CO.
OFFICE OF MINING ENGINEER
DUNMORE, PA.
5-20-43
Plot set up
Property and Lease Lines shown
ALLAN
N.3500
E.4000
E.5500