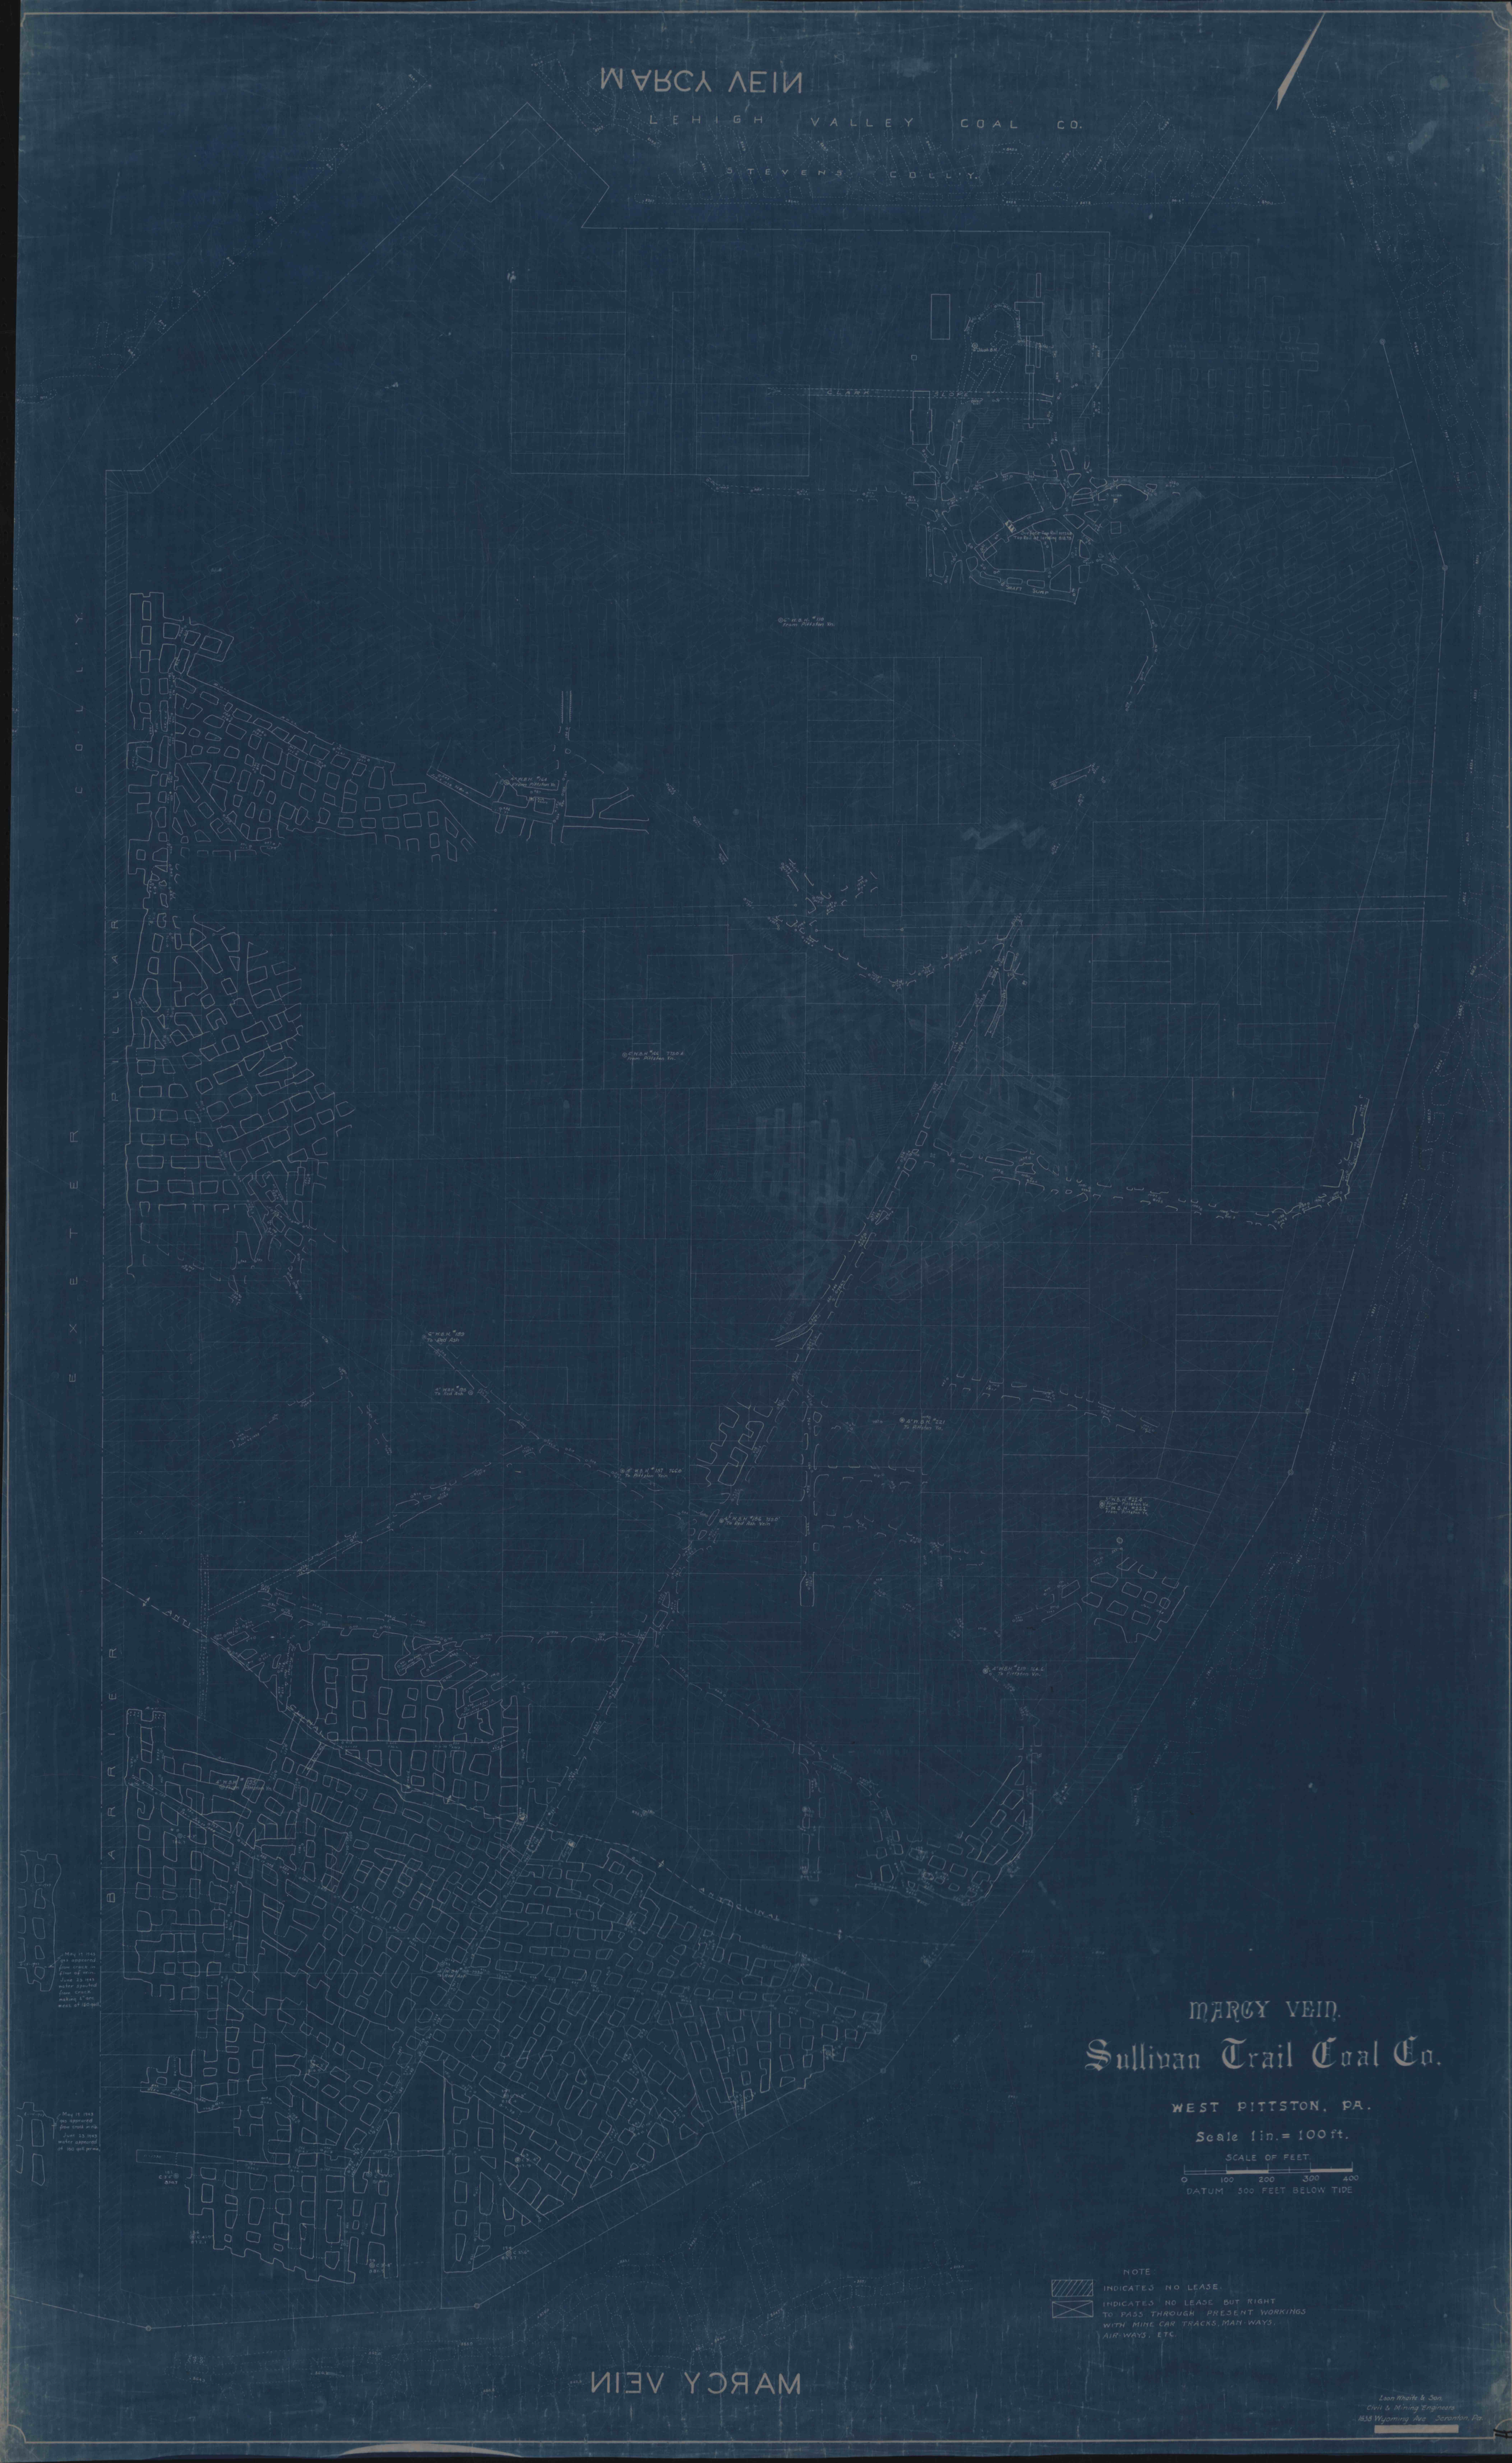
MARCY VEIN
LEHIGH VALLEY COAL CO.
STEVENS COLLIERY
CLARK SLOPE
SHAFT SUMP
PLAINTER
MARCY VEIN
MARCY VEIN.
Sullivan Trail Coal Co.
WEST PITTSTON, PA.
Scale 1 in. = 100 ft.
SCALE OF FEET
0 100 200 300 400
DATUM 500 FEET BELOW TIDE
NOTE
INDICATES NO LEASE.
INDICATES NO LEASE BUT RIGHT TO PASS THROUGH PRESENT WORKINGS WITH MINE CAR TRACKS, MAIN WAYS, AIR WAYS, ETC.
Leon Whaite & Son
Civil & Mining Engineers
1638 Wyoming Ave Scranton, Pa.