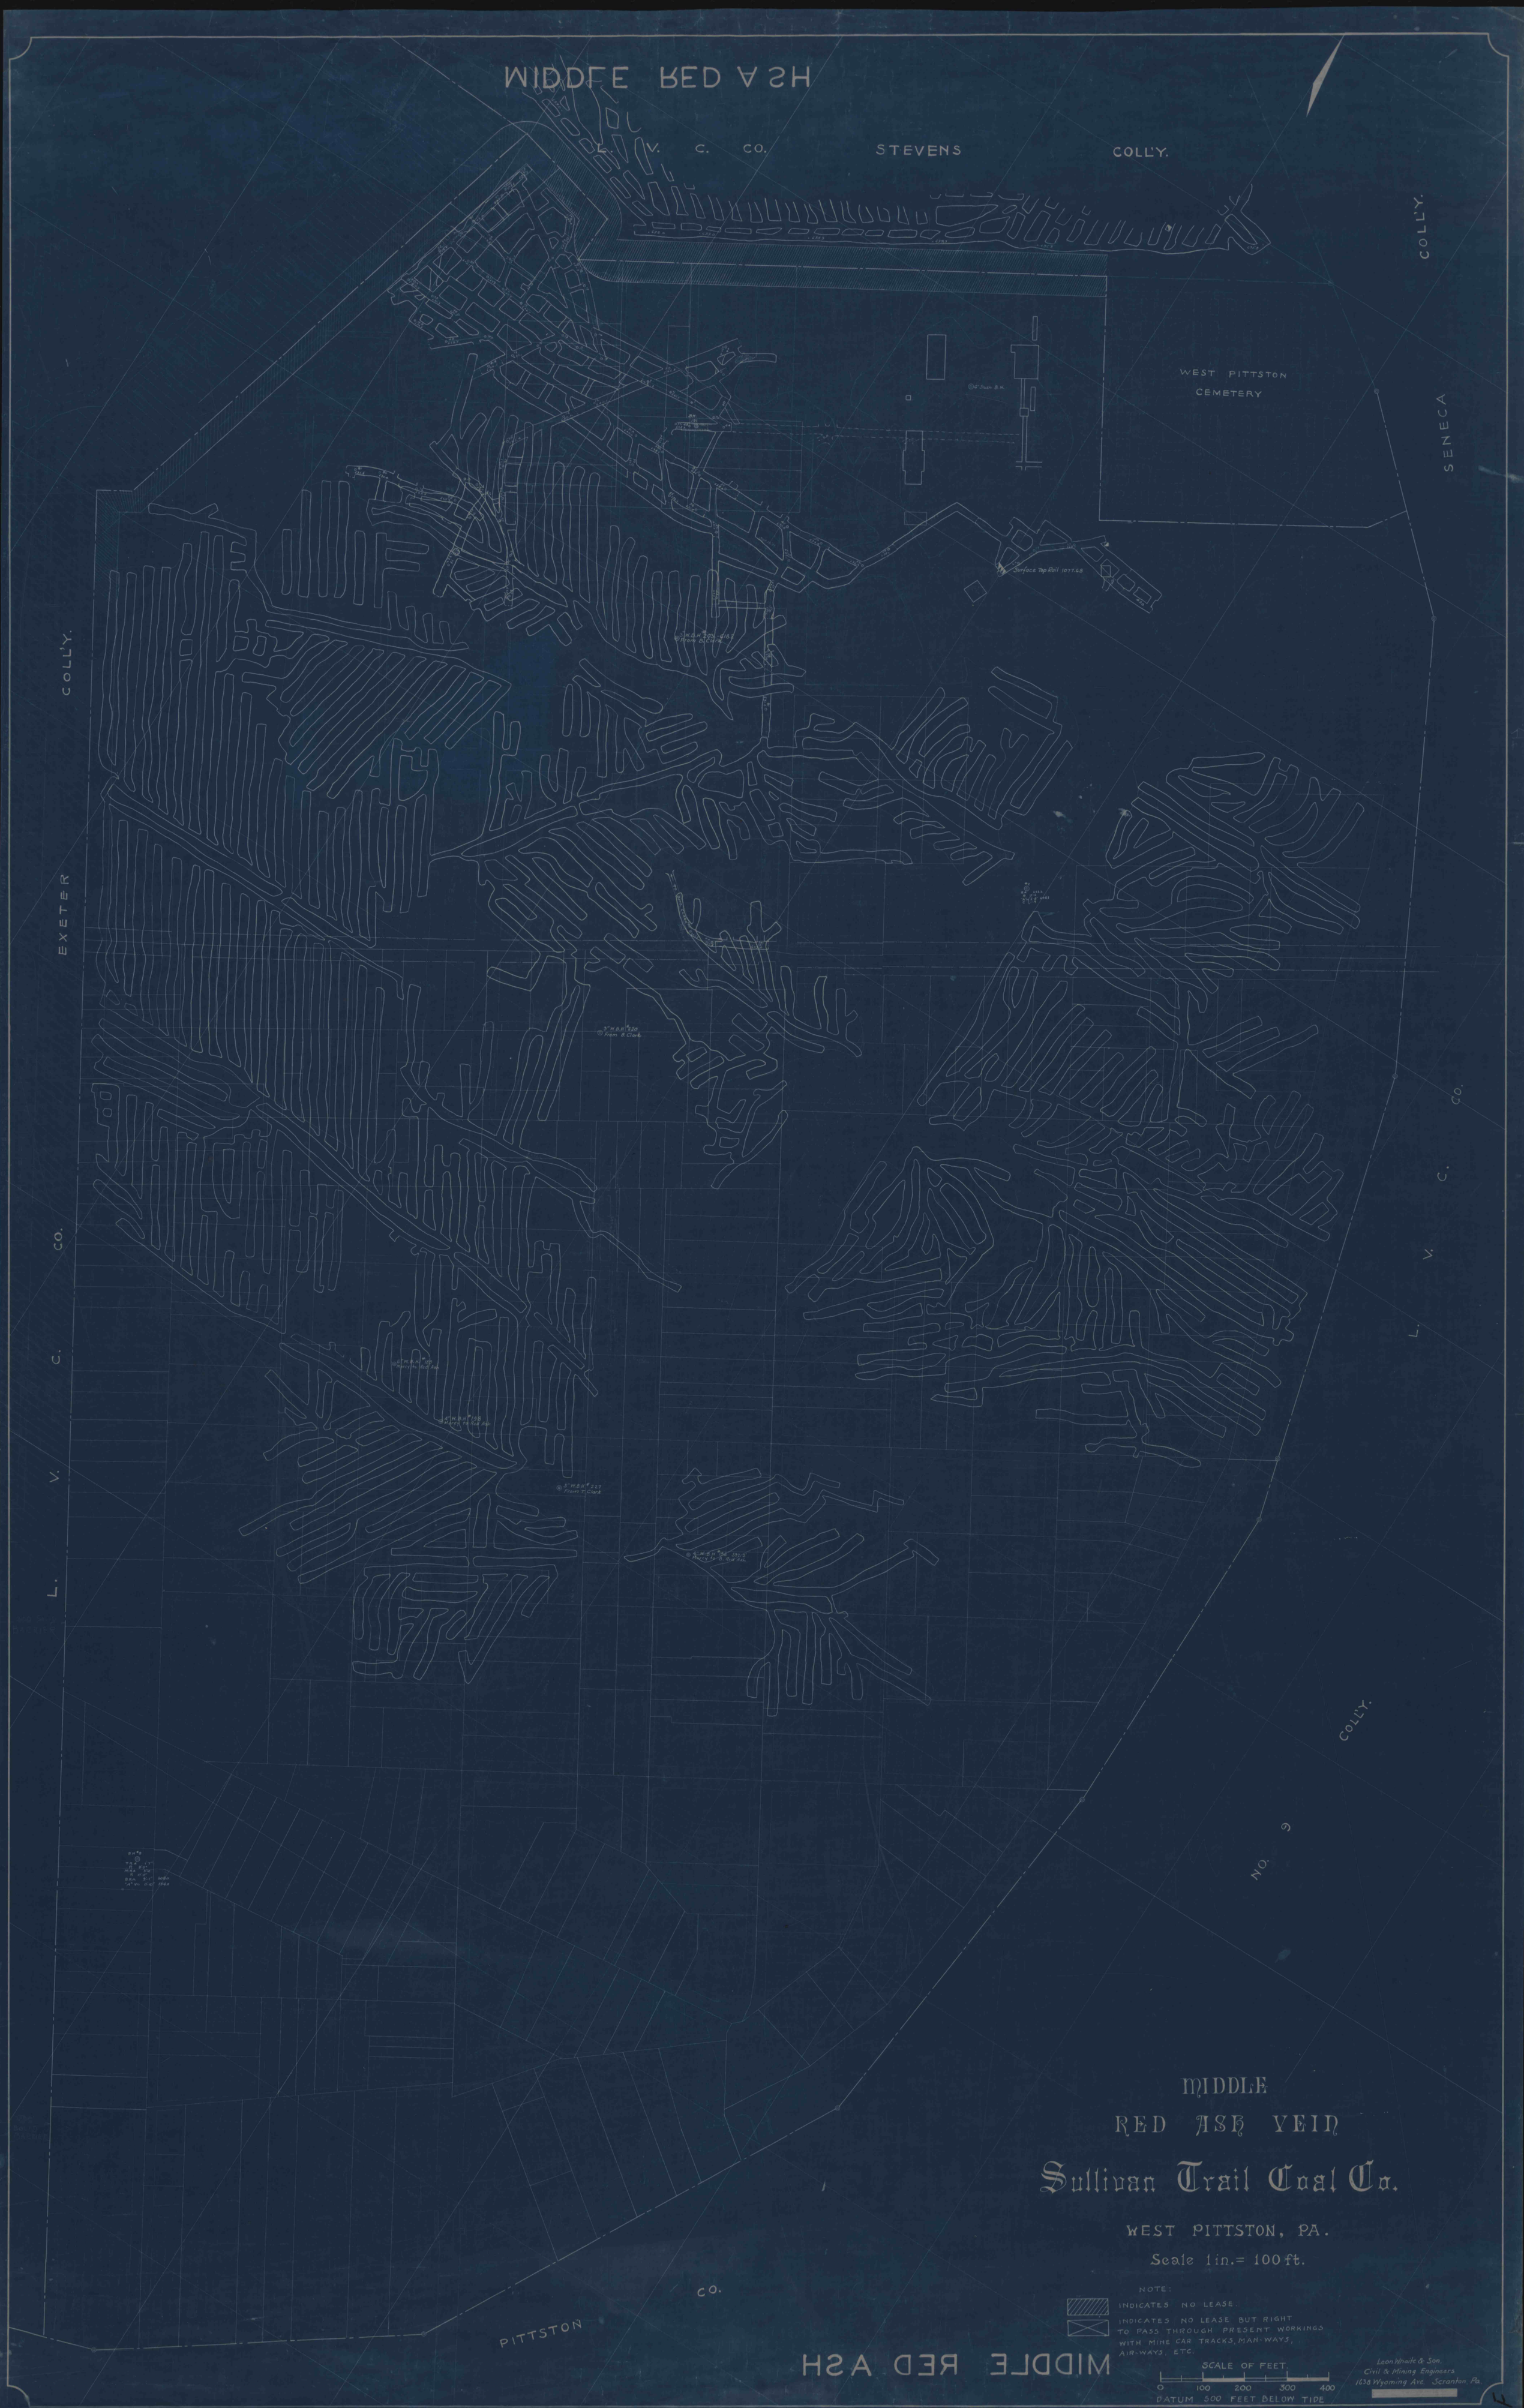
MIDDLE RED ASH
L. V. C. CO.
STEVENS COLL'Y.
COLL'Y.
WEST PITTSTON CEMETERY
SENECA
Surface Top Rail 1077.68
COLL'Y.
EXETER
CO.
C.
L. V. C. CO.
L. V.
COLL'Y.
NO. 9
CO.
PITTSTON
MIDDLE RED ASH
MIDDLE
RED ASH VEIN
Sullivan Trail Coal Co.
WEST PITTSTON, PA.
Scale 1 in. = 100 ft.
NOTE:
INDICATES NO LEASE.
INDICATES NO LEASE BUT RIGHT TO PASS THROUGH PRESENT WORKINGS WITH MINE CAR TRACKS, MAN-WAYS, AIR-WAYS, ETC.
SCALE OF FEET.
0 100 200 300 400
DATUM 500 FEET BELOW TIDE
Leon Whaite & Son,
Civil & Mining Engineers
1638 Wyoming Ave. Scranton, Pa.