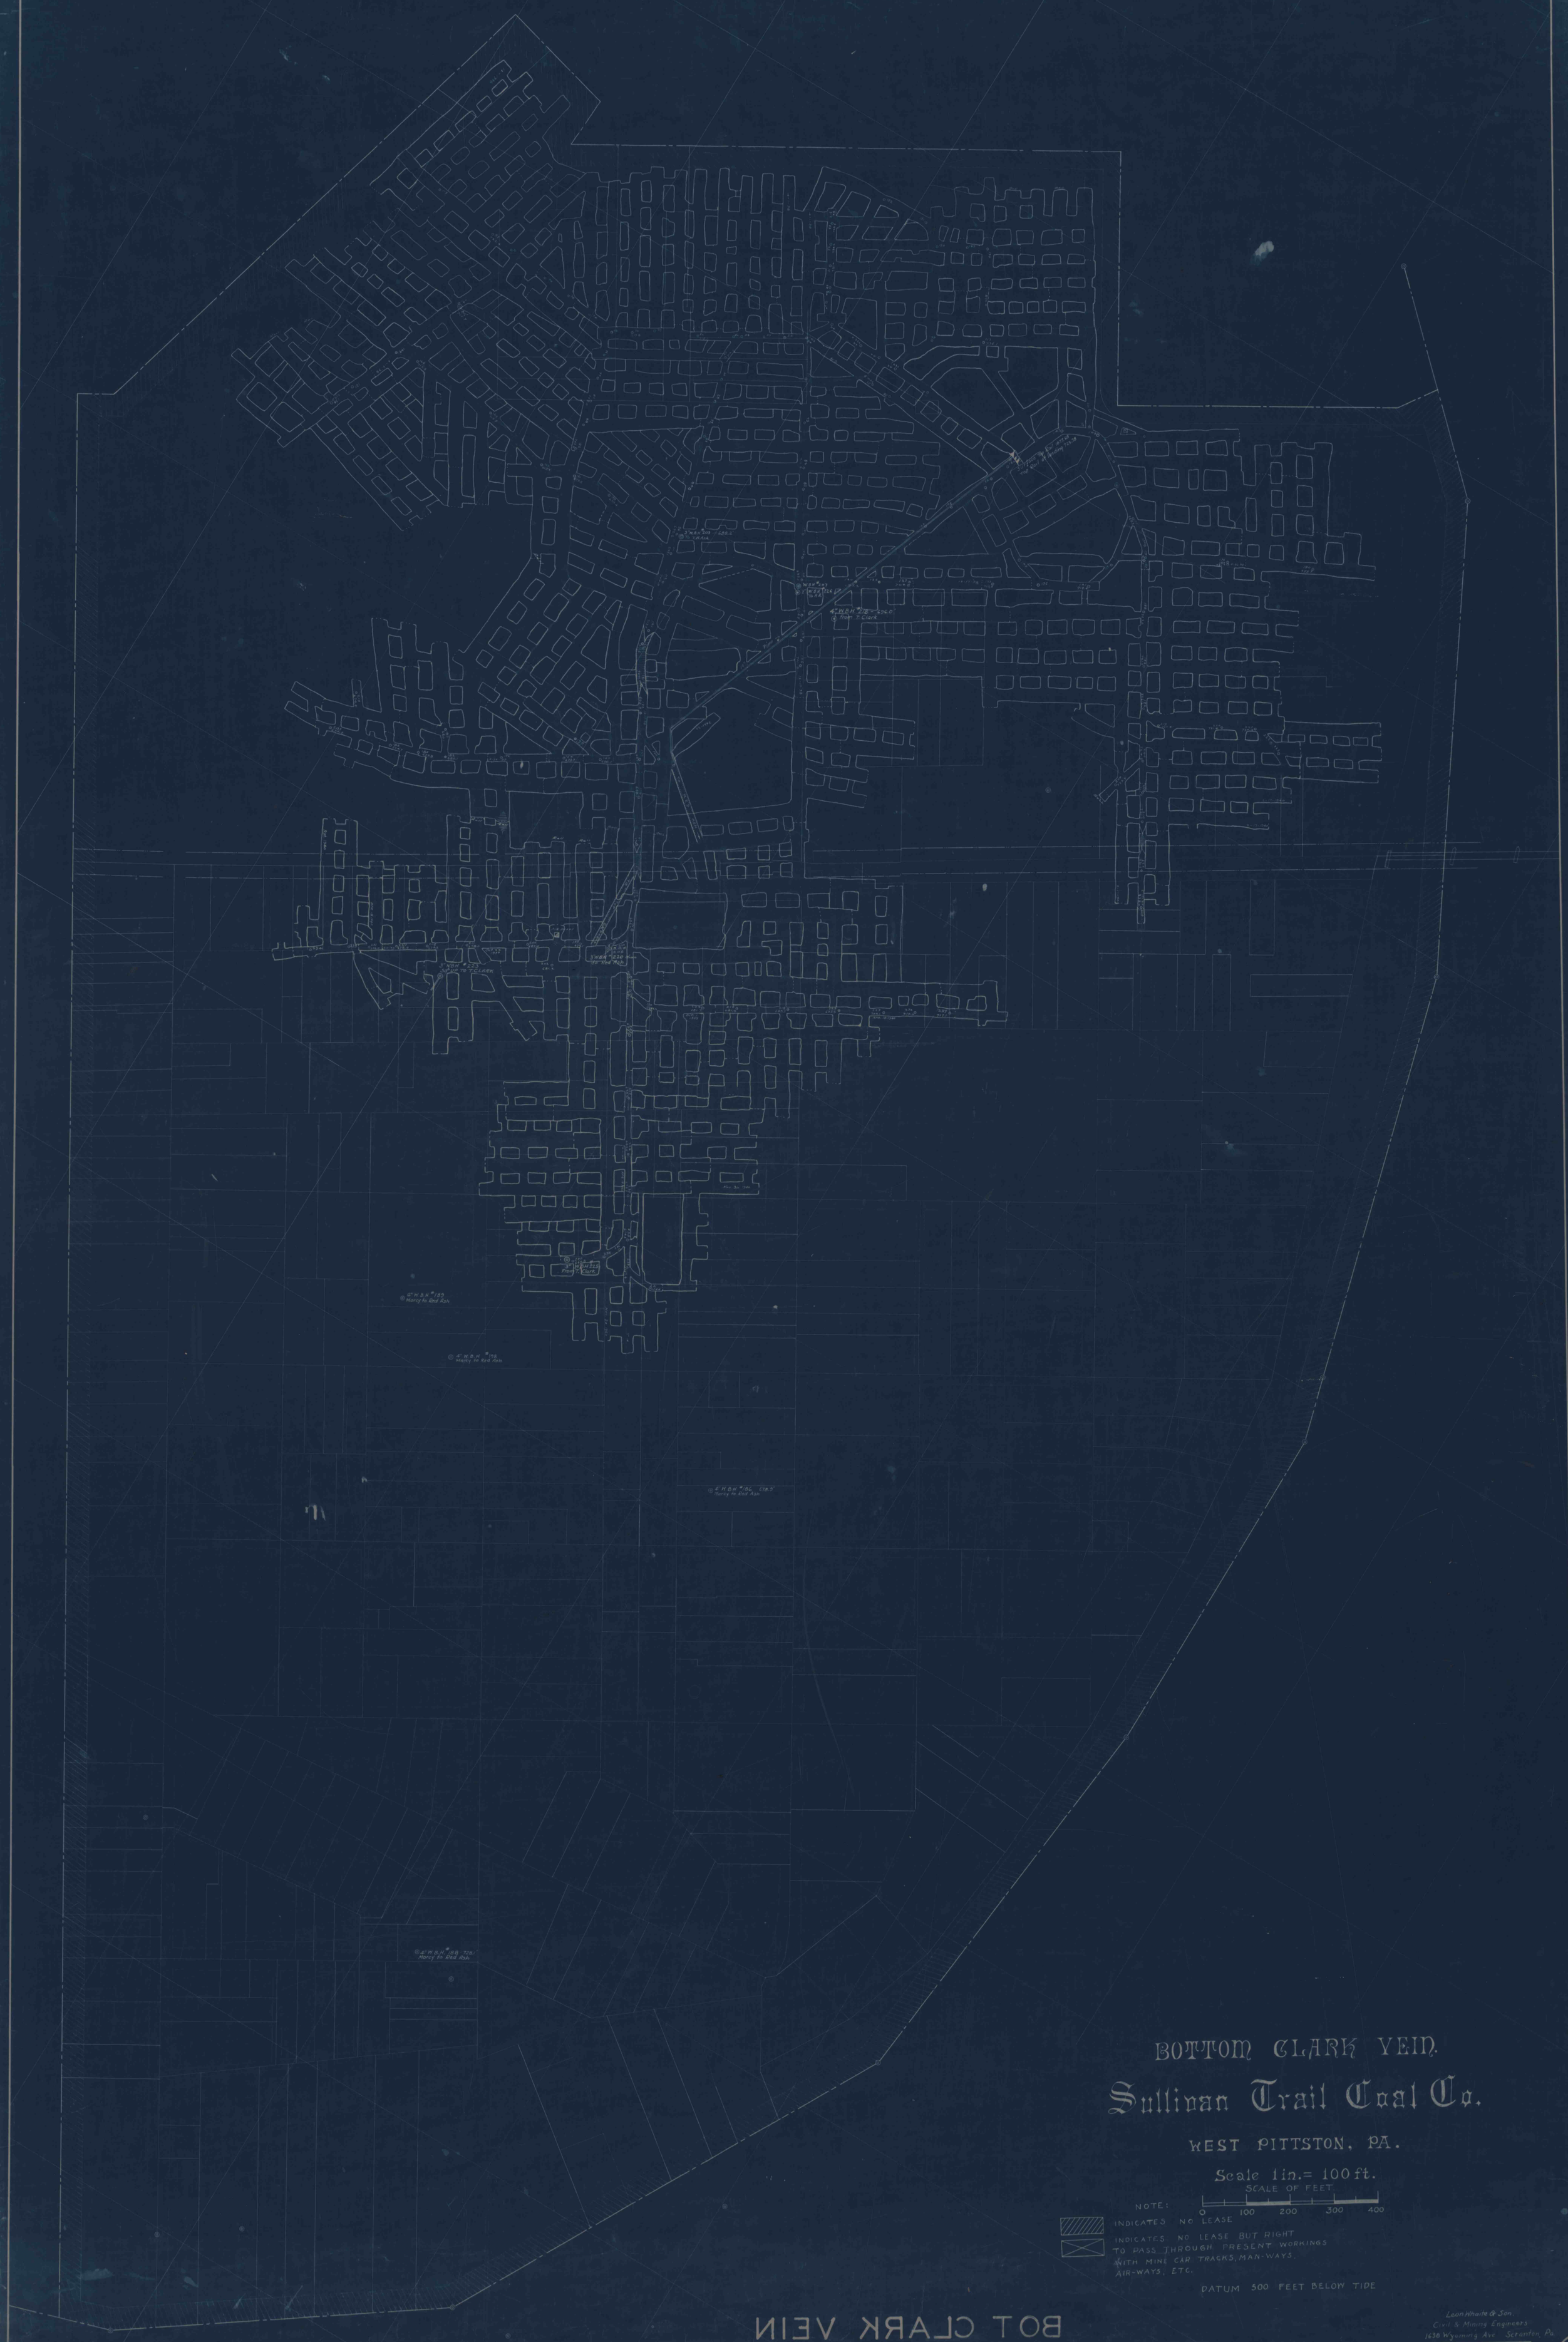

BOTTOM CLARK VEIN.

Sullivan Trail Coal Co.

WEST PITTSTON, PA.

Scale 1 in. = 100 ft.

SCALE OF FEET

0 100 200 300 400

NOTE:

INDICATES NO LEASE

INDICATES NO LEASE BUT RIGHT TO PASS THROUGH PRESENT WORKINGS WITH MINE CAR TRACKS, MAN-WAYS, AIR-WAYS, ETC.

DATUM 500 FEET BELOW TIDE

Leon Whaite & Son.
Civil & Mining Engineers
1638 Wyoming Ave Scranton, Pa.