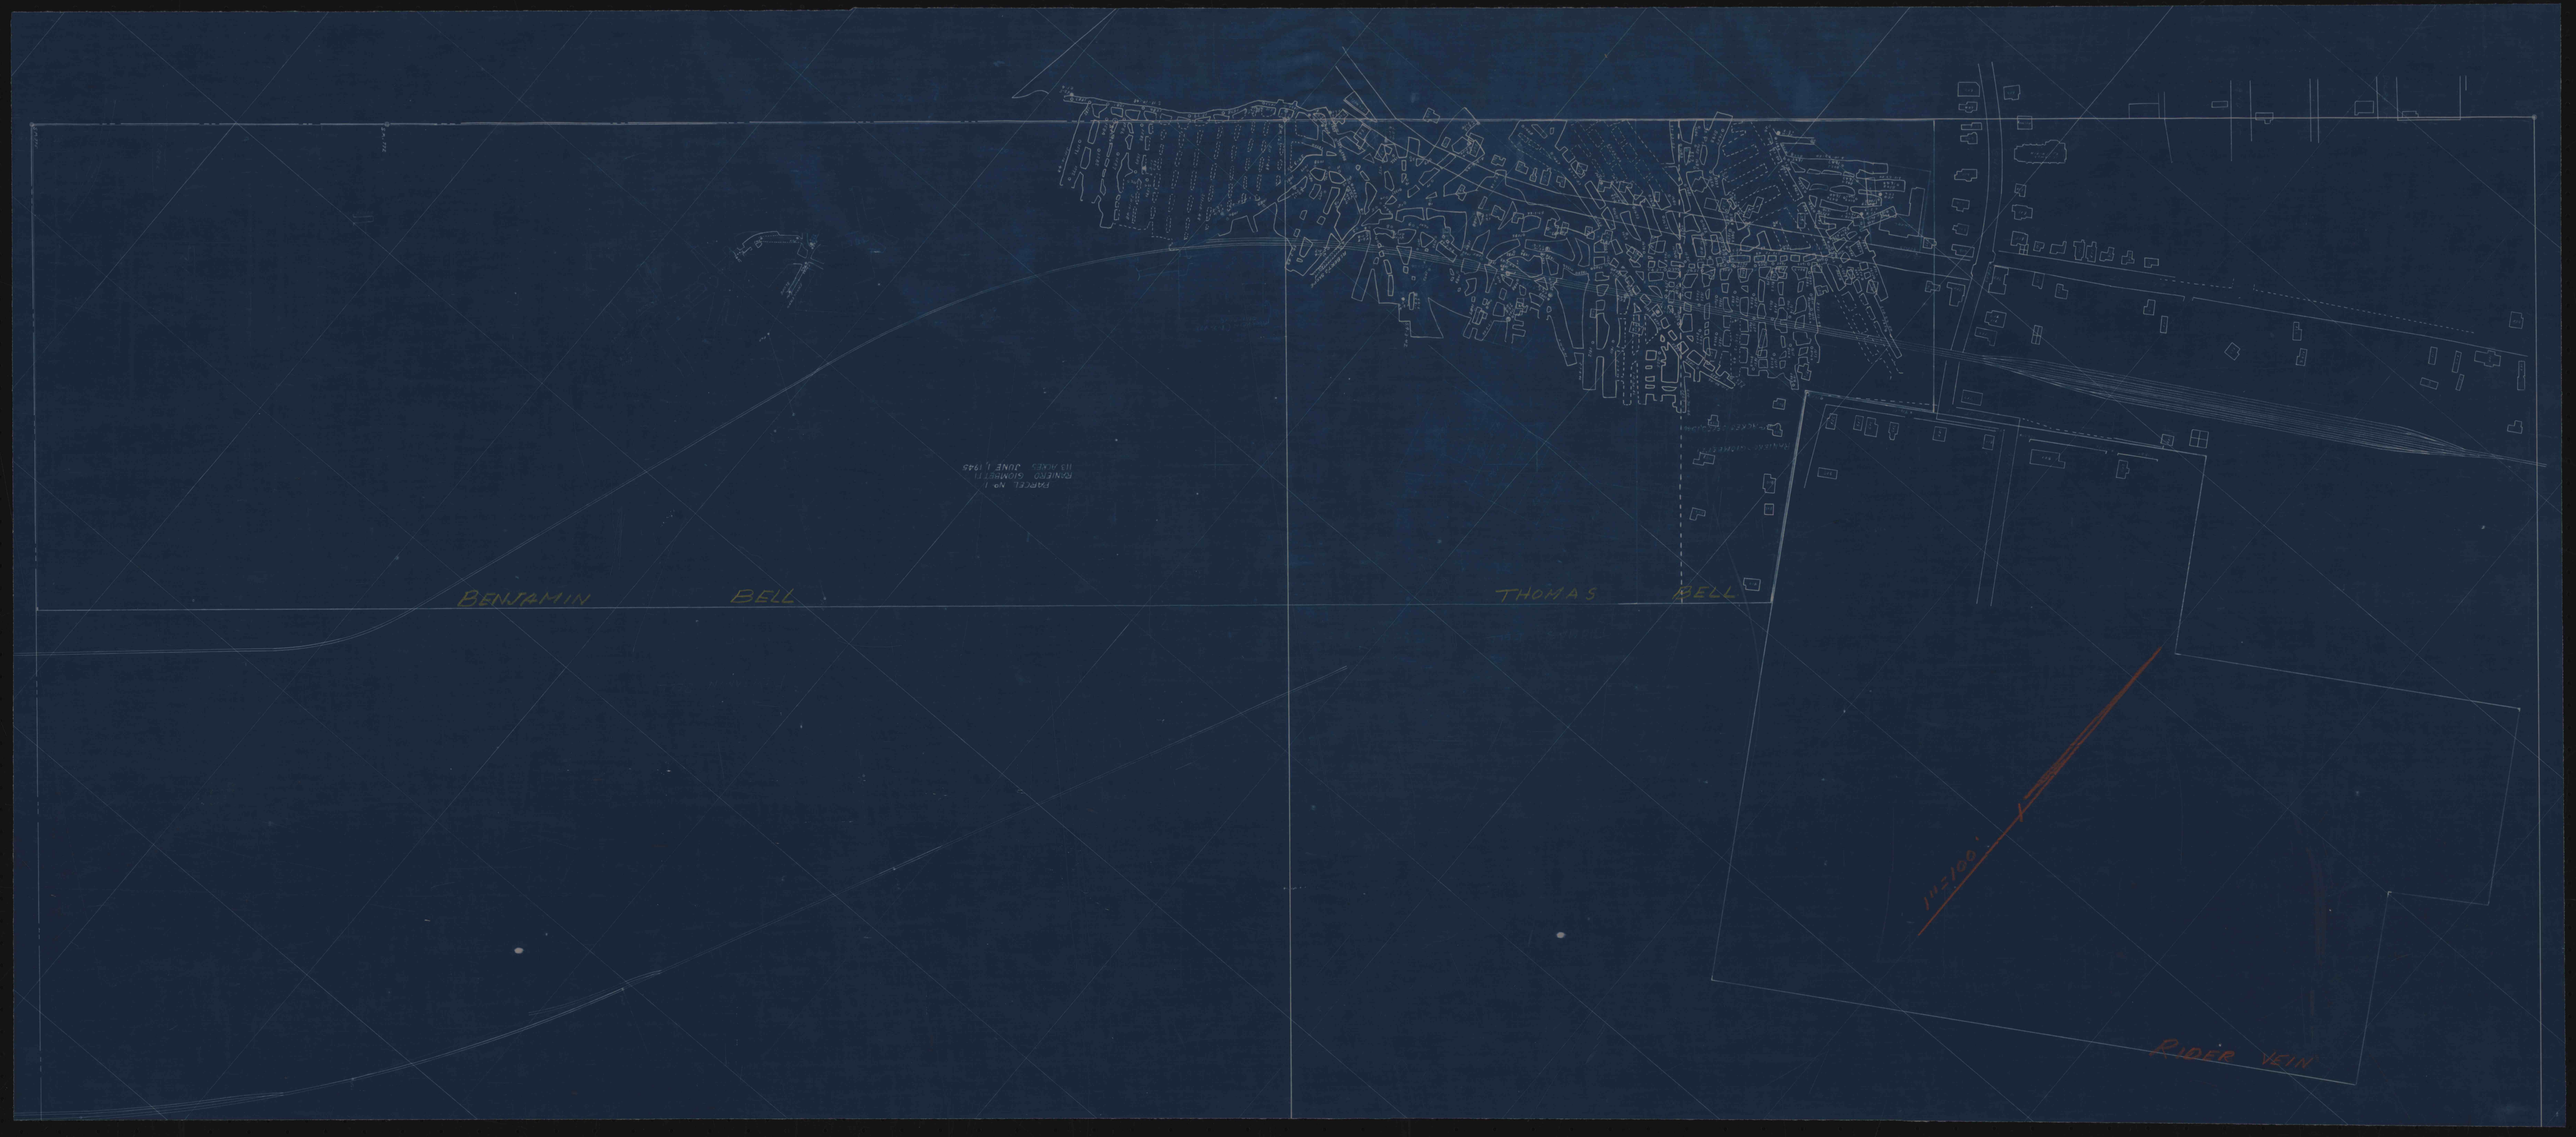
BENJAMIN BELL
THOMAS BELL
1"=100'
RIDER VEIN