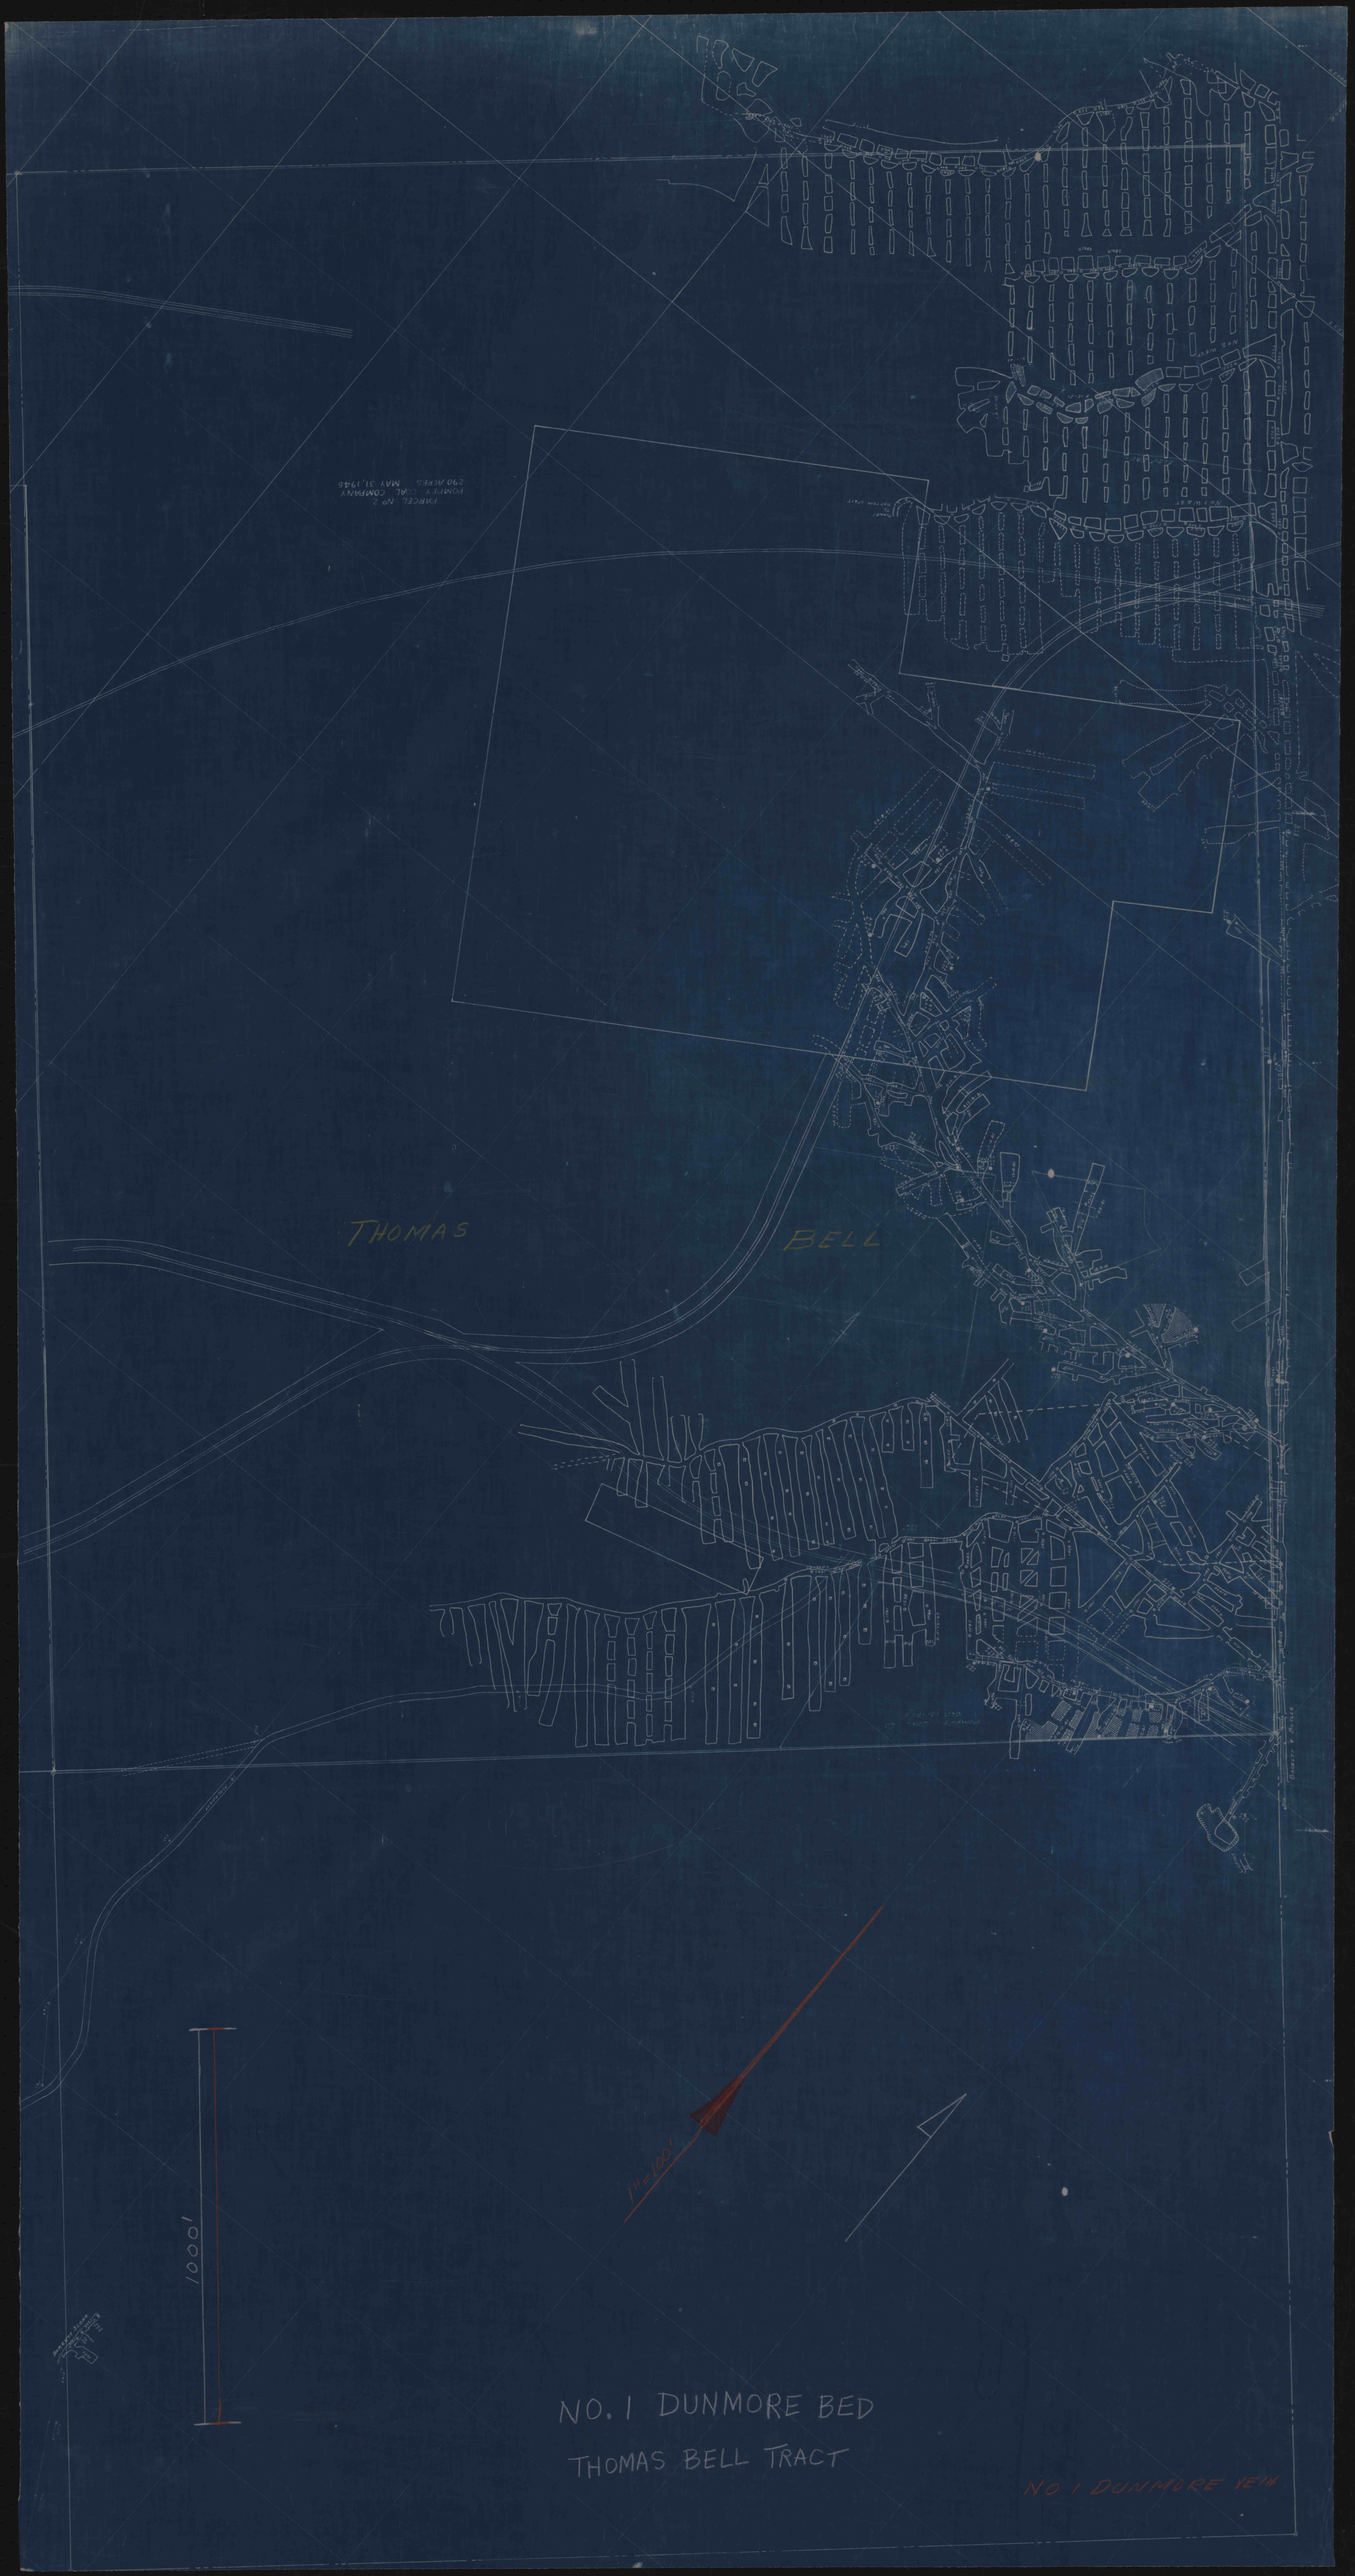

NO. 1 DUNMORE BED

THOMAS BELL TRACT

