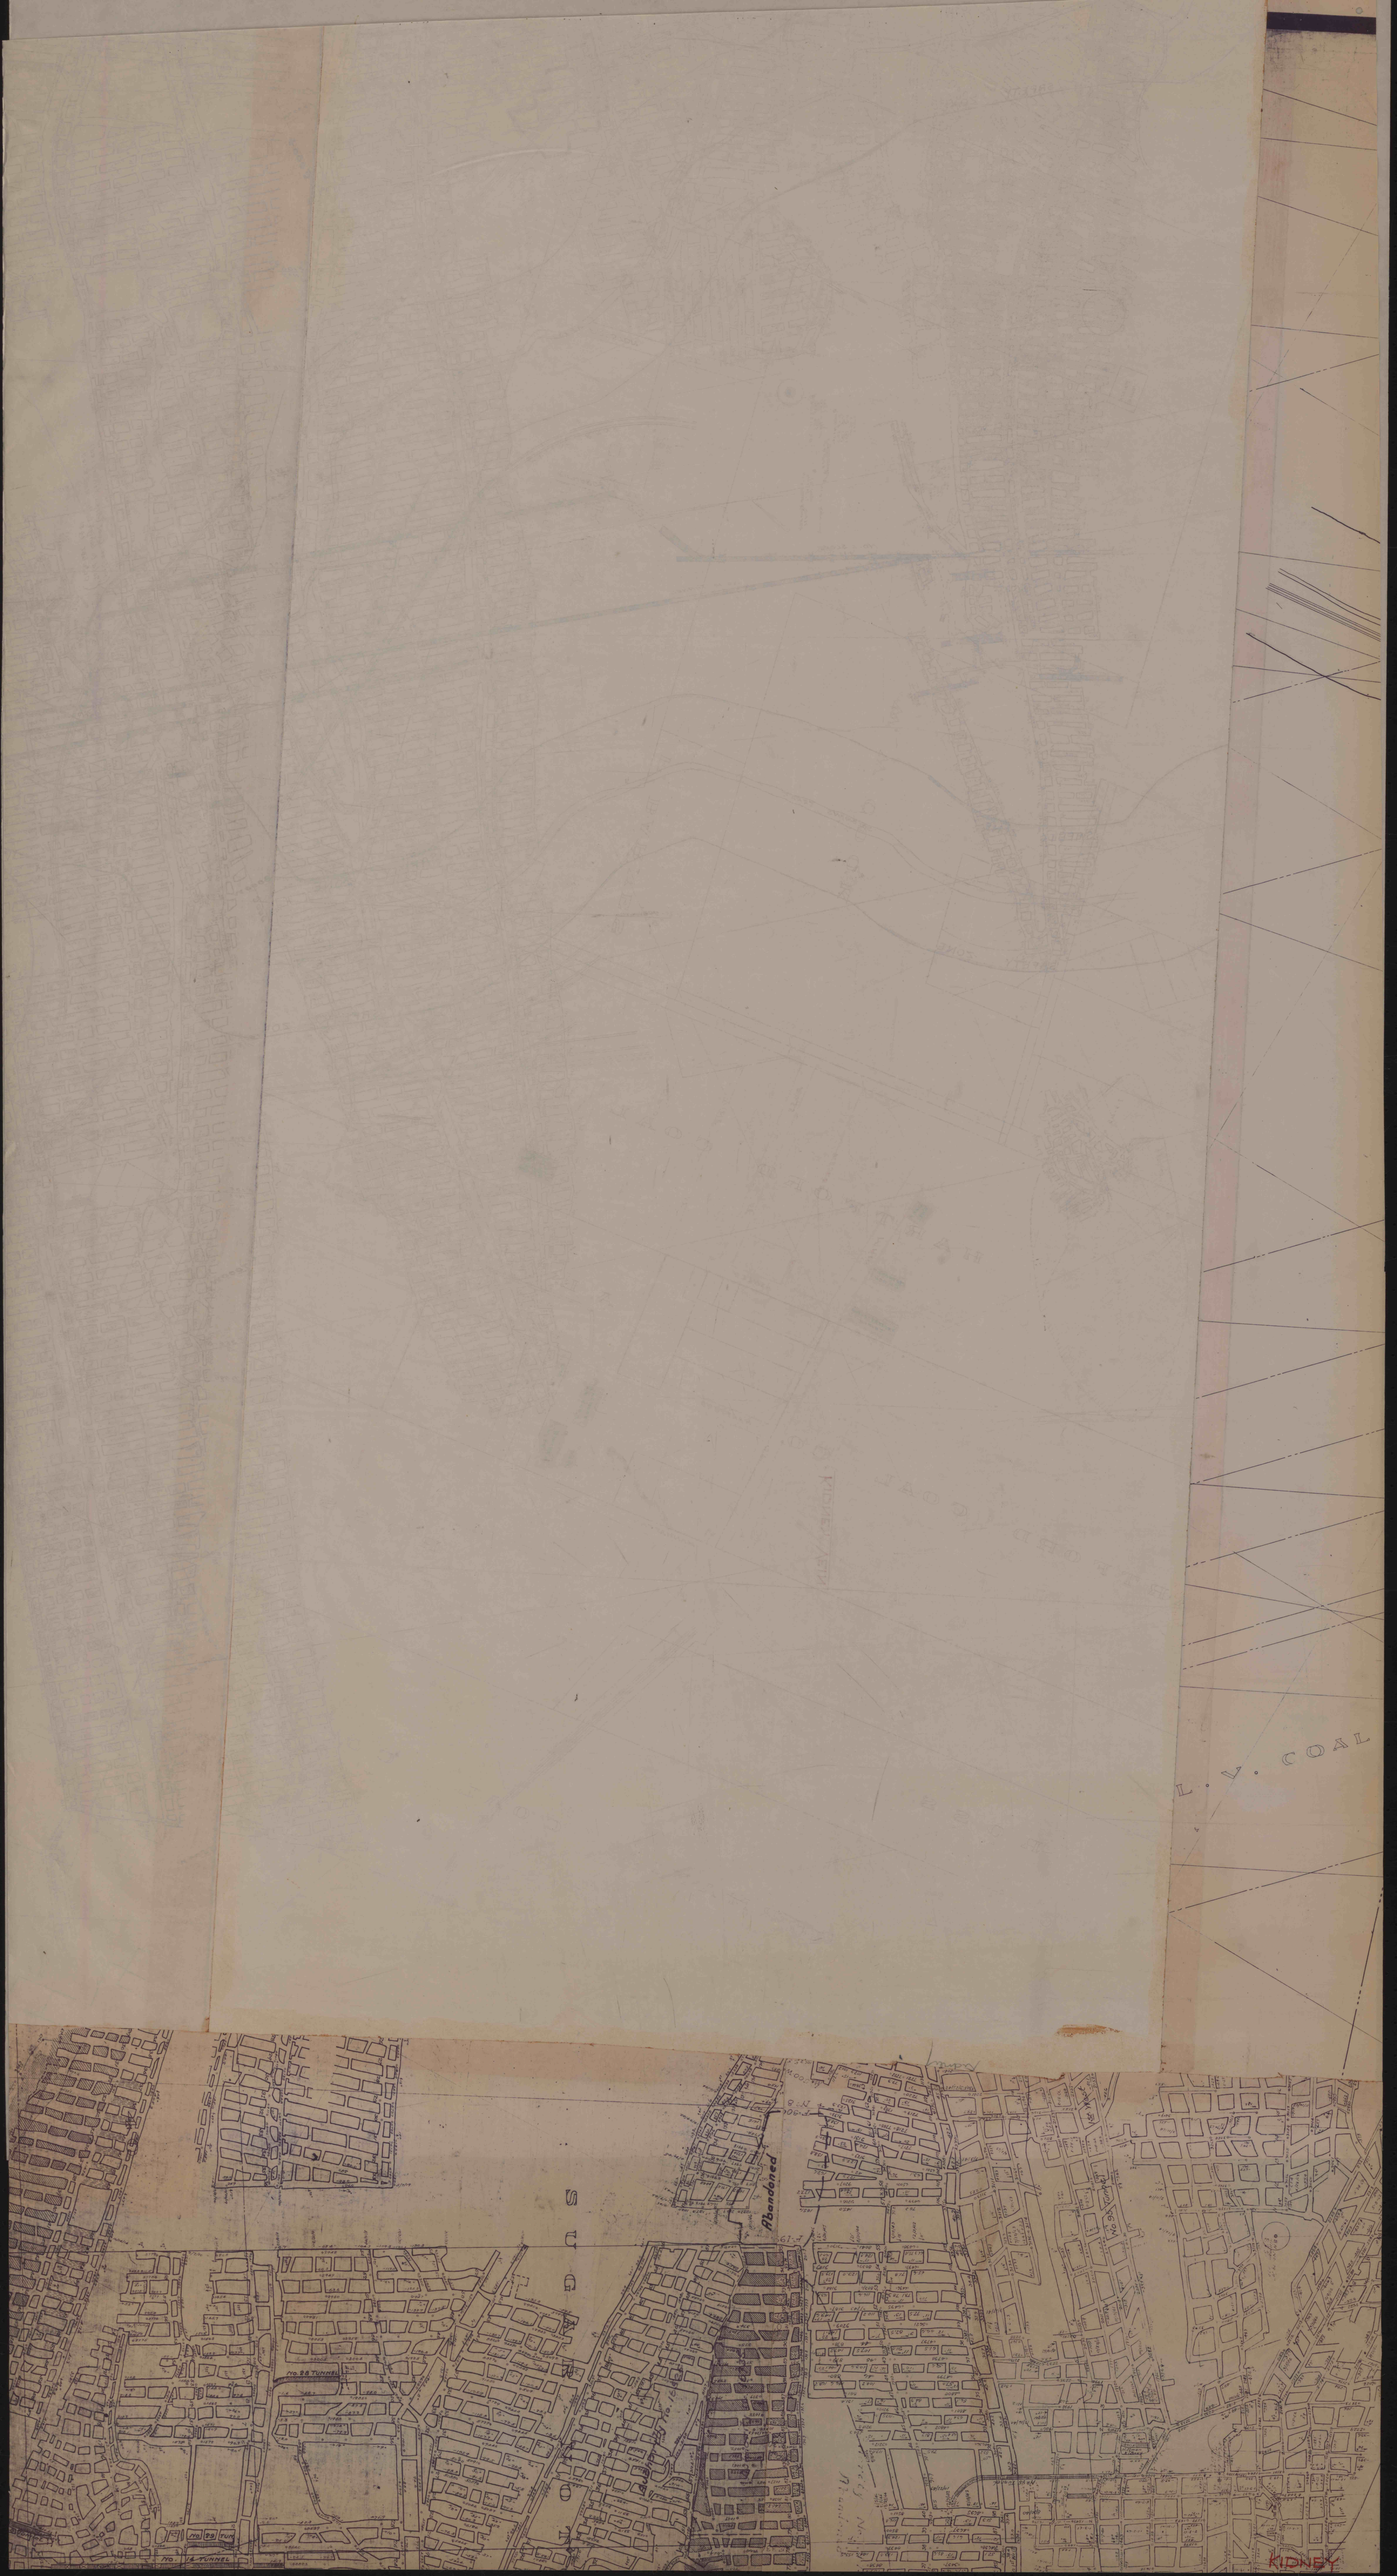
L. V. COAL
Abandoned
No. 98 TUNNEL
No. 114 TUNNEL
KIDNEY