


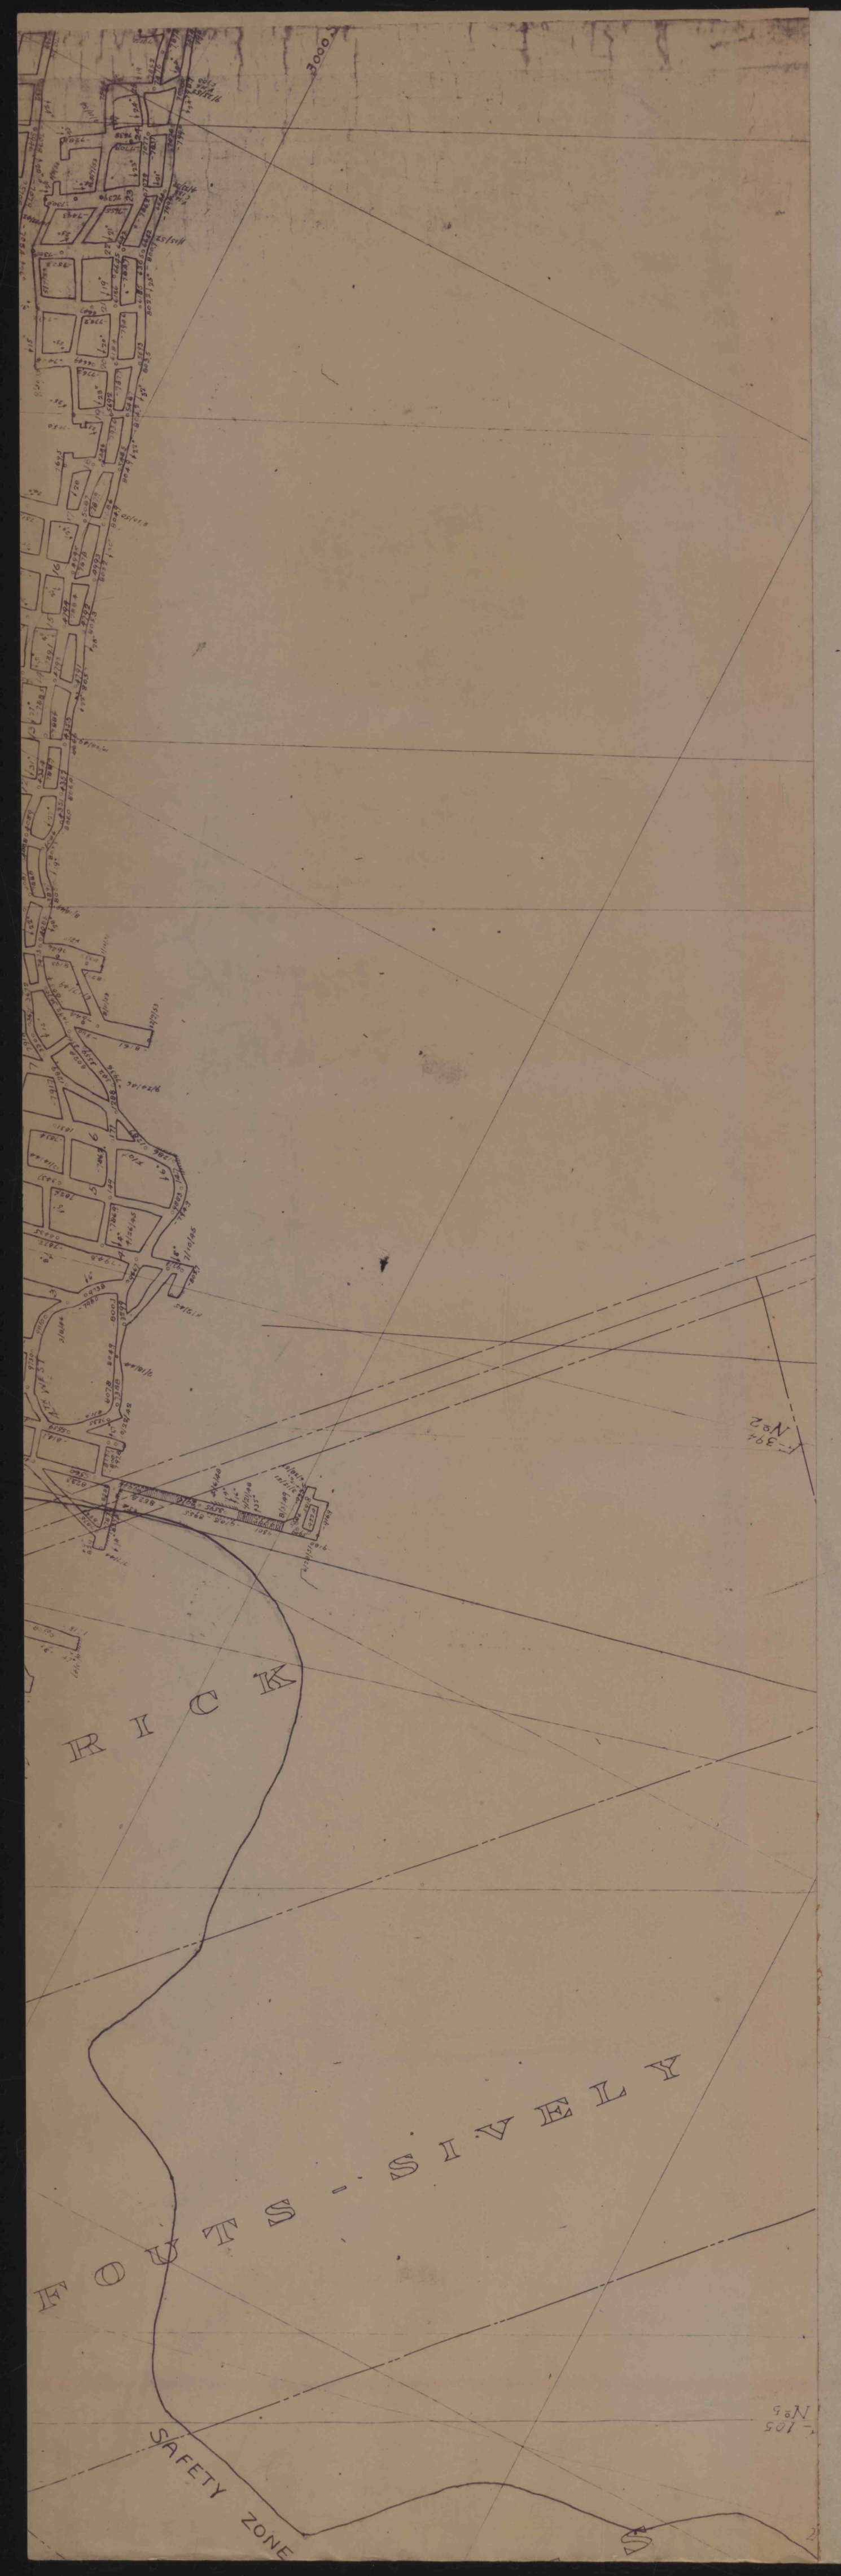

No 2
-394

No 5
-105