


WADHAM'S FIRST 360
GLYN ALDEN COAL CO
HUDSON COAL CO
BALTIMORE VEIN
LANCE - NOTTINGHAM

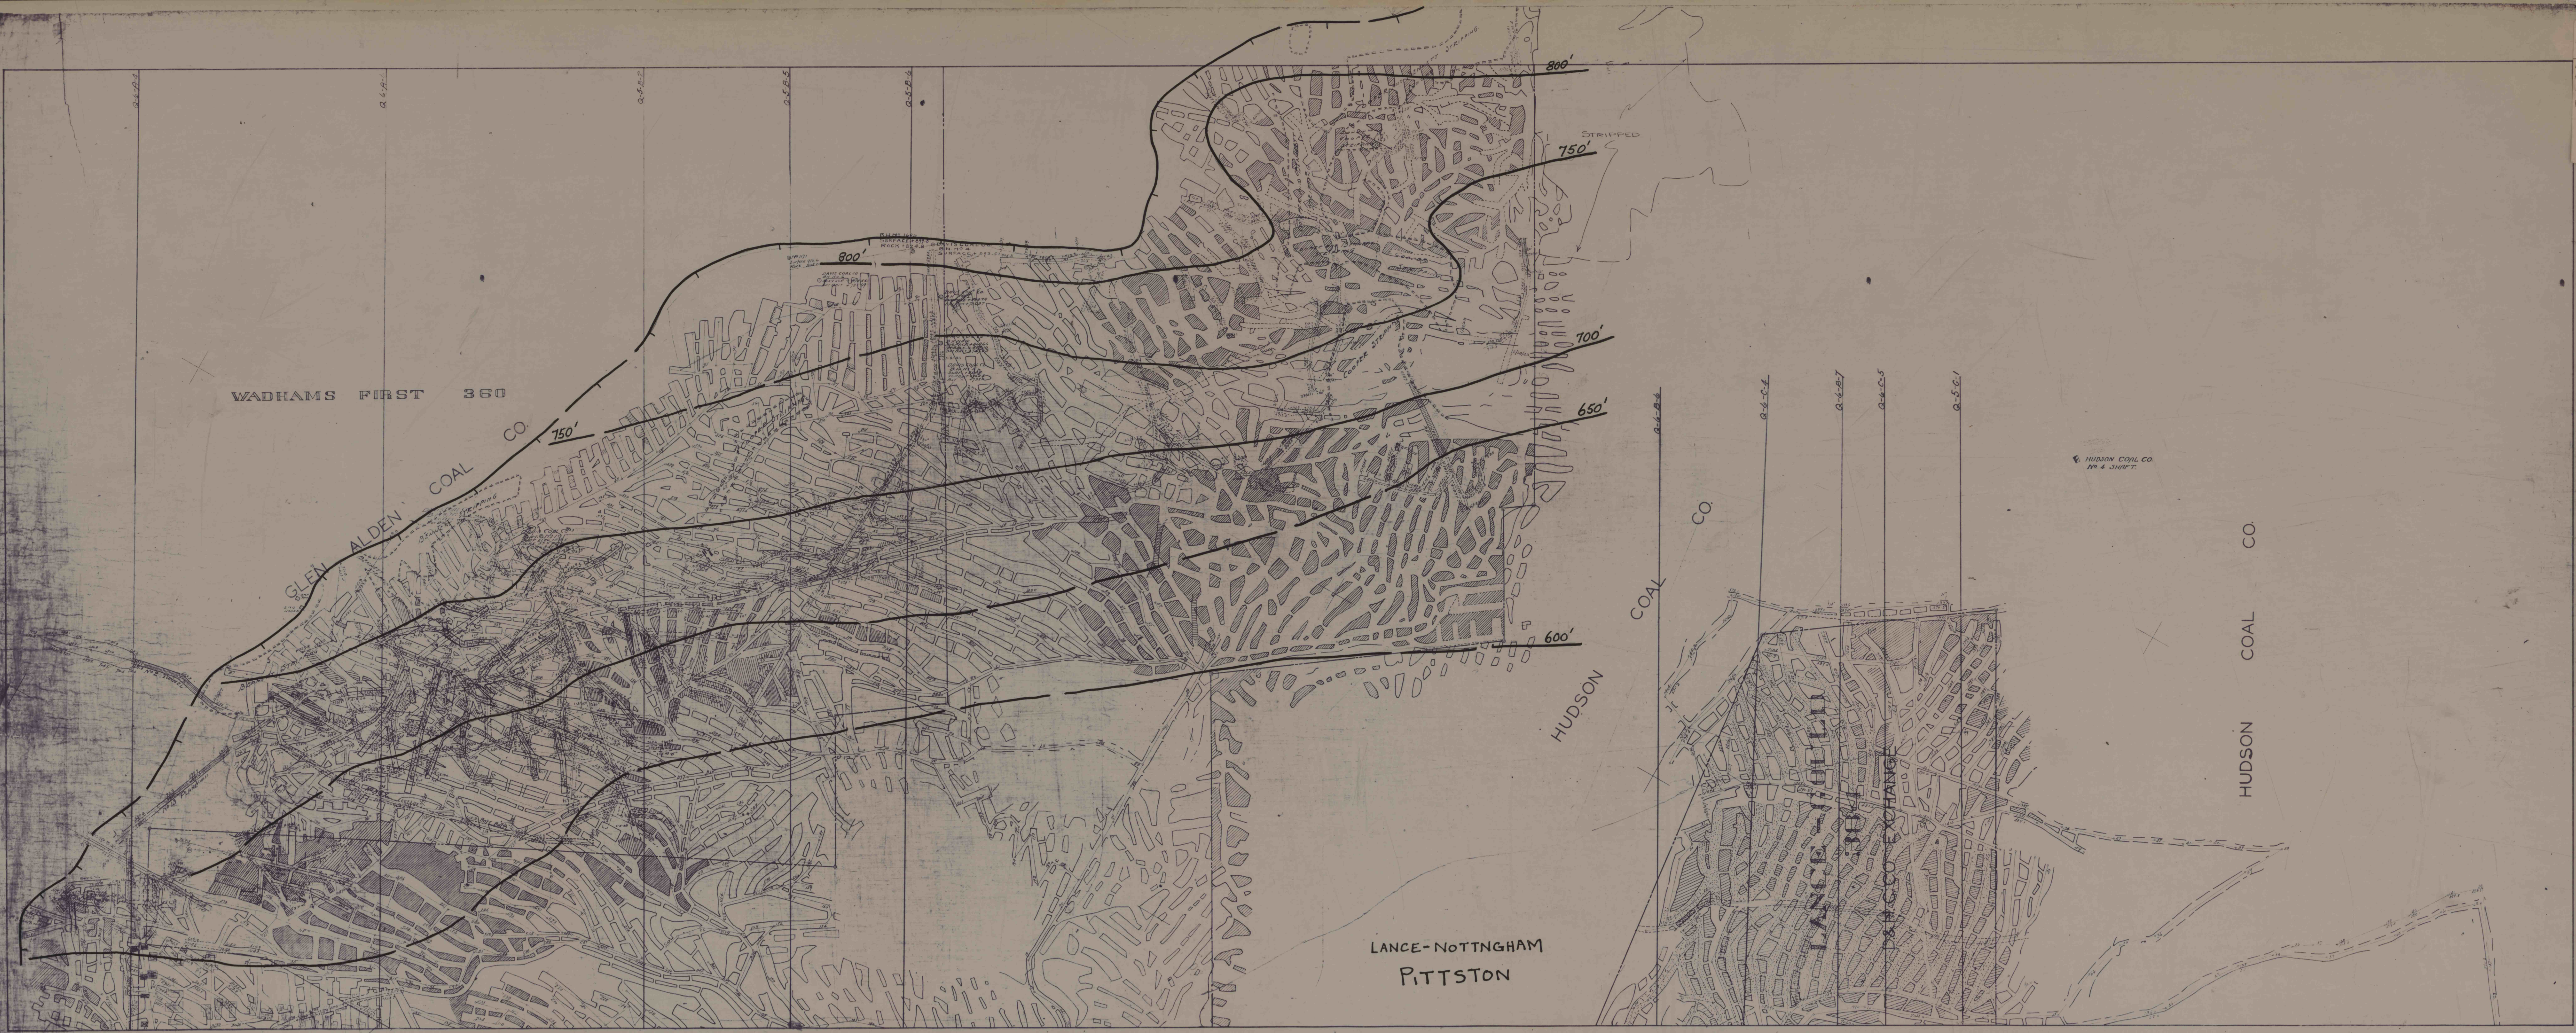

LANCE - NOTTINGHAM
BALTIMORE VEIN

LANCE - Nottingham
Lance County
Pittston Twp
Northern Field
1" = 100'
4908