



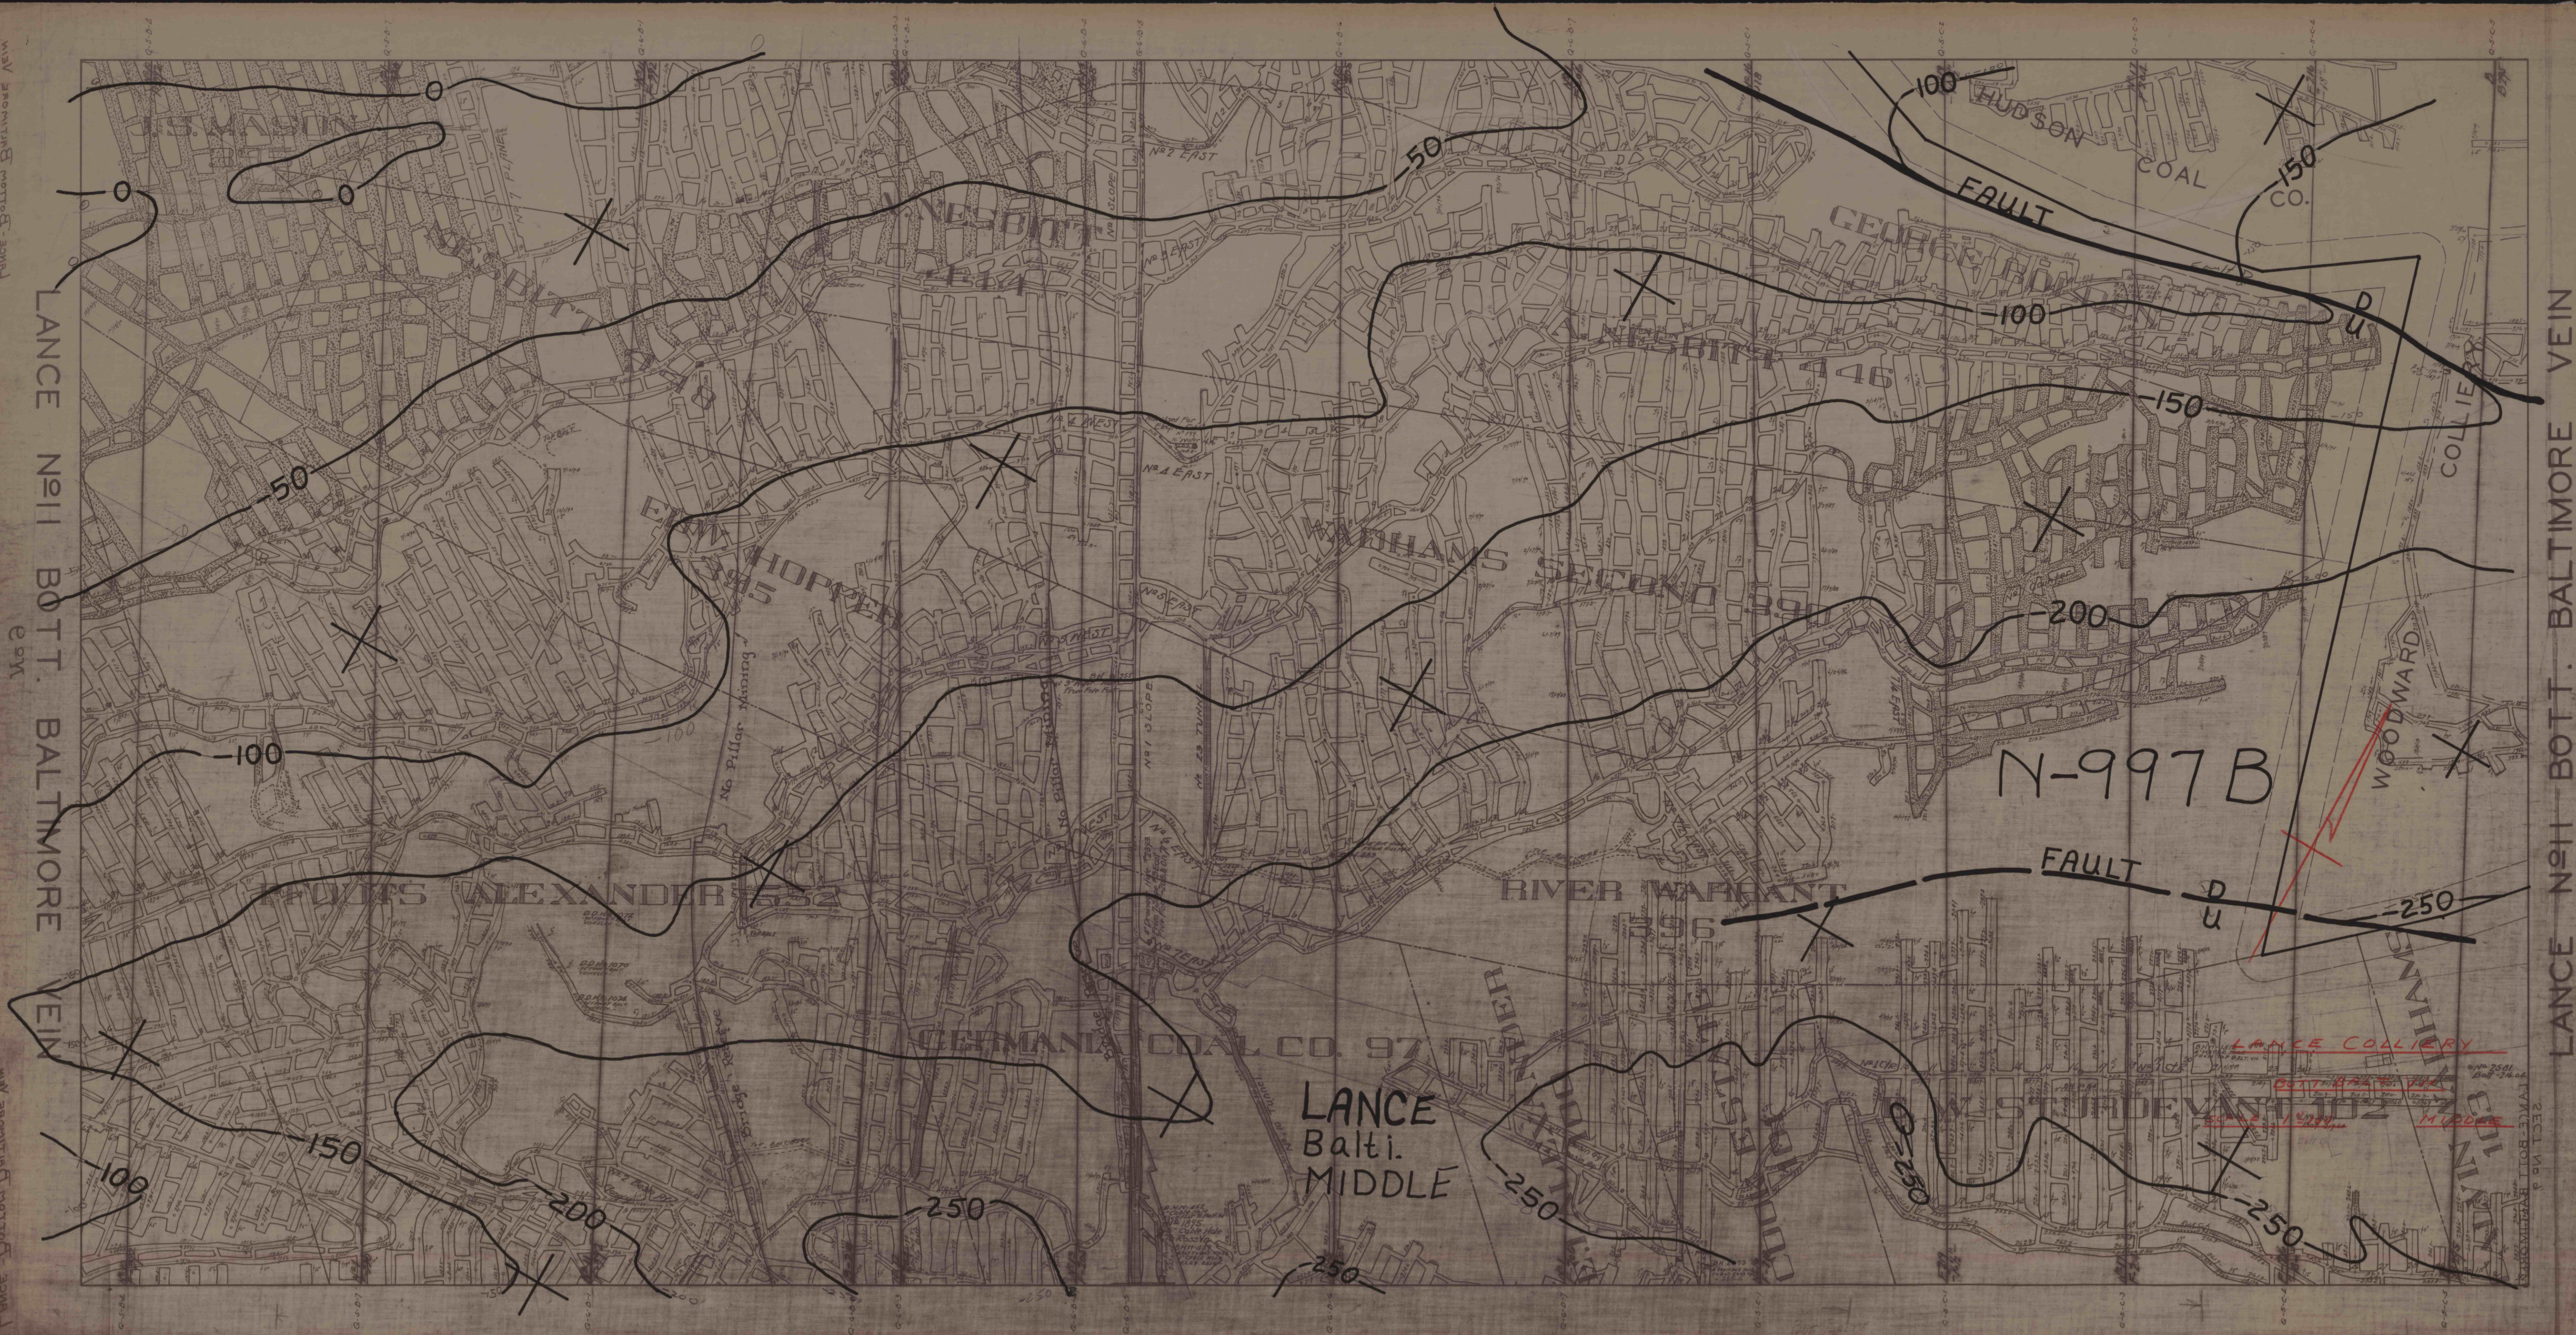

LANCE NO.11 BOTT. BALTIMORE VEIN