


WILLIAMS COAL CO'S
COLLIERY

NEAR POTTEVILLE PA

SCALE 100 FEET

D. F. HUGHES ENGINEER WILKES BARRE PA

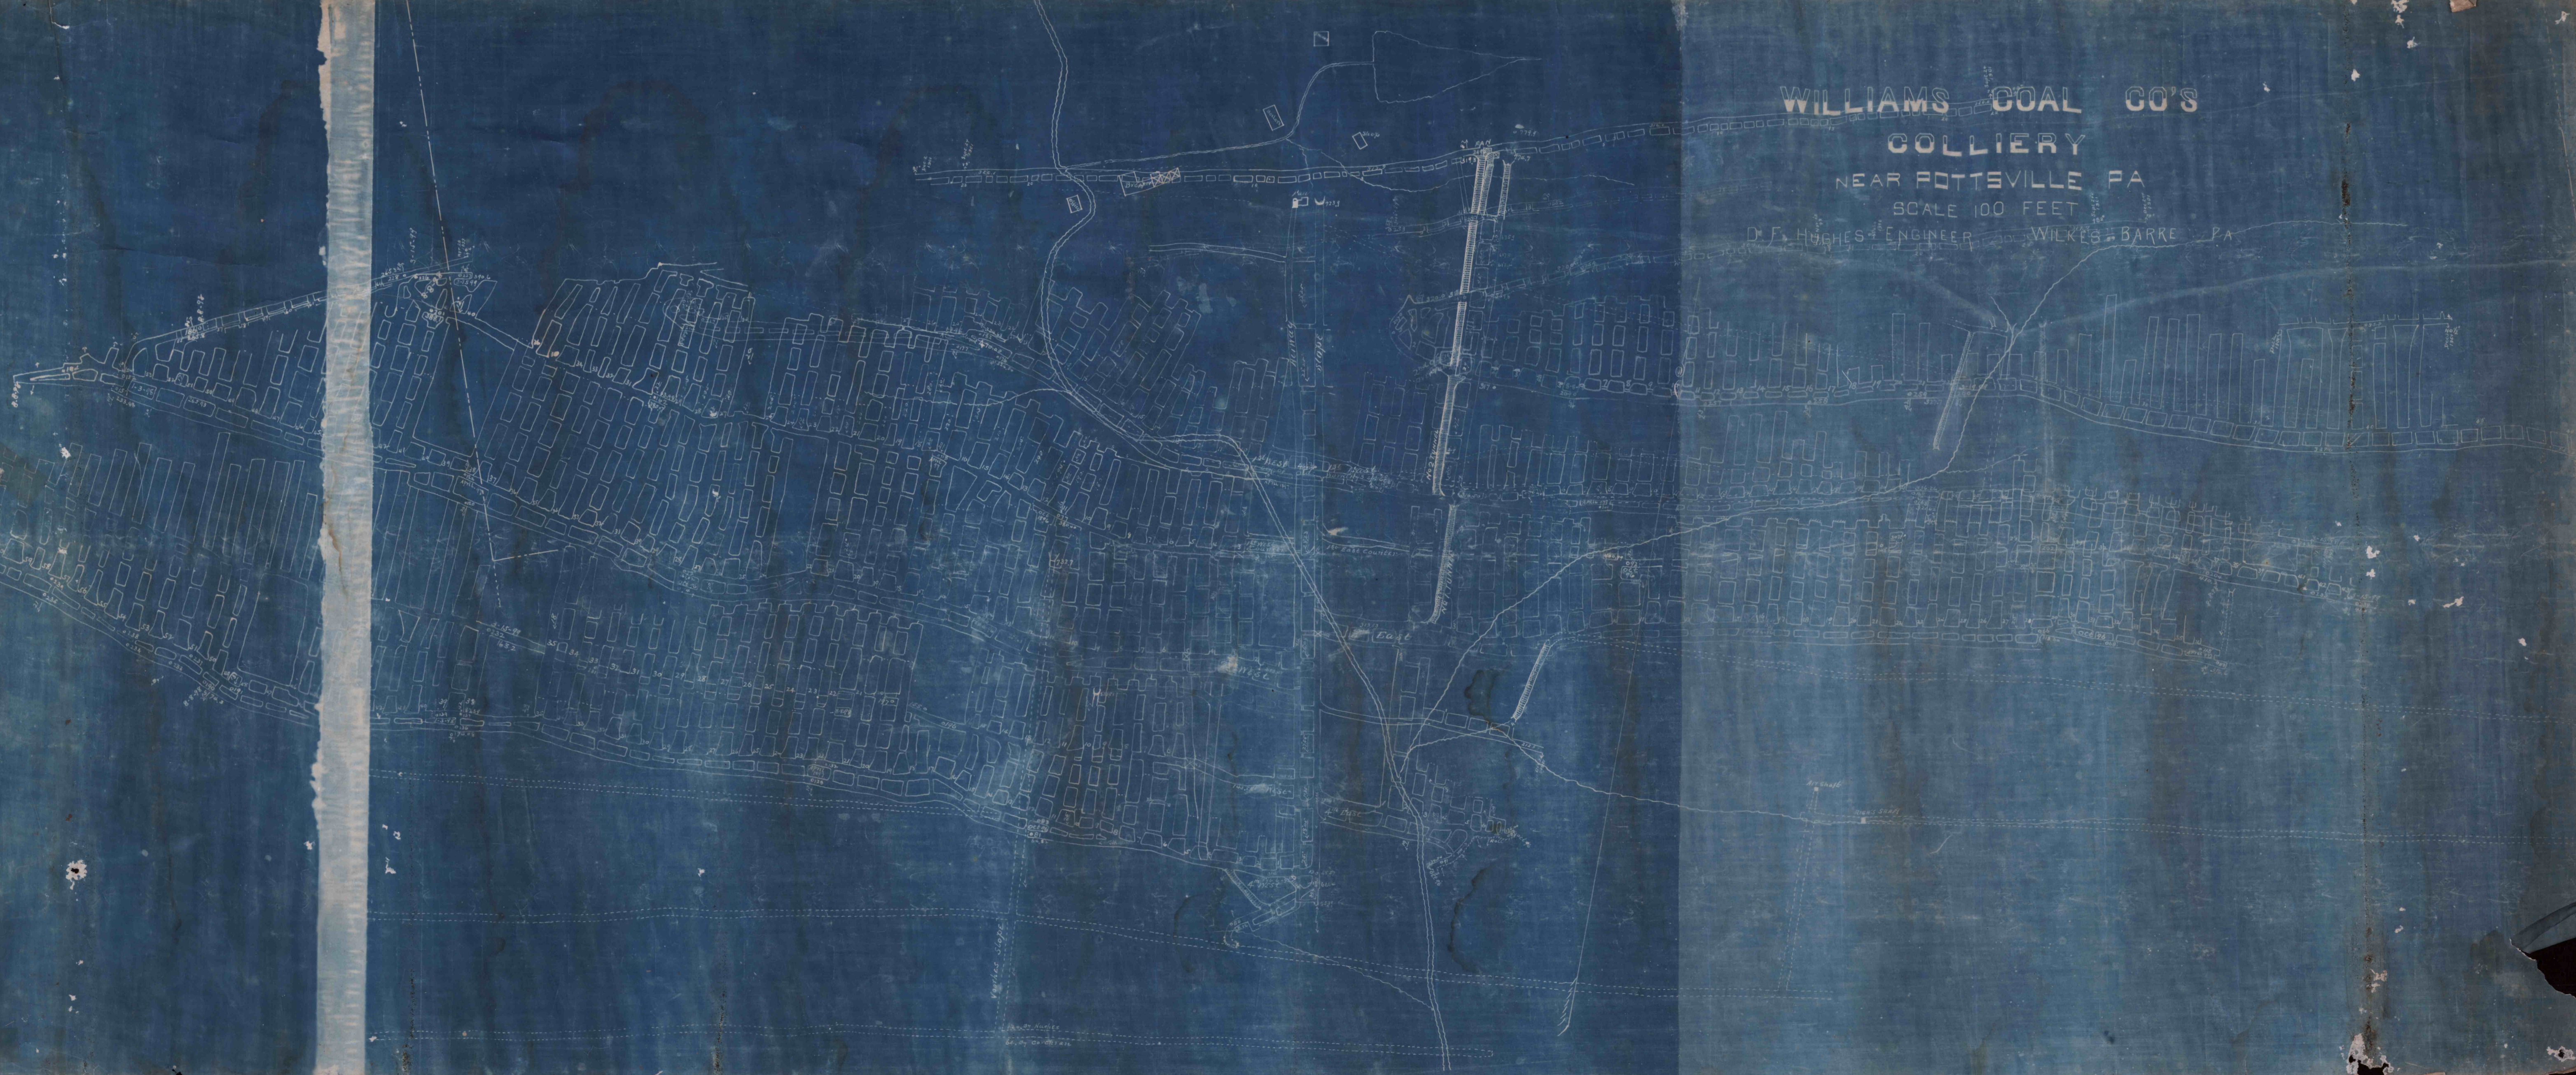

