



Alliance Colliery
 Schuylkill County
 Section 293
 May 19, 1932

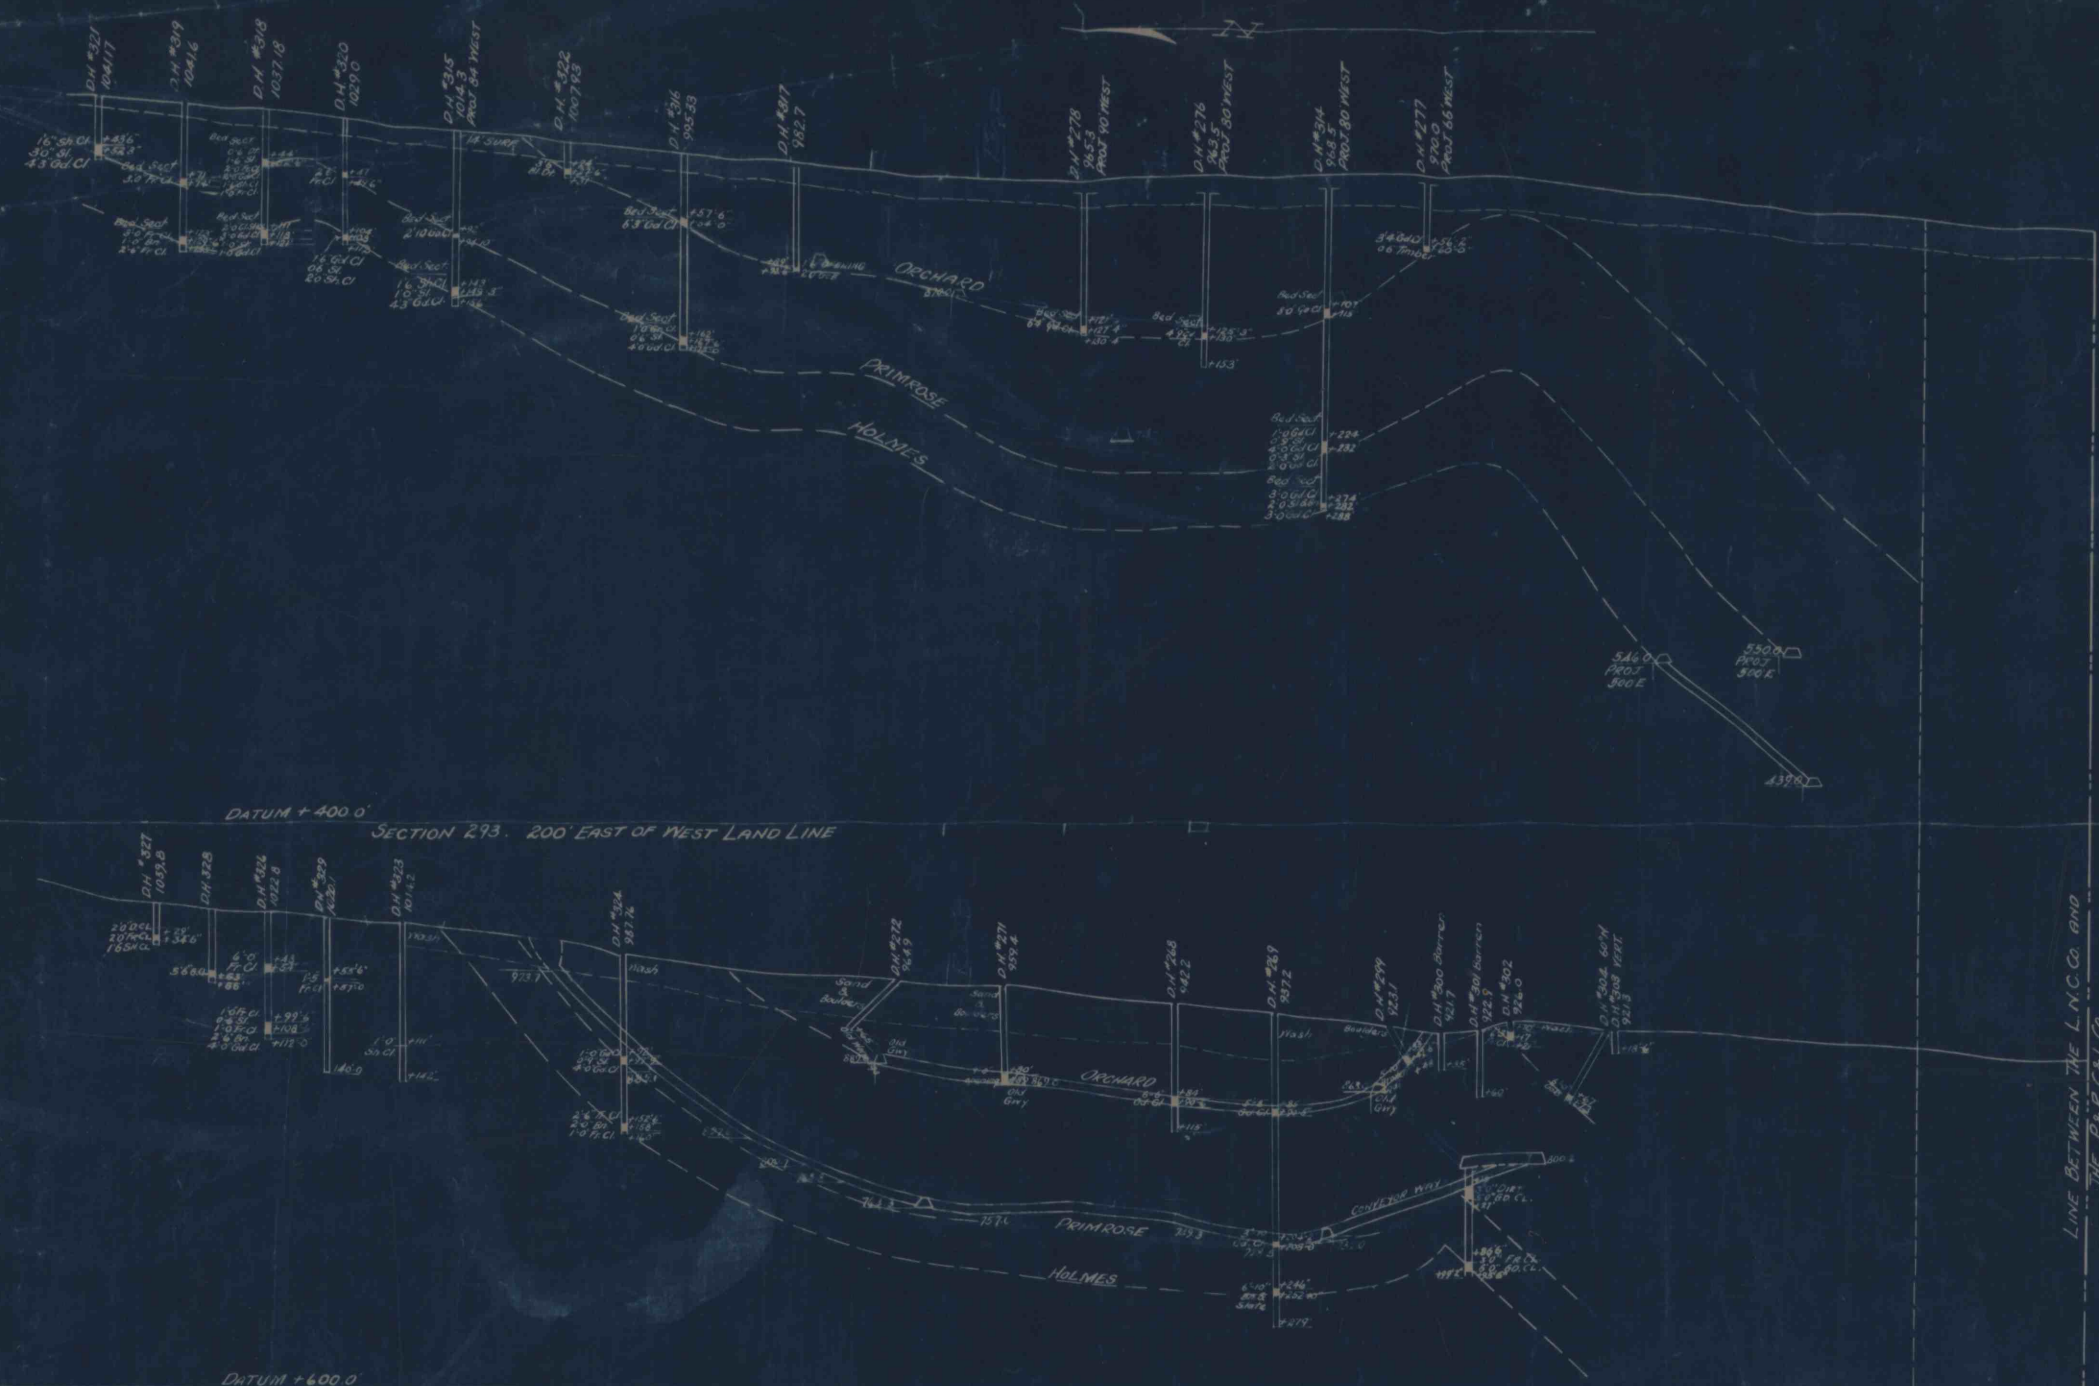

P.R. C. & I. CO.

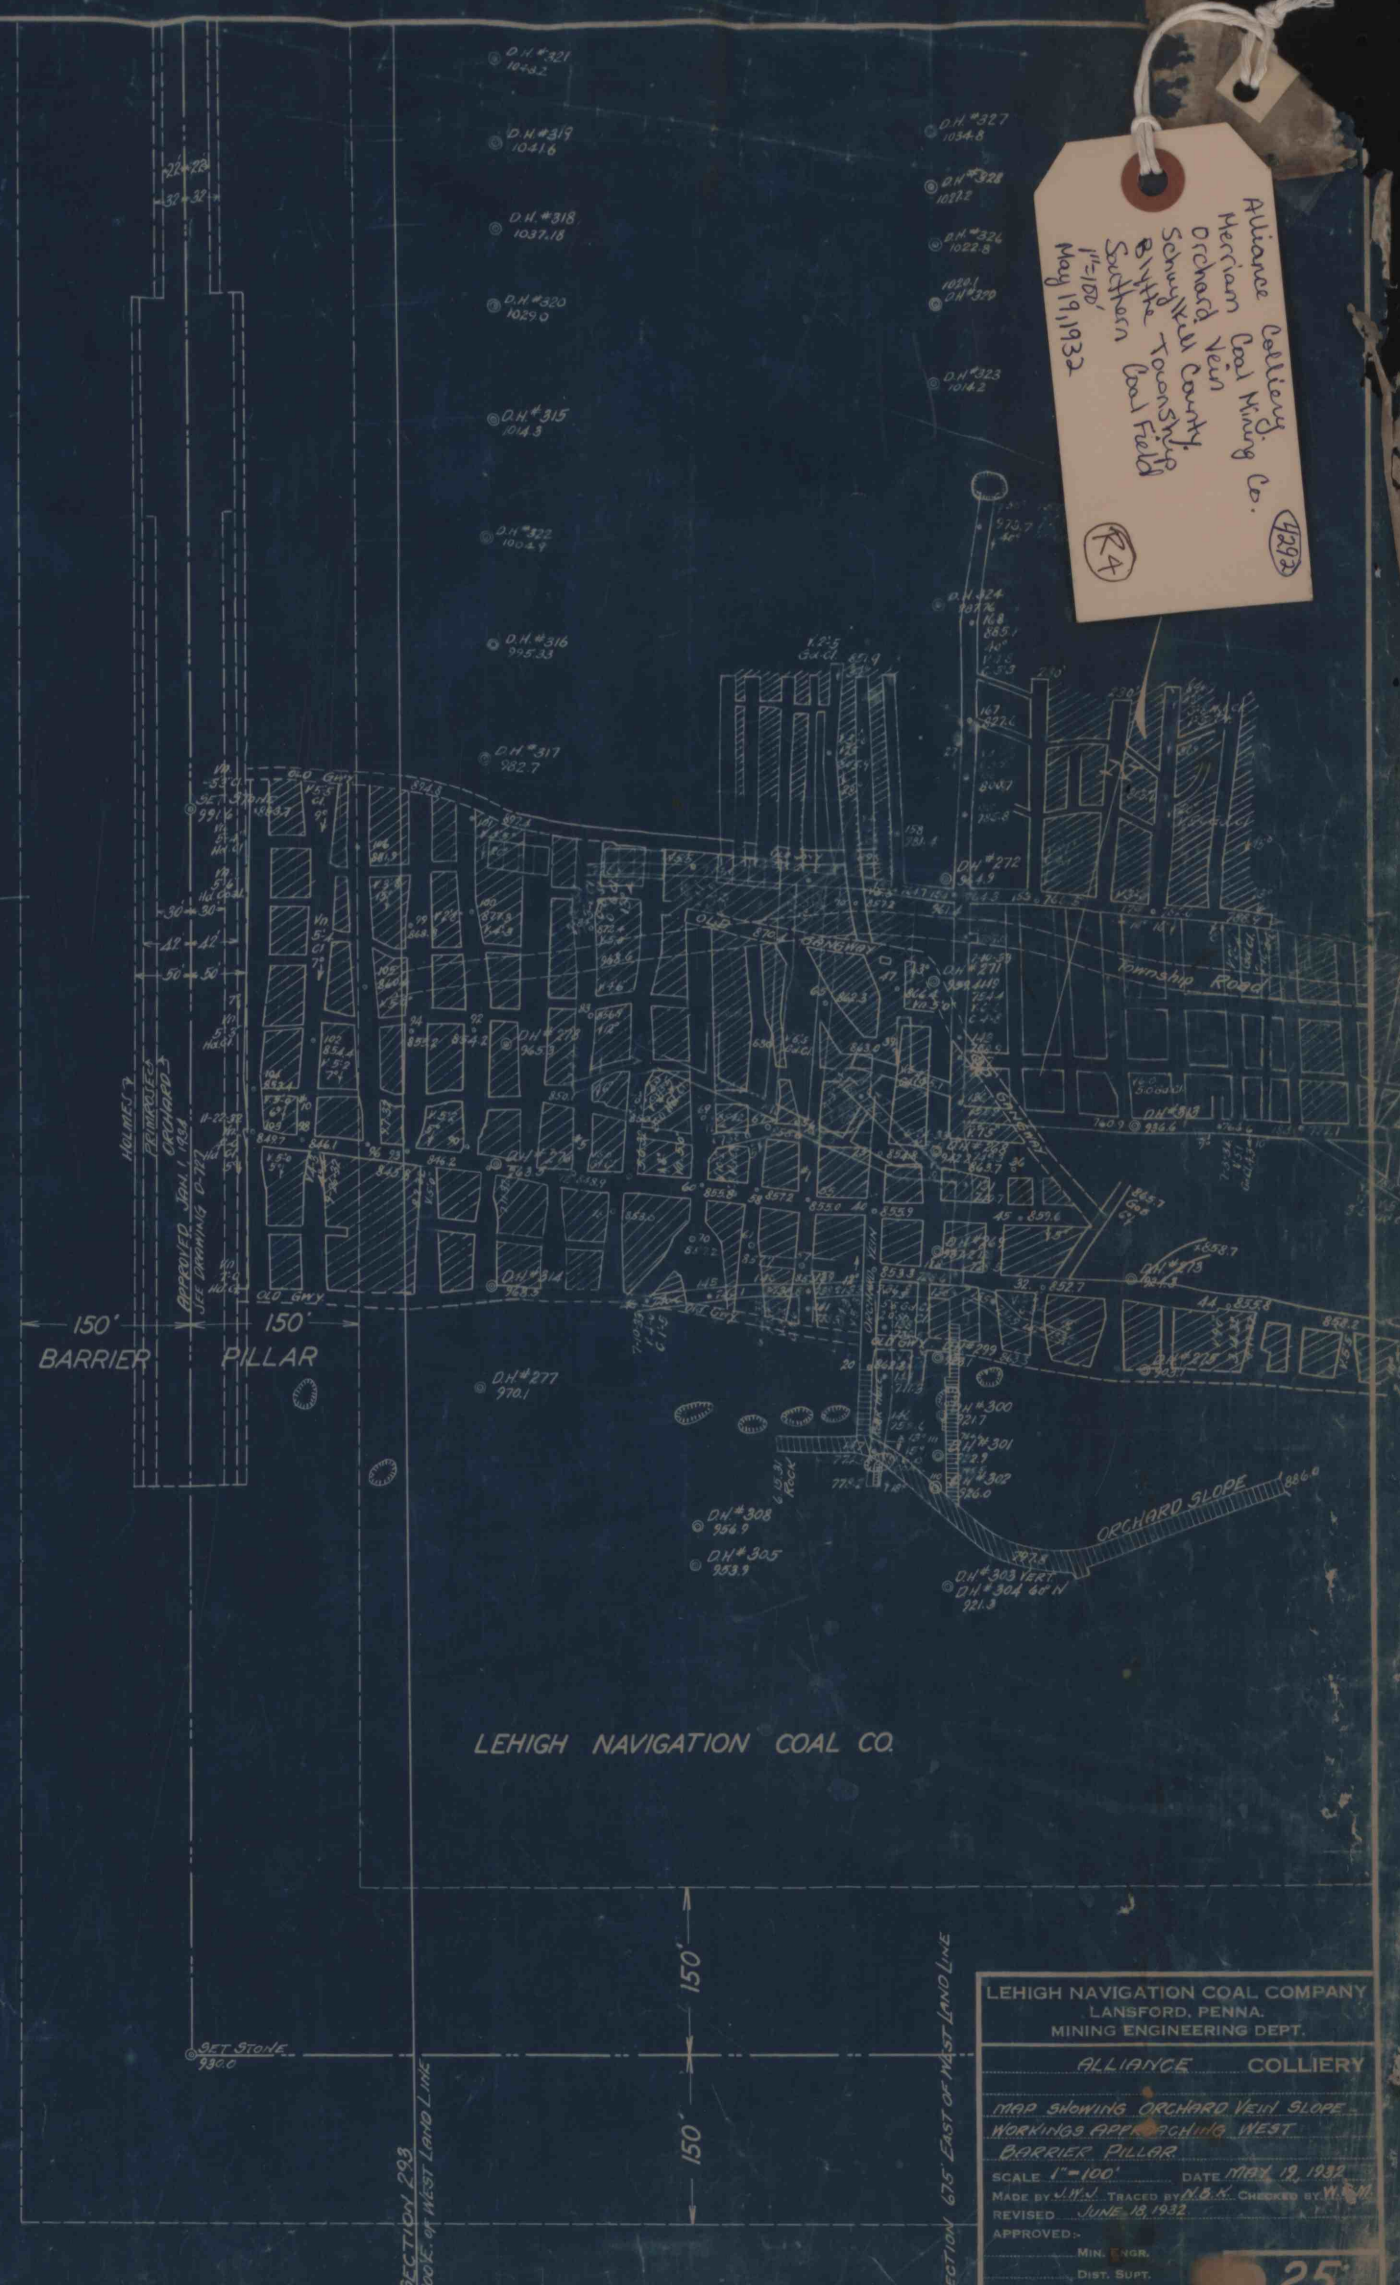

LEHIGH NAVIGATION COAL COMPANY	
MINING ENGINEERING DEPT.	
ALLIANCE	COLLIERY
BARRIER PILLAR	
APPROVED	
MIN. ENGR.	
DIST. SUPT.	
GENL. SUPT.	