Porter Tunnel
Skidmore Vein
Schuylkill County
Rush Township
Southern Coal Field

4300

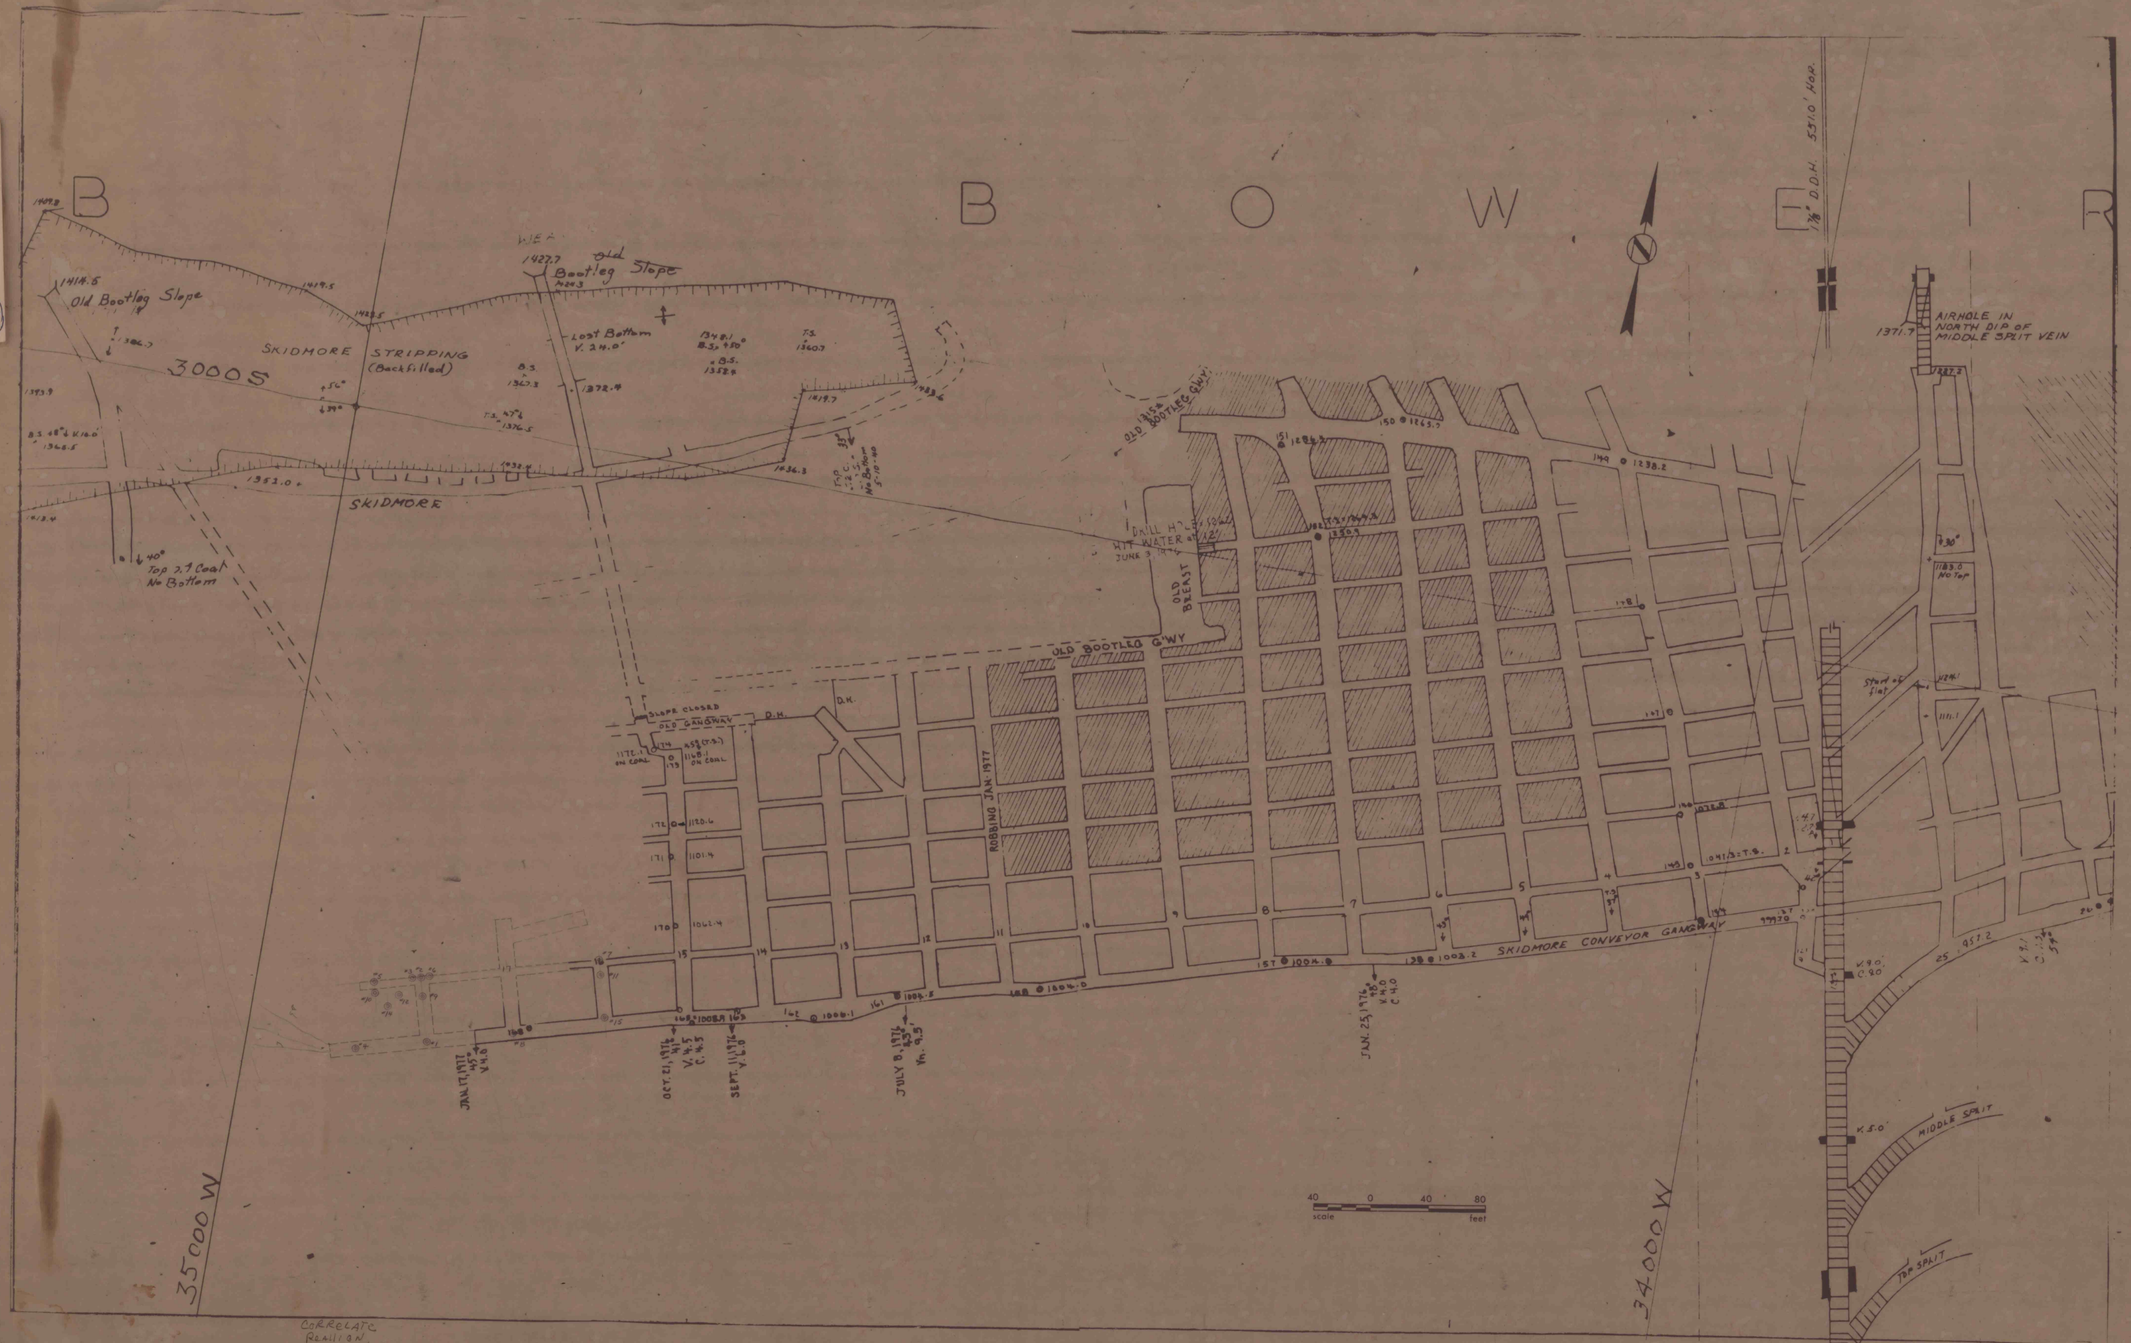

CORRELATE
REALIGN.