


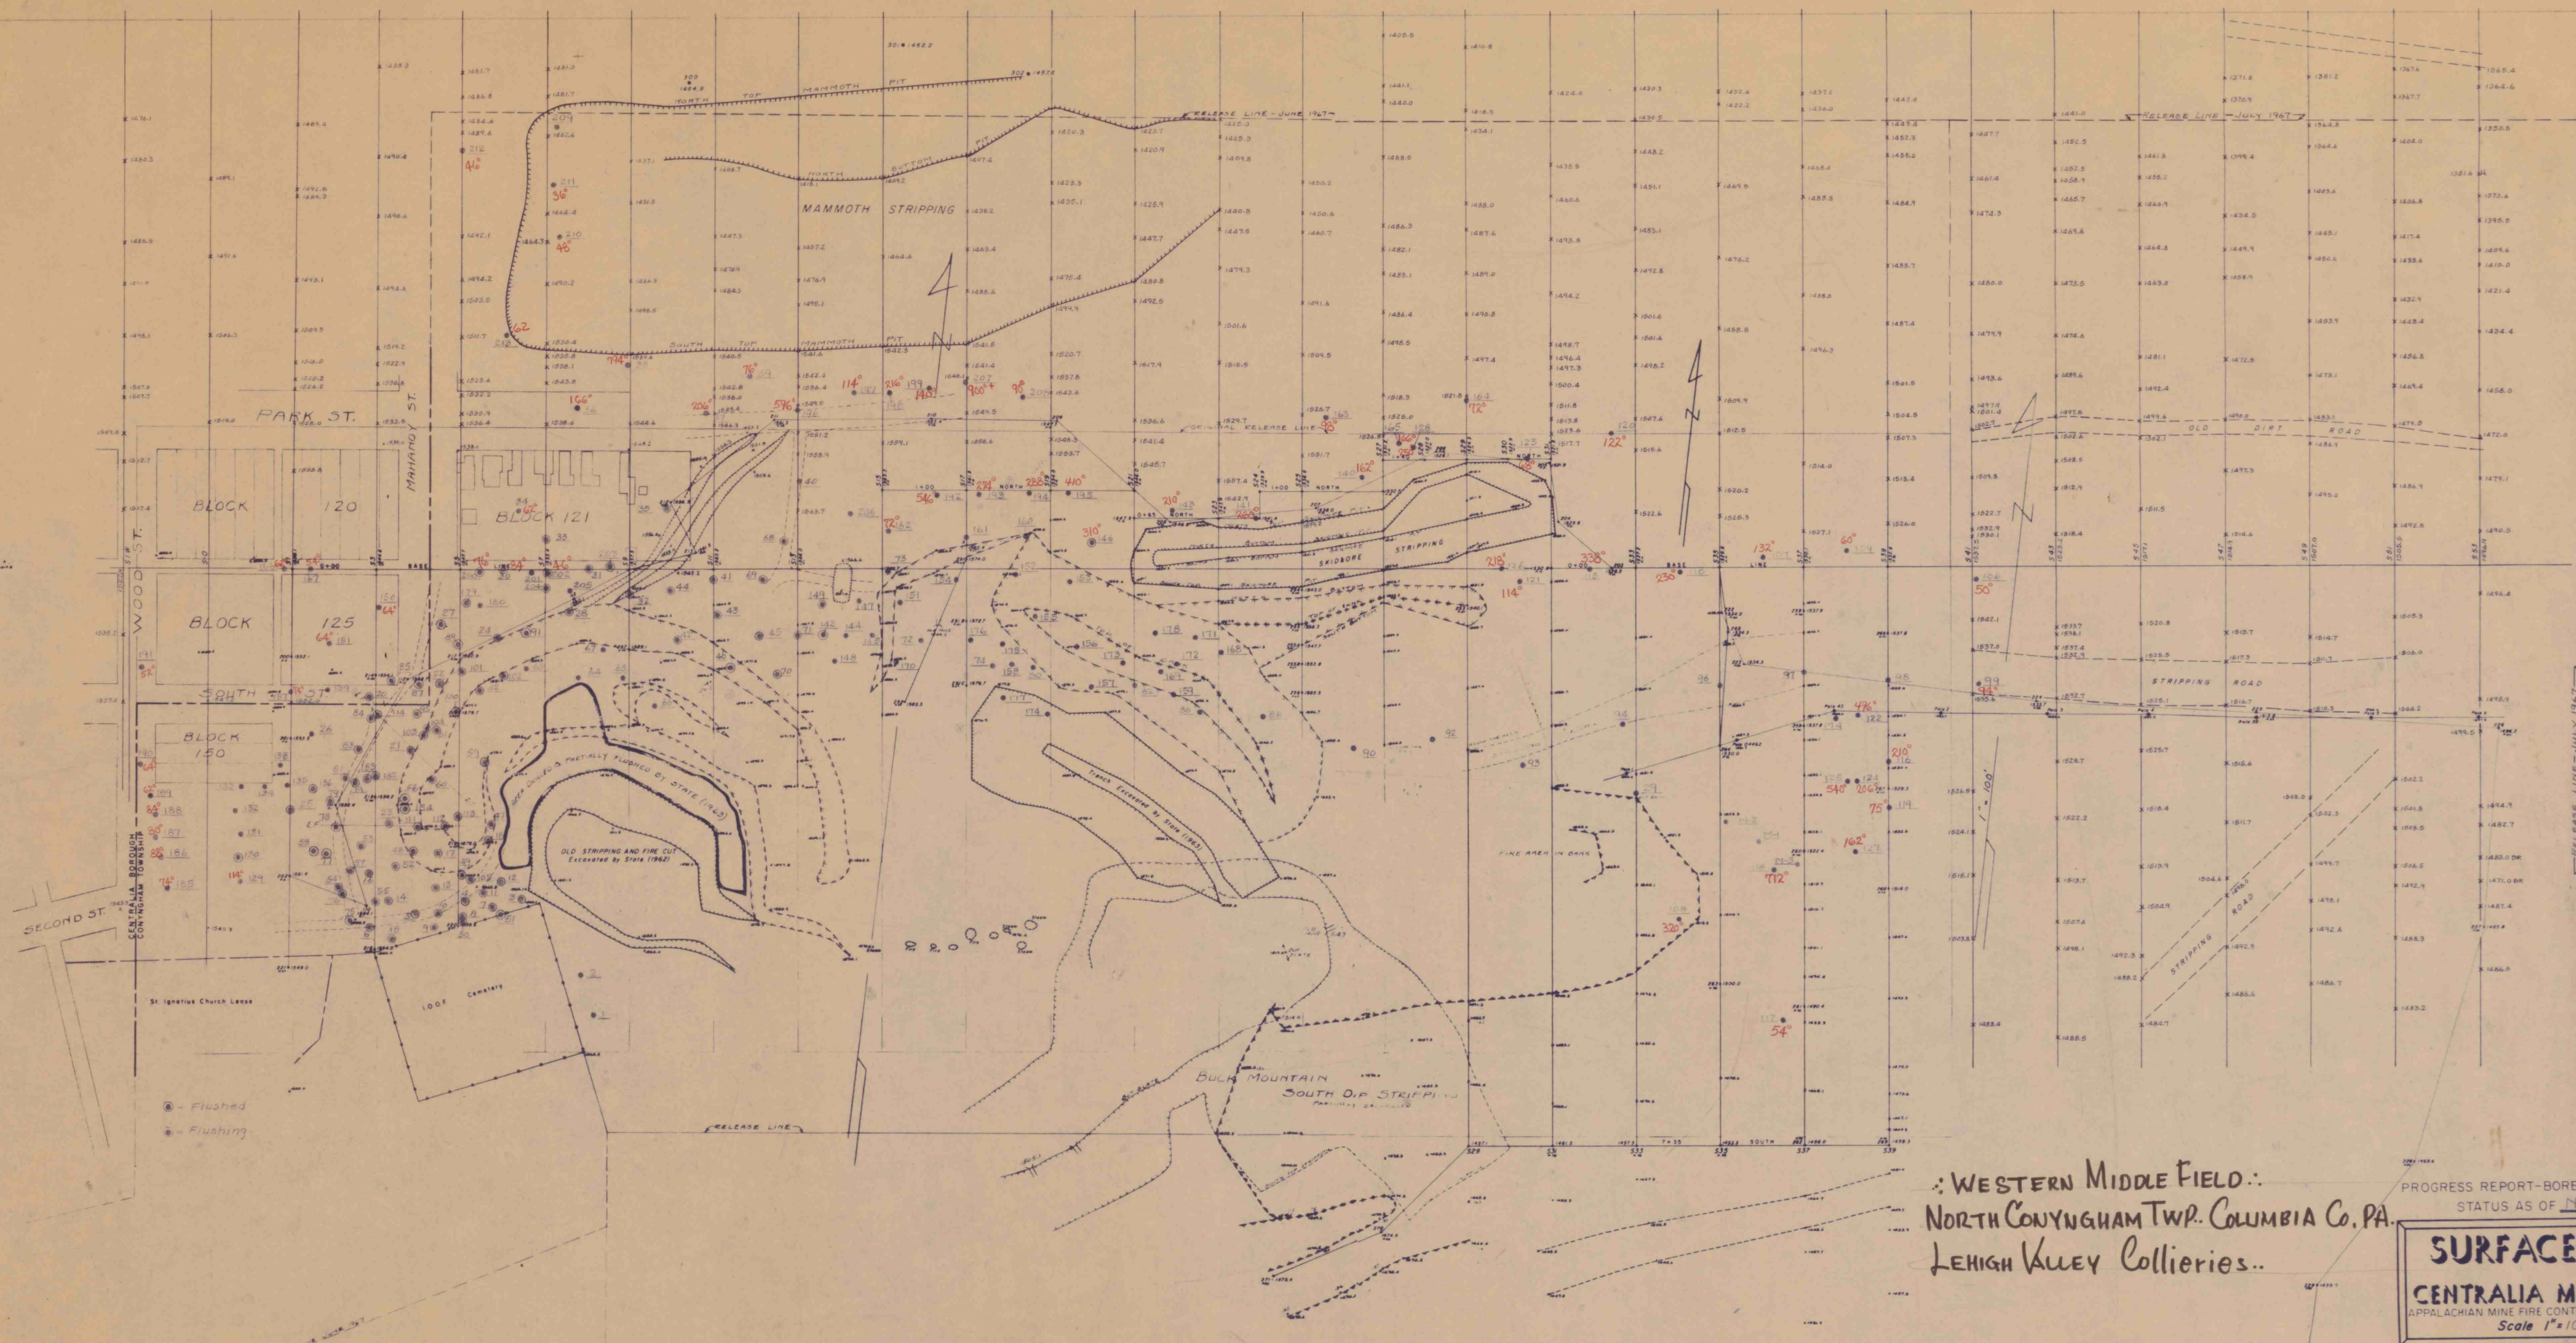

WESTERN MIDDLE FIELD:
NORTH CONYNGHAM TWP. COLUMBIA CO. PA.
LEHIGH VALLEY Collieries..

PROGRESS REPORT-BOREHOLE LOCATIONS
STATUS AS OF NOV. 13, 1967
SURFACE MAP
CENTRALIA MINE FIRE
APPALACHIAN MINE FIRE CONTROL PROJECT NO. 7
Scale 1"=100'

TEMP - NOV 20, 1967

20F2.