


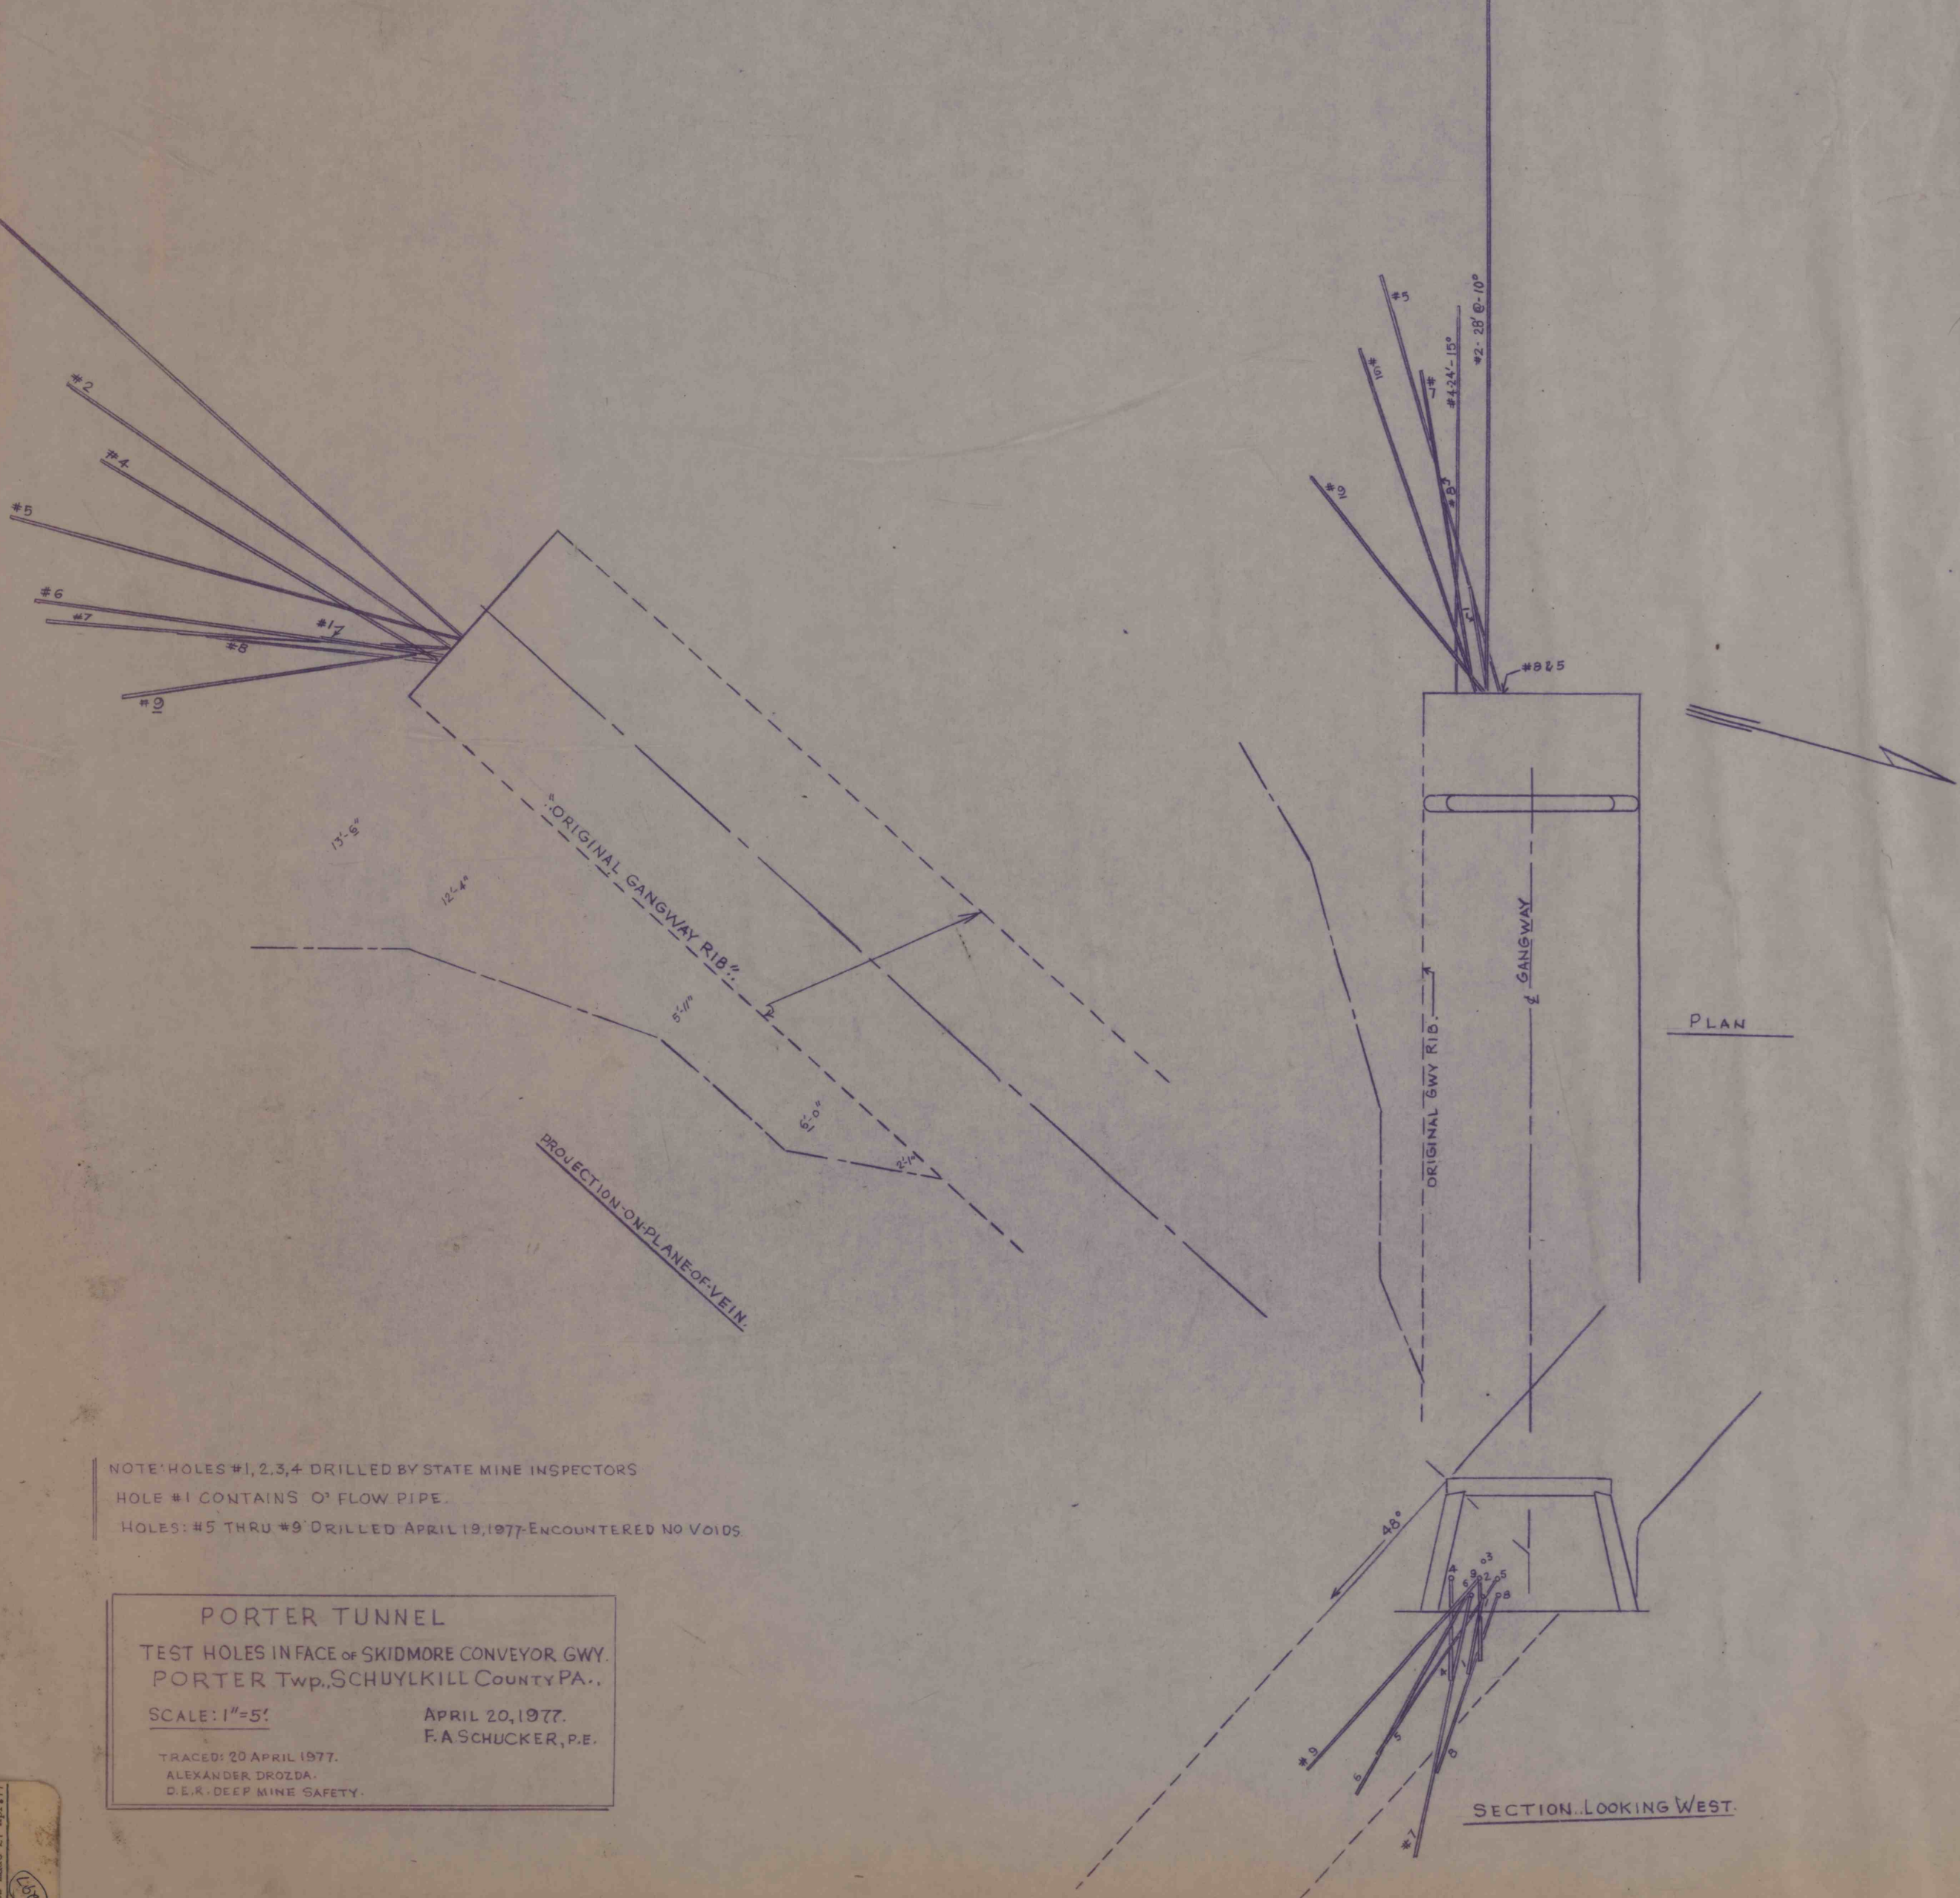

NOTE: HOLES #1, 2, 3, 4 DRILLED BY STATE MINE INSPECTORS
 HOLE #1 CONTAINS O₂ FLOW PIPE.
 HOLES: #5 THRU #9 DRILLED APRIL 19, 1977-ENCOUNTERED NO VOIDS

PORTER TUNNEL
 TEST HOLES IN FACE OF SKIDMORE CONVEYOR GWY.
 PORTER TWP., SCHUYLKILL COUNTY PA.,
 SCALE: 1"=5'
 APRIL 20, 1977.
 F.A. SCHUCKER, P.E.
 TRACED: 20 APRIL 1977.
 ALEXANDER DROZDA.
 D.E.R. DEEP MINE SAFETY.

Southern Field #1-51
 REISS
 Tunnel... "P" at bore-hole
 in face of Skidmore
 Conveyor Gangway."
 Porter Twp., Schuylkill
 County Pa., 1100 ft. with
 1" print. 20 April 1977.
 (12-prints made 21 Apr. 77)