


Scale - One Inch equals 100 Feet

APR. 16, 1909.

1244

This Tracing is an exact copy of the new mounted map No. 1230. Jan. 26-1909. constructed from the original surveys, notes, examinations and observations from May 1896 to April 16th-1909. by H.W. Atthouse, Mining Engineer.

COPE-DRIFT WORKINGS

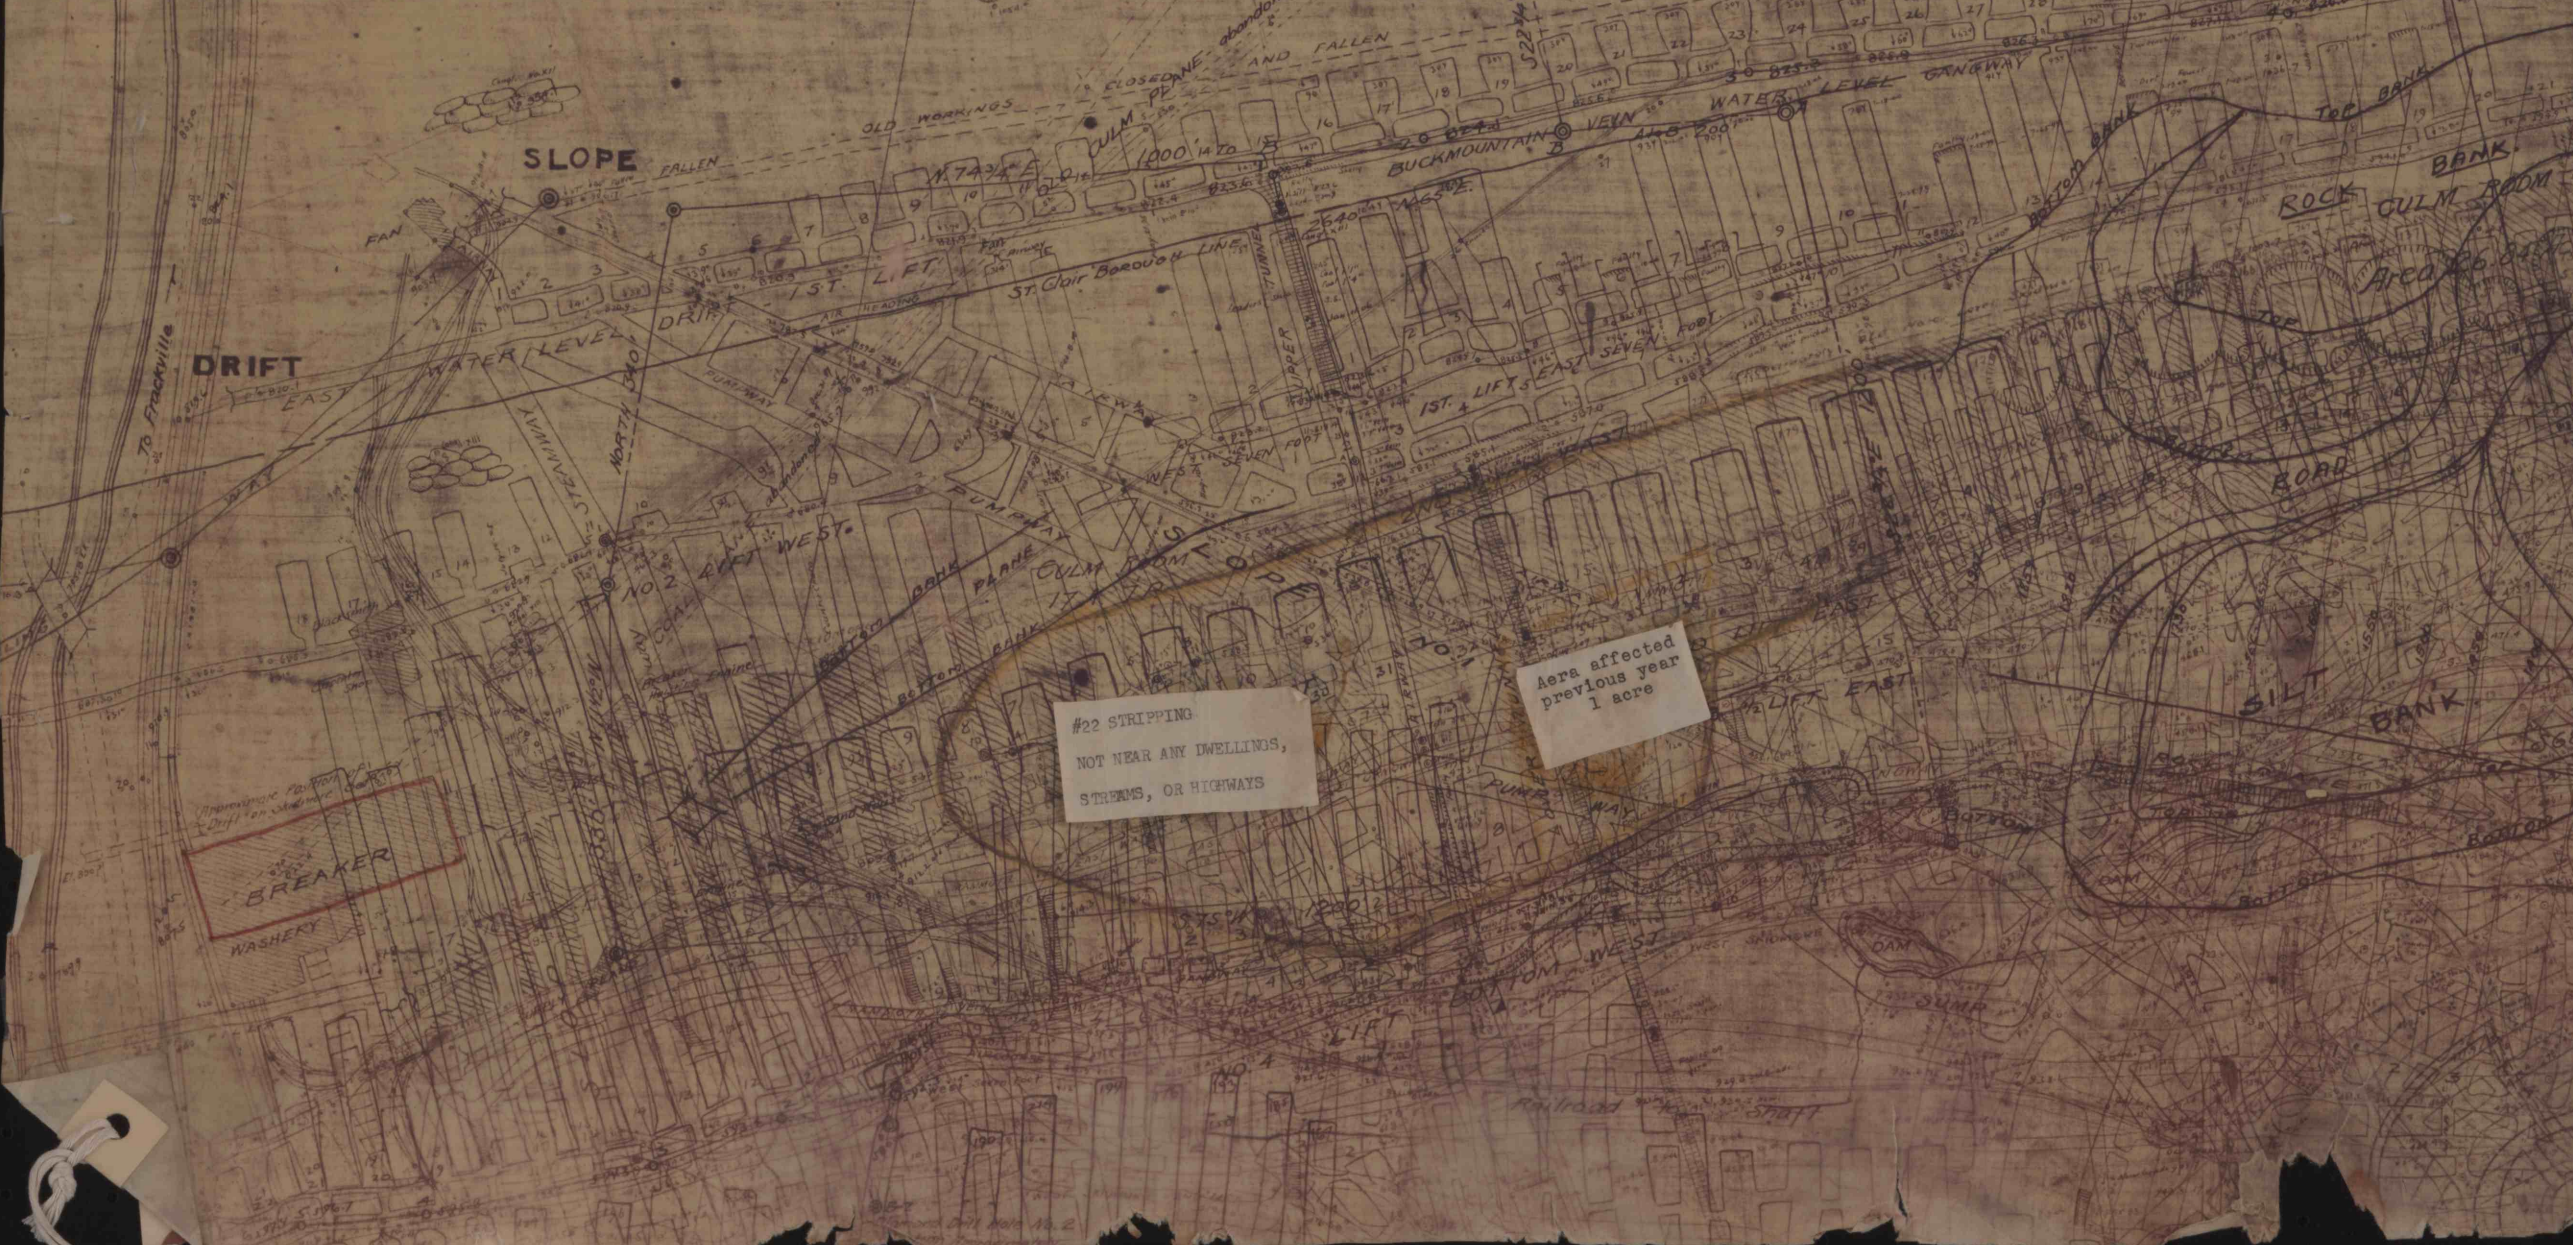

#22 STRIPPING
NOT NEAR ANY DWELLINGS,
STREAMS, OR HIGHWAYS

Area affected
previous year
1 acre

Surfaces
April 16, 1909
11-158

(4327)