


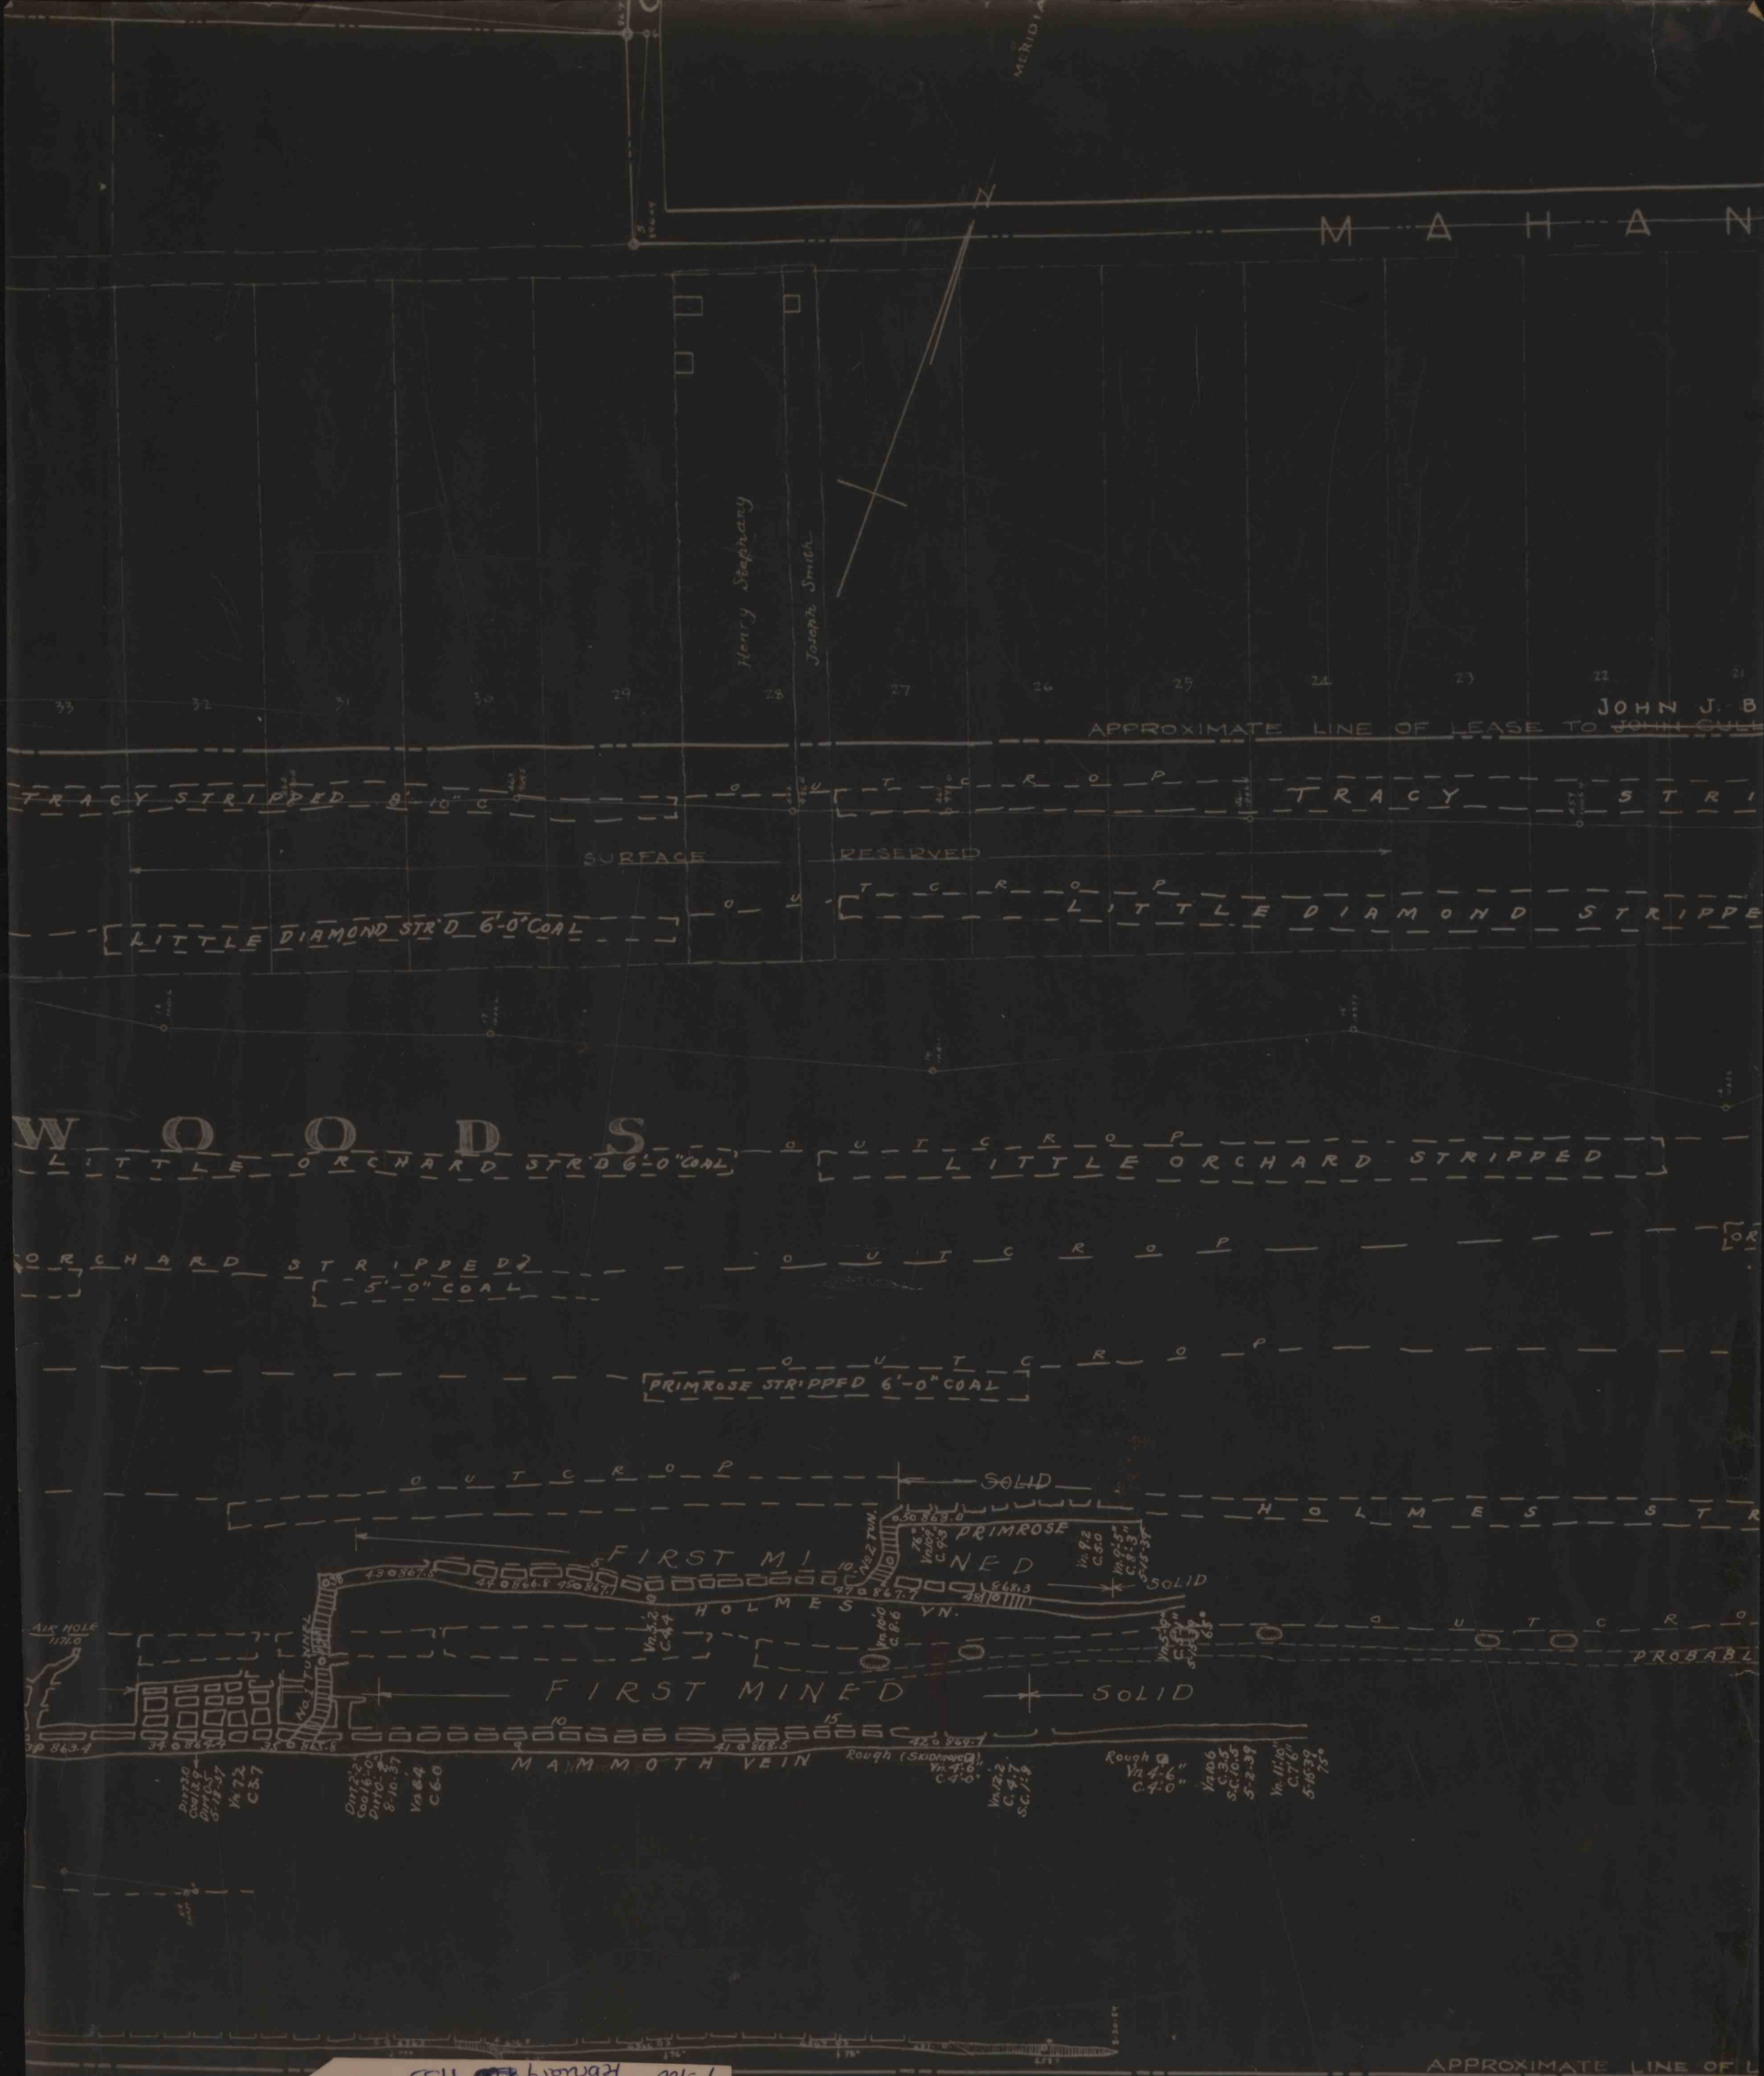

York Farm Colliery  
Lynch Valley Coal Company  
Woods Estate/Stripping  
Vanover Veins  
Schuykill County  
Norwegian Township  
Cress Section  
Southern Coal Field  
February 1935  
1/10/35

(4308)