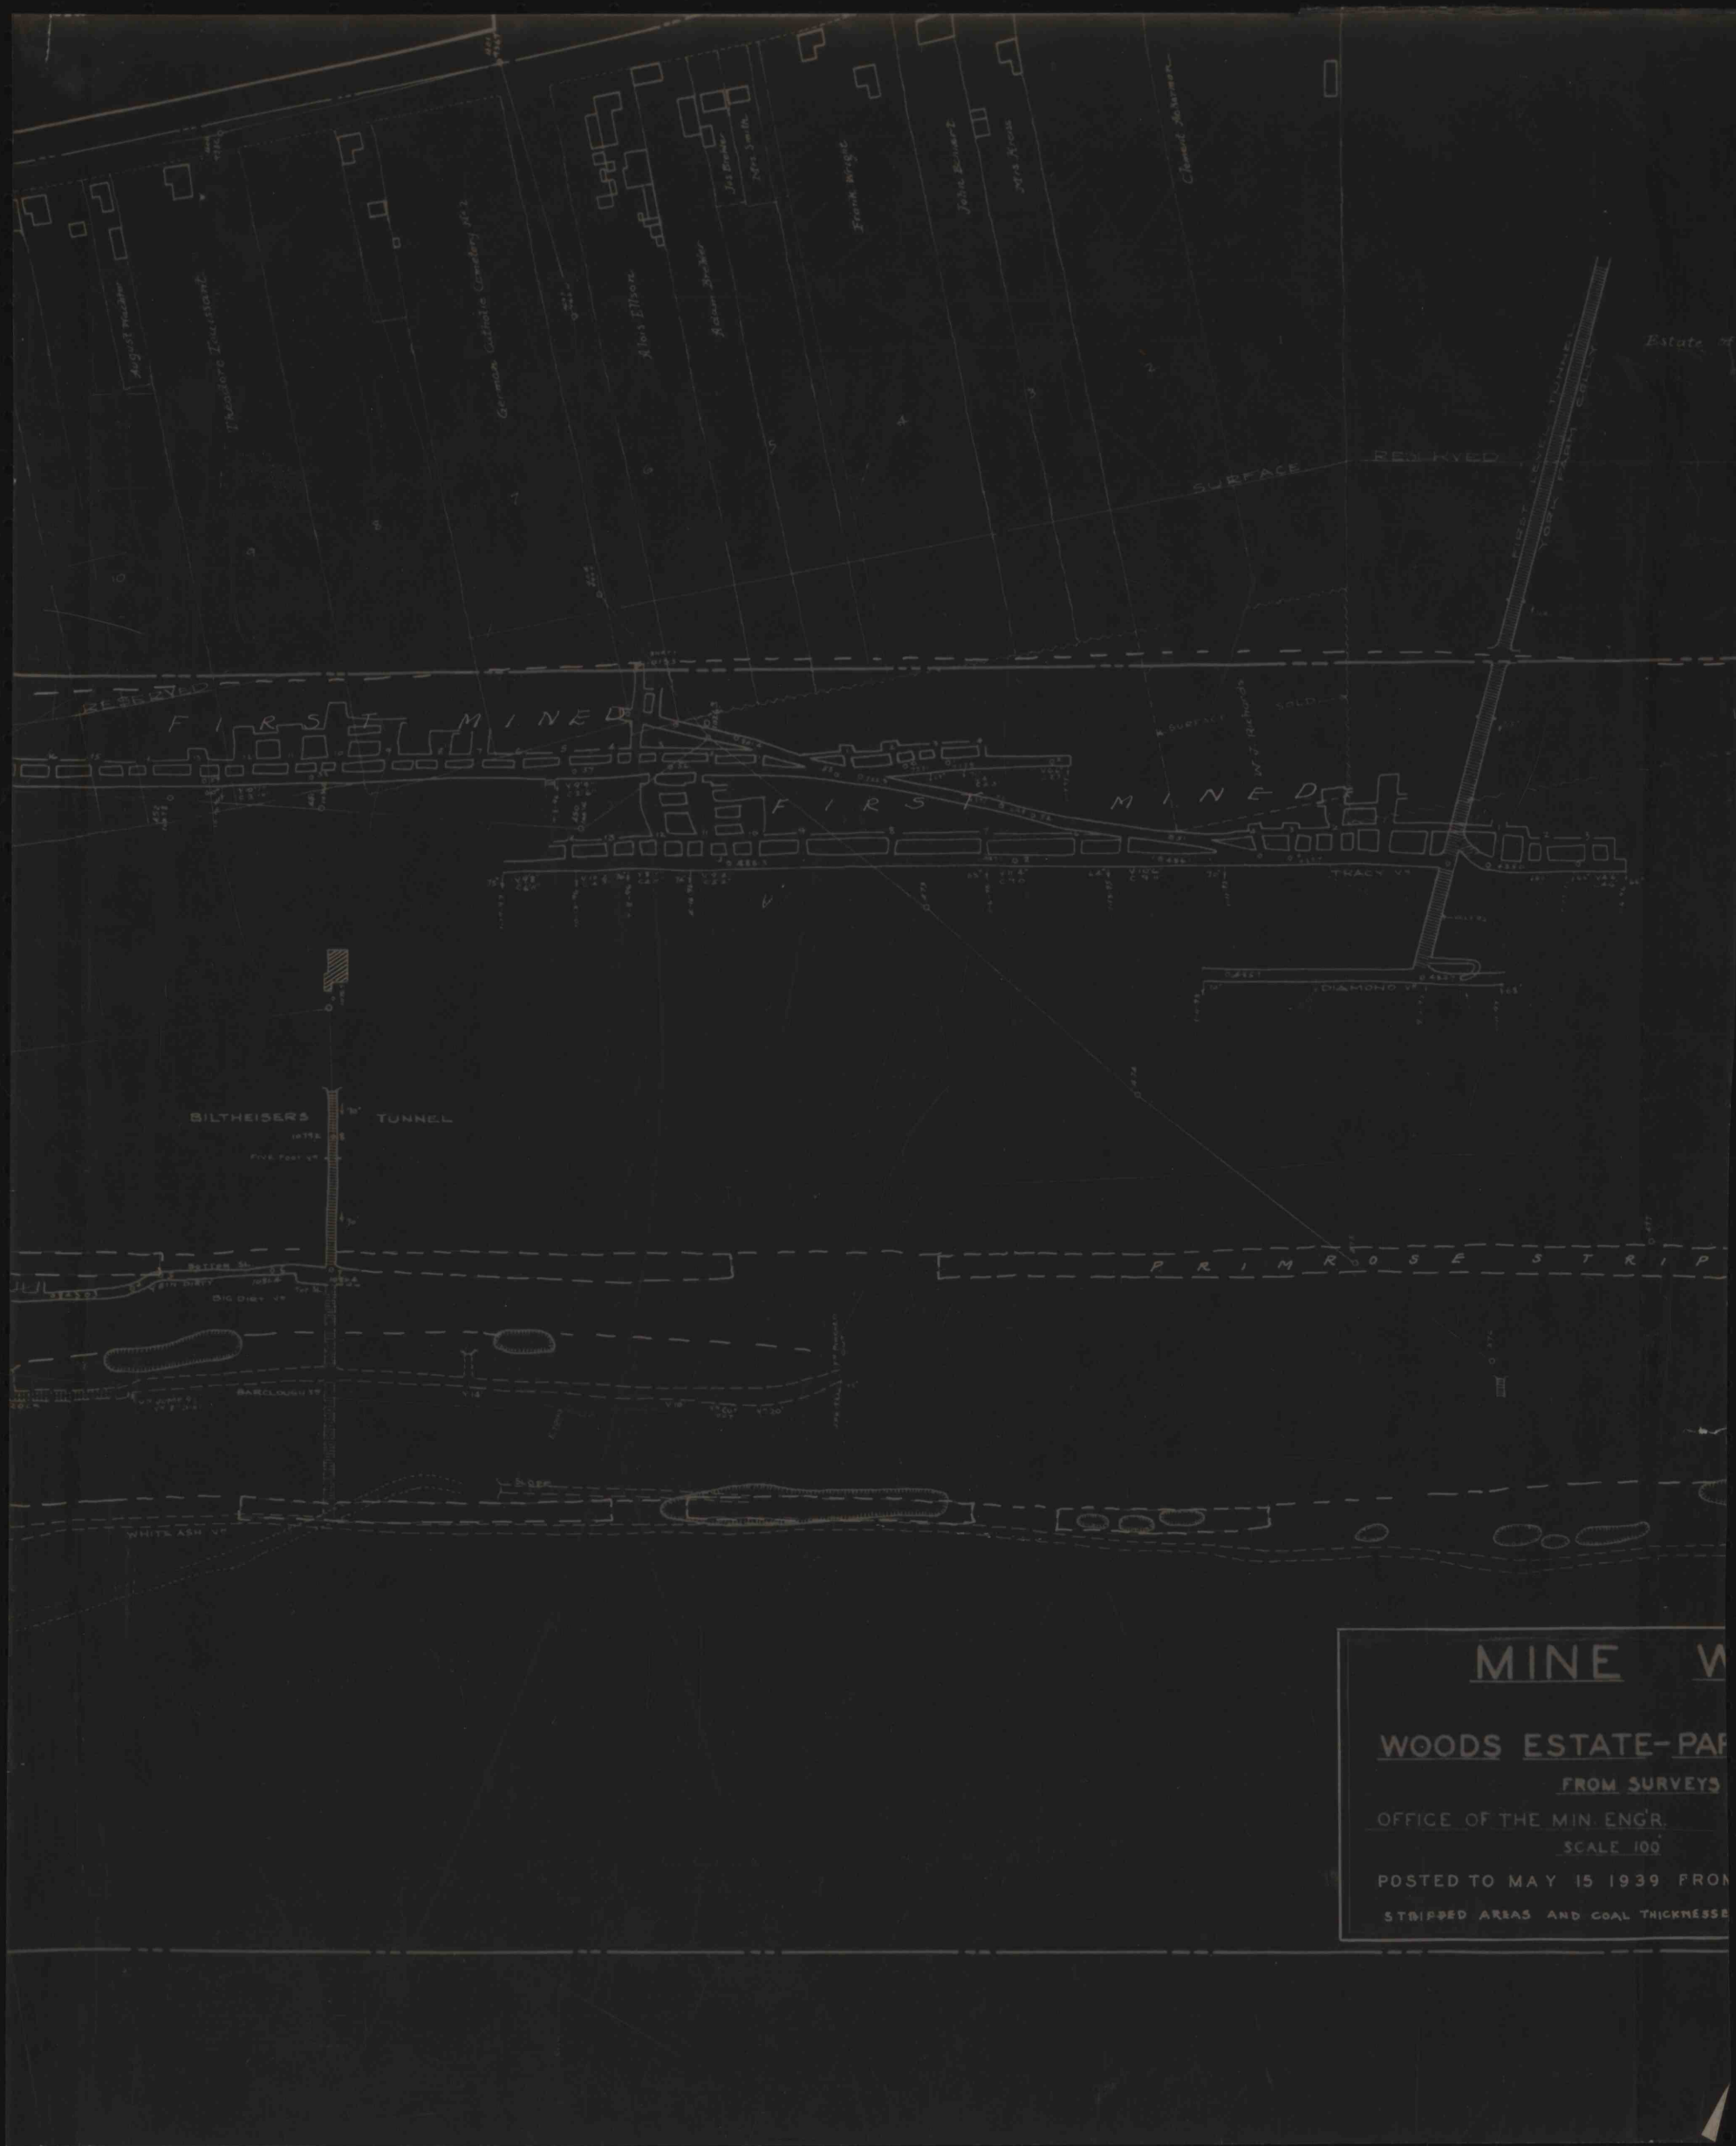
SURFACE
RED HYED
FIRST MINED
FIRST MINED
TRACY VR
DIAMOND VR
BILTHEISERS TUNNEL
PRIMROSE STRIP
BIG DIRT VR
BARCLOUGH VR
WHITE ASH VR
MINE W
WOODS ESTATE-PAR
FROM SURVEYS
OFFICE OF THE MIN. ENG'R.
SCALE 100'
POSTED TO MAY 15 1939 FRON
STRIPPED AREAS AND COAL THICKNESSE