

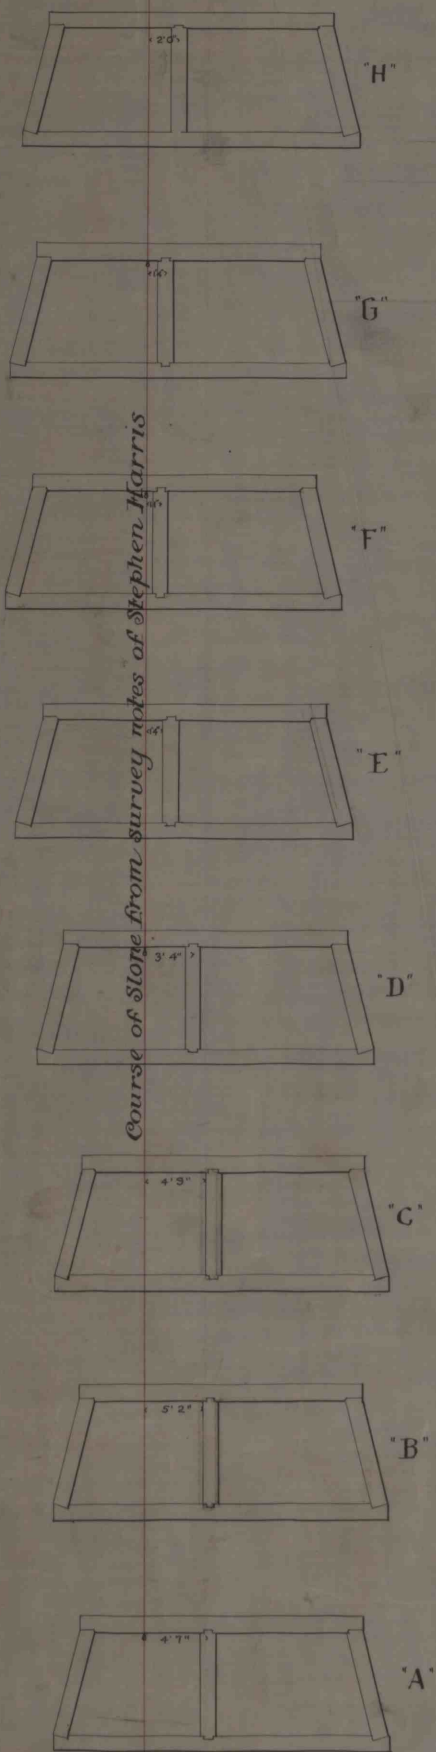


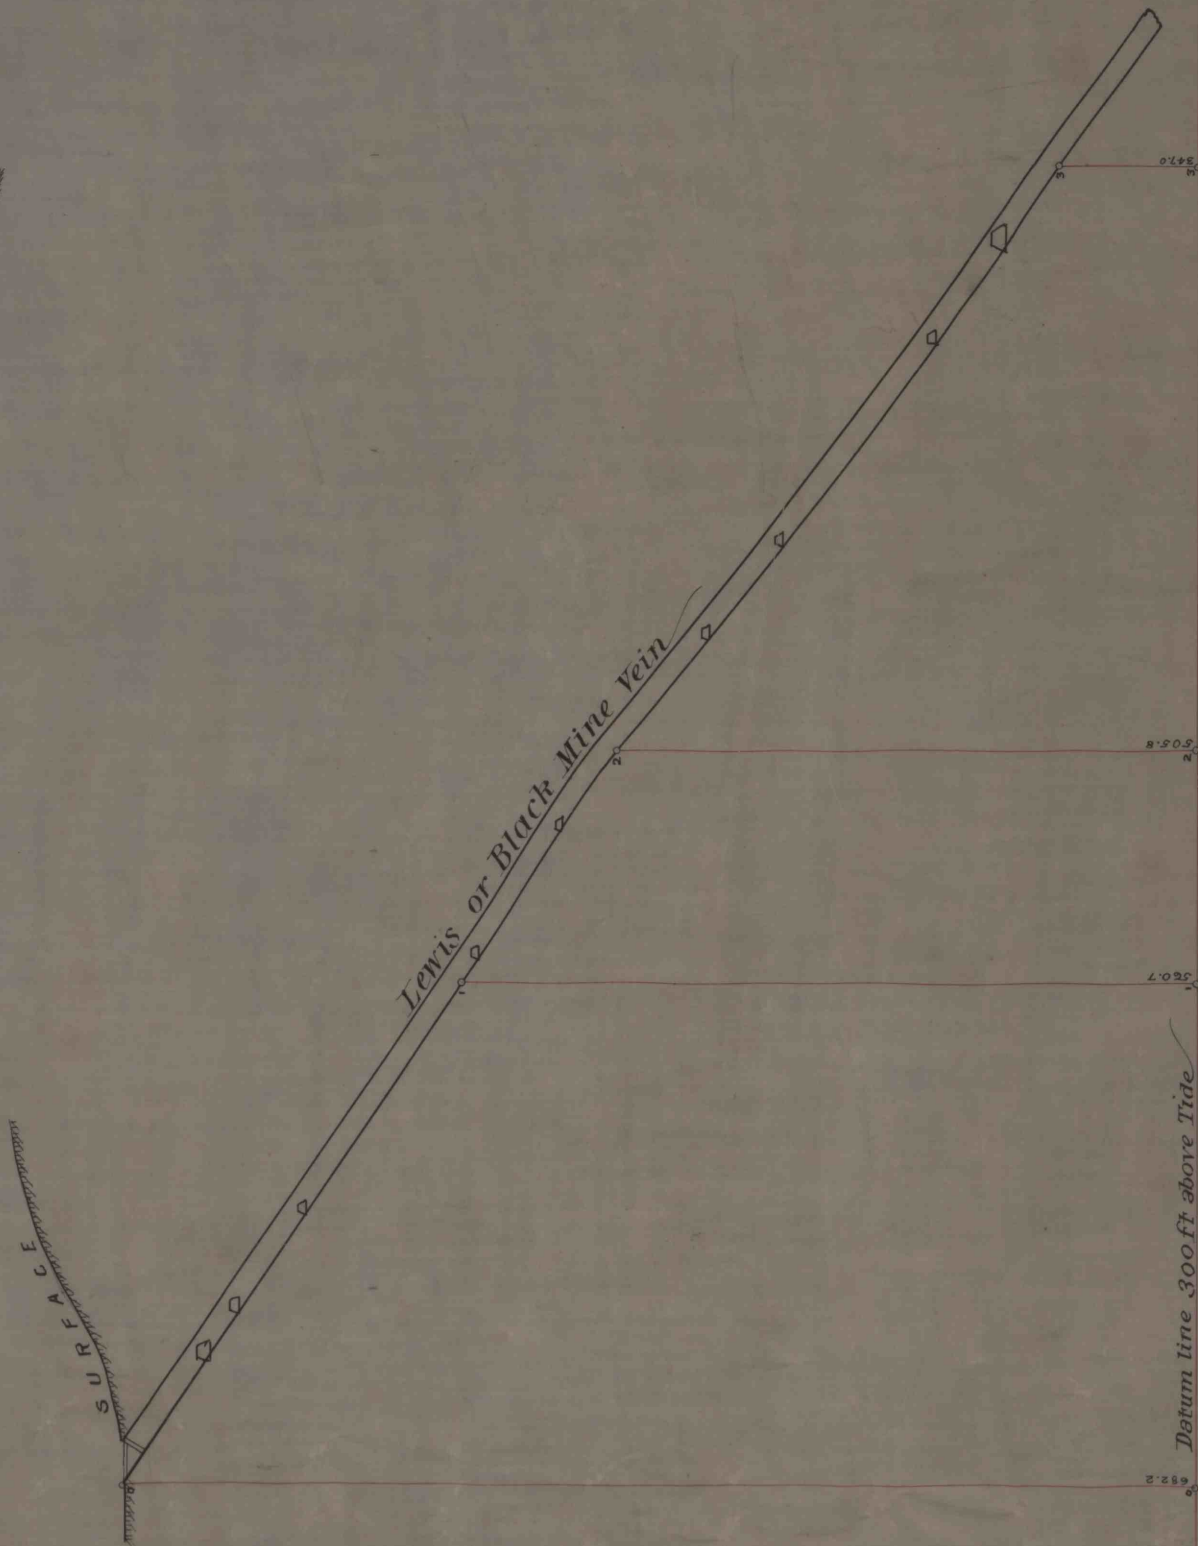

Course of stone from survey notes of Stephen Harris

Gross Sections of Timbering
Scale $\frac{1}{4}$ " = 1 foot

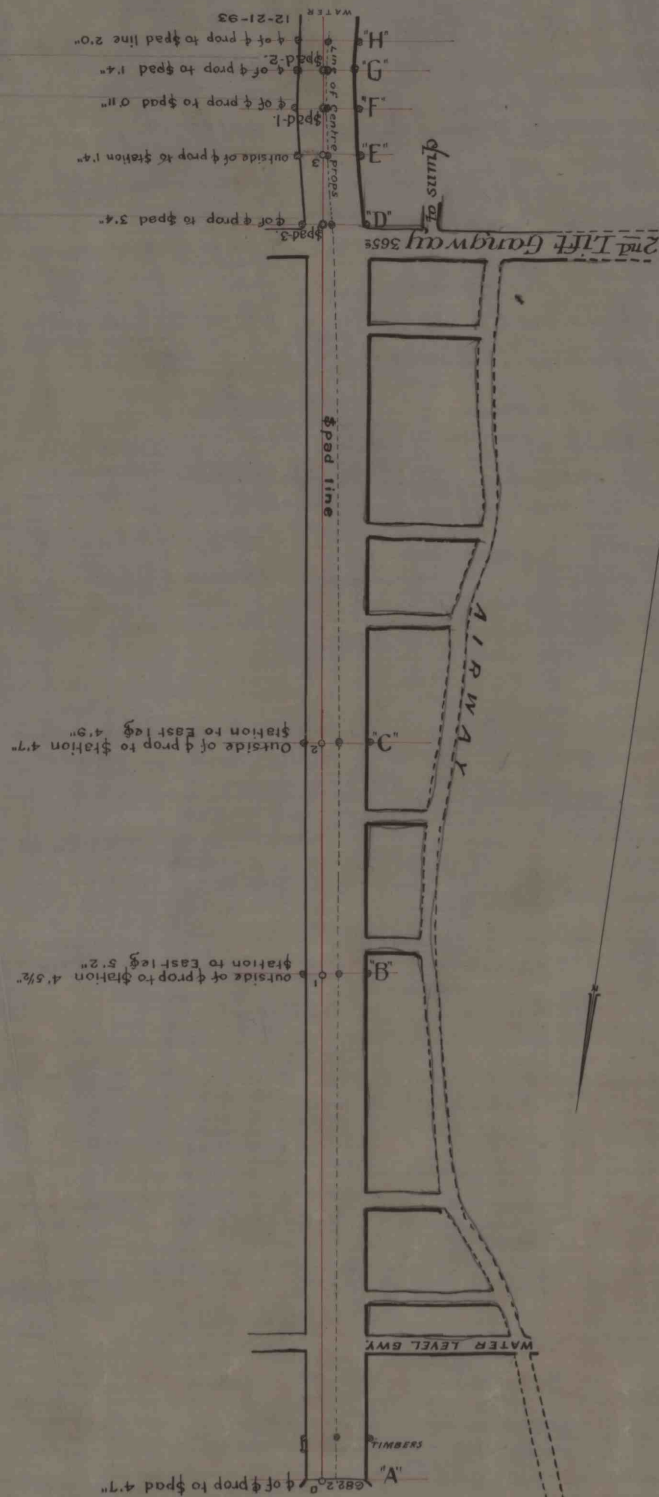

Profile of Slope

Scale 40 ft. per inch

PLAN & PROFILE OF

Chamberlain Coal Co's slope

Scale 40 feet per inch

Dec. 23rd 1893.

A.B. Cochran & Son

MINING ENGINEERS
-POTTSVILLE PA.