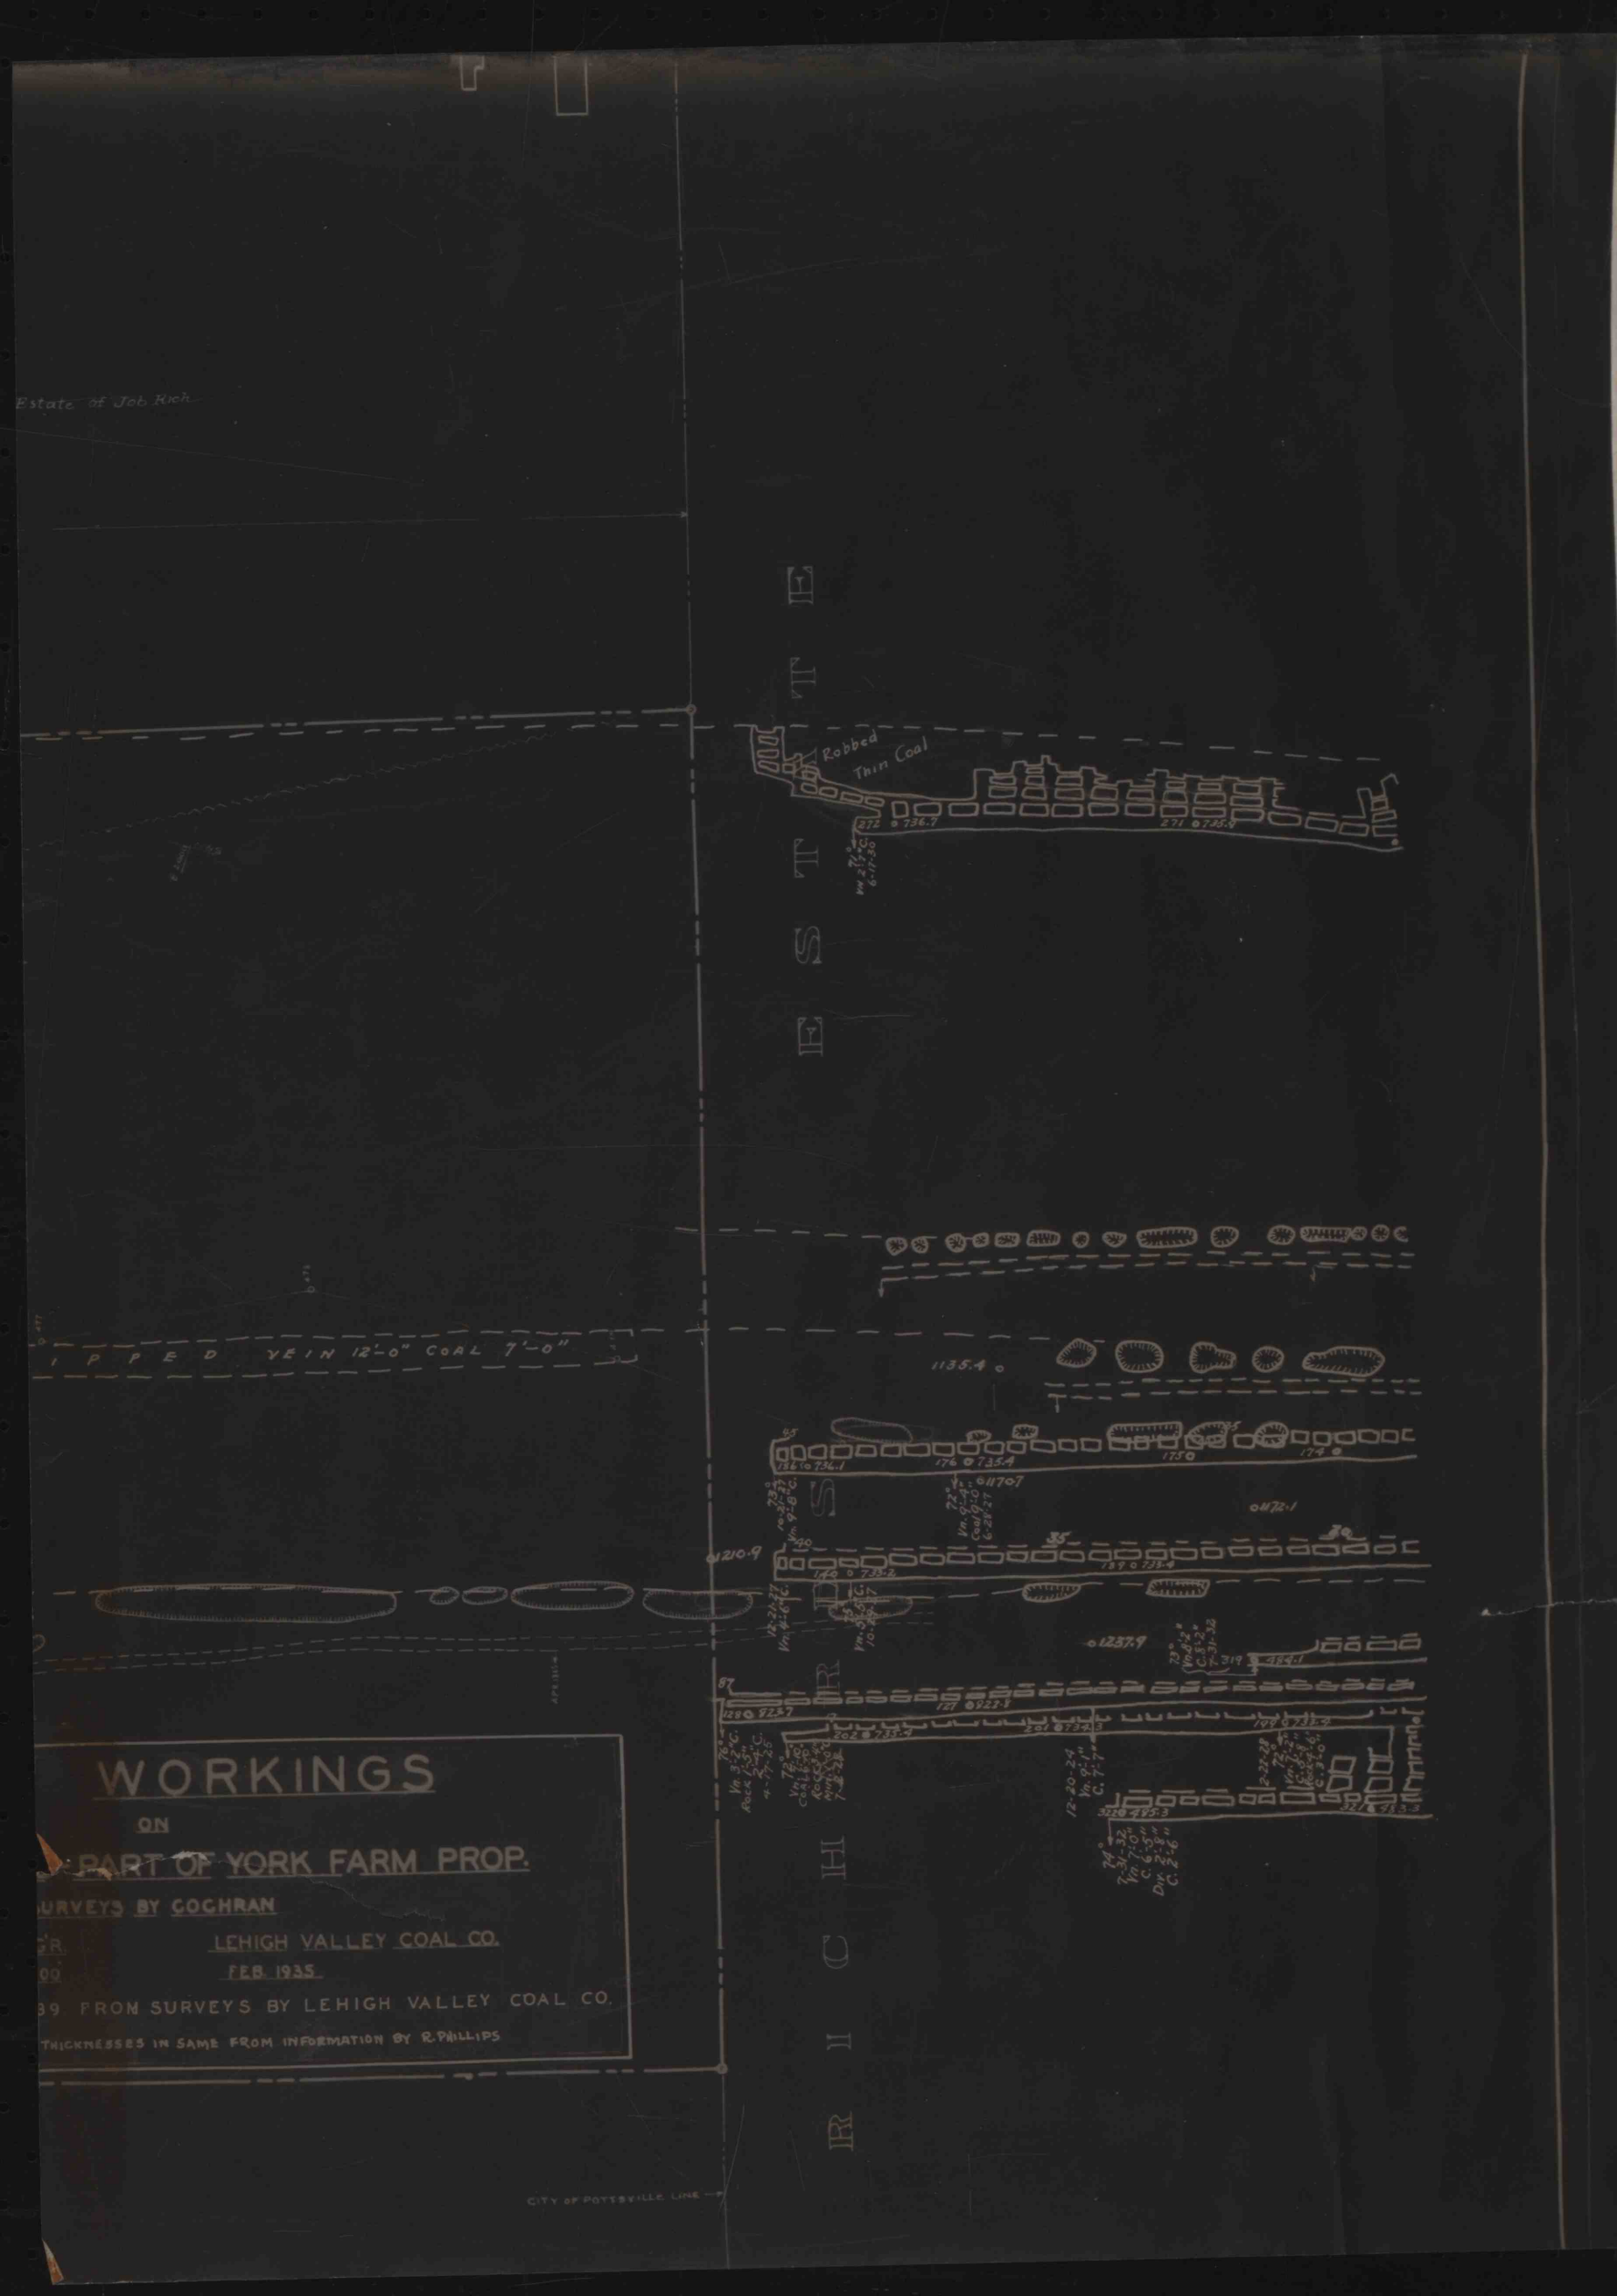
Estate of Job Rich
Robbed Thin Coal
I P P E D VEIN 12'-0" COAL 7'-0"
WORKINGS
ON
PART OF YORK FARM PROP.
URVEYS BY COCHRAN
LEHIGH VALLEY COAL CO.
FEB. 1935
39 FROM SURVEYS BY LEHIGH VALLEY COAL CO.
THICKNESSES IN SAME FROM INFORMATION BY R. PHILLIPS
CITY OF POTTSVILLE LINE