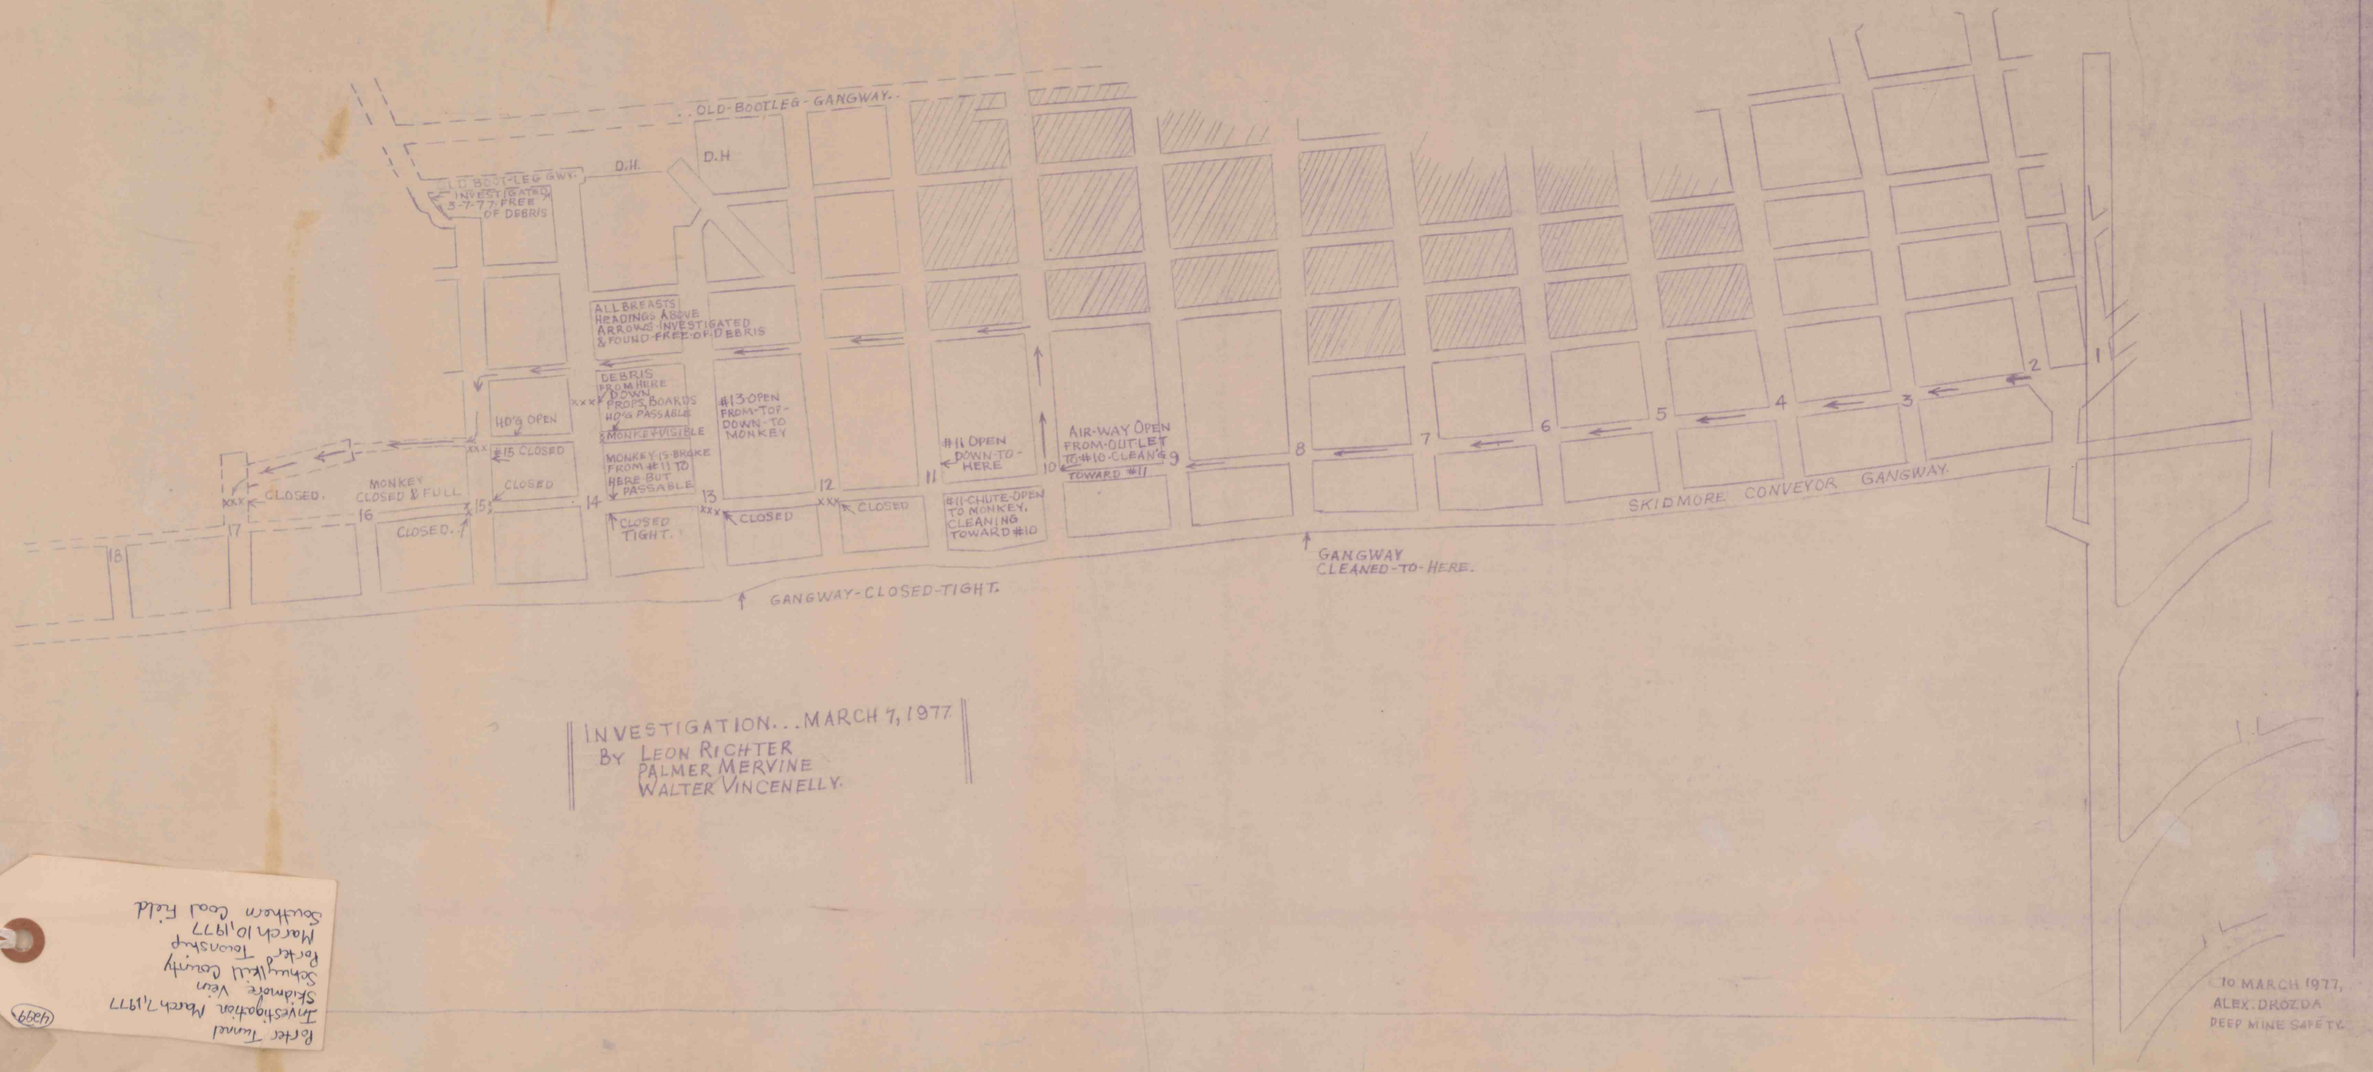

Forter Tunnel
Investigation March 7, 1977
Skidmore Vein
Schuylkill County
Forter Township
March 10, 1977
Southern Coal Field
(4899)