


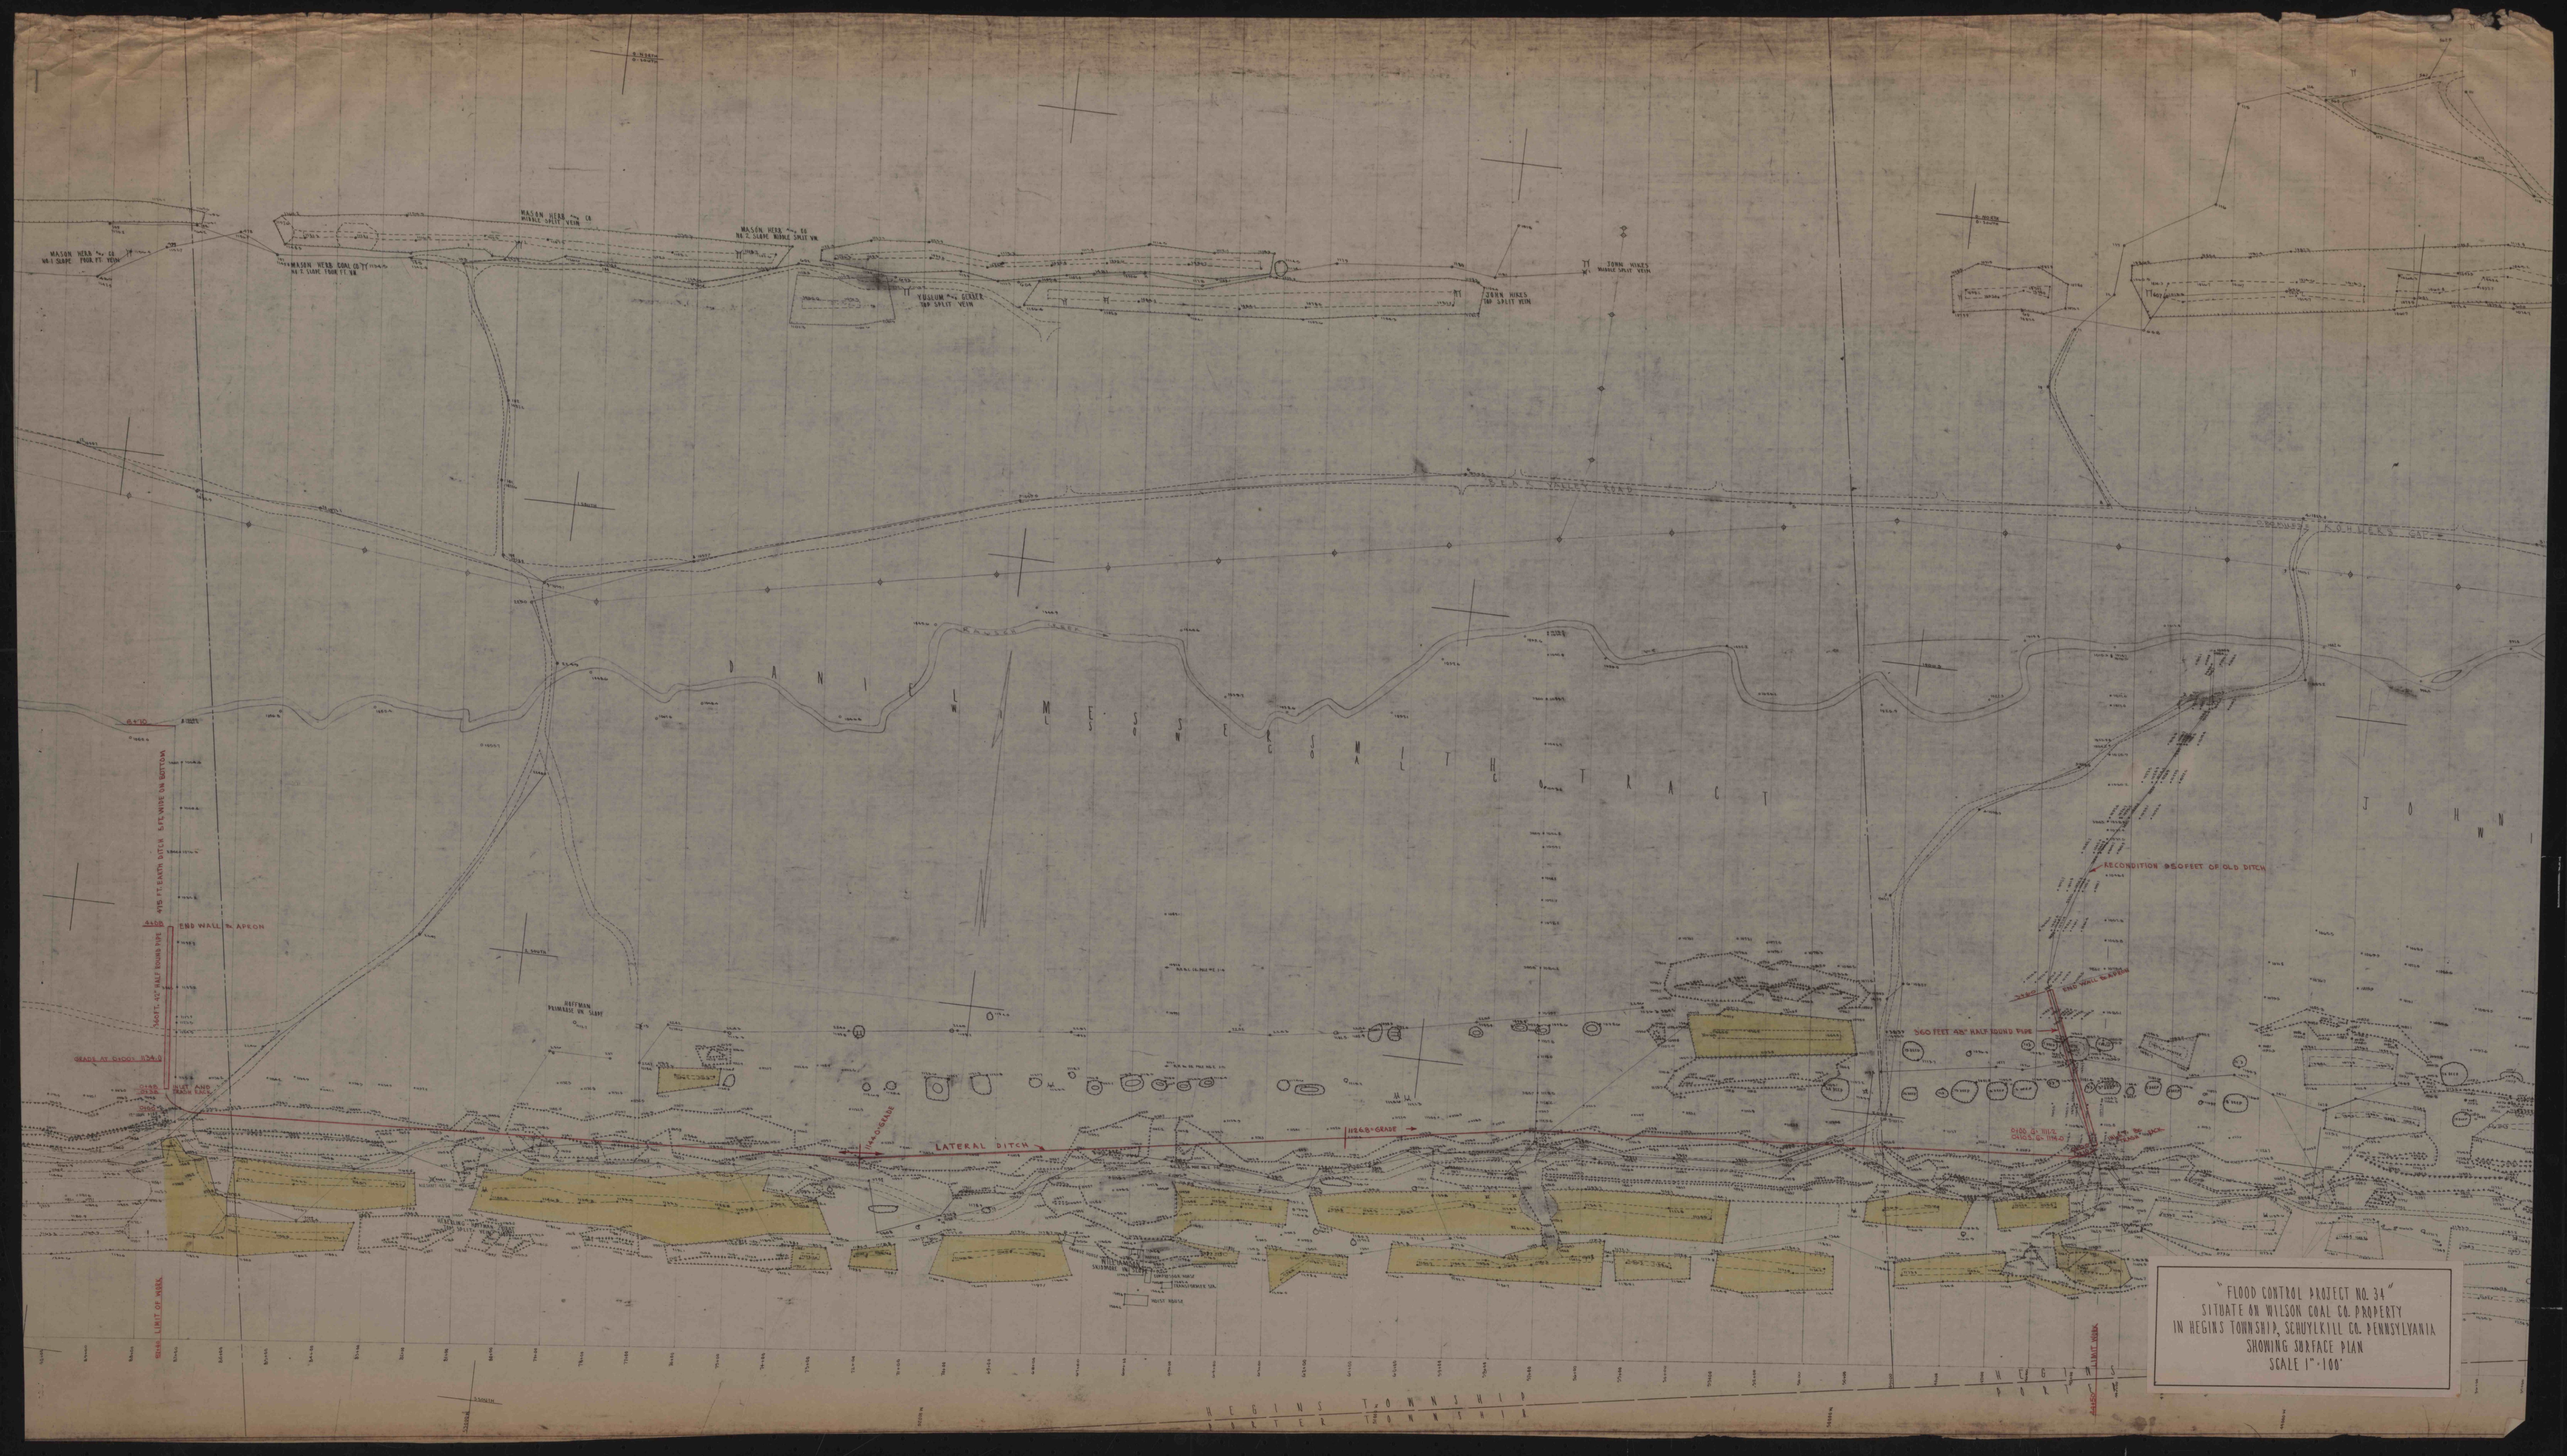

FLOOD CONTROL PROJECT NO. 34
SITUATE ON WILSON COAL CO. PROPERTY
IN HEGINS TOWNSHIP, SCHUYLKILL CO. PENNSYLVANIA
SHOWING SURFACE PLAN
SCALE 1"=100'