


Dana Tract
Rough

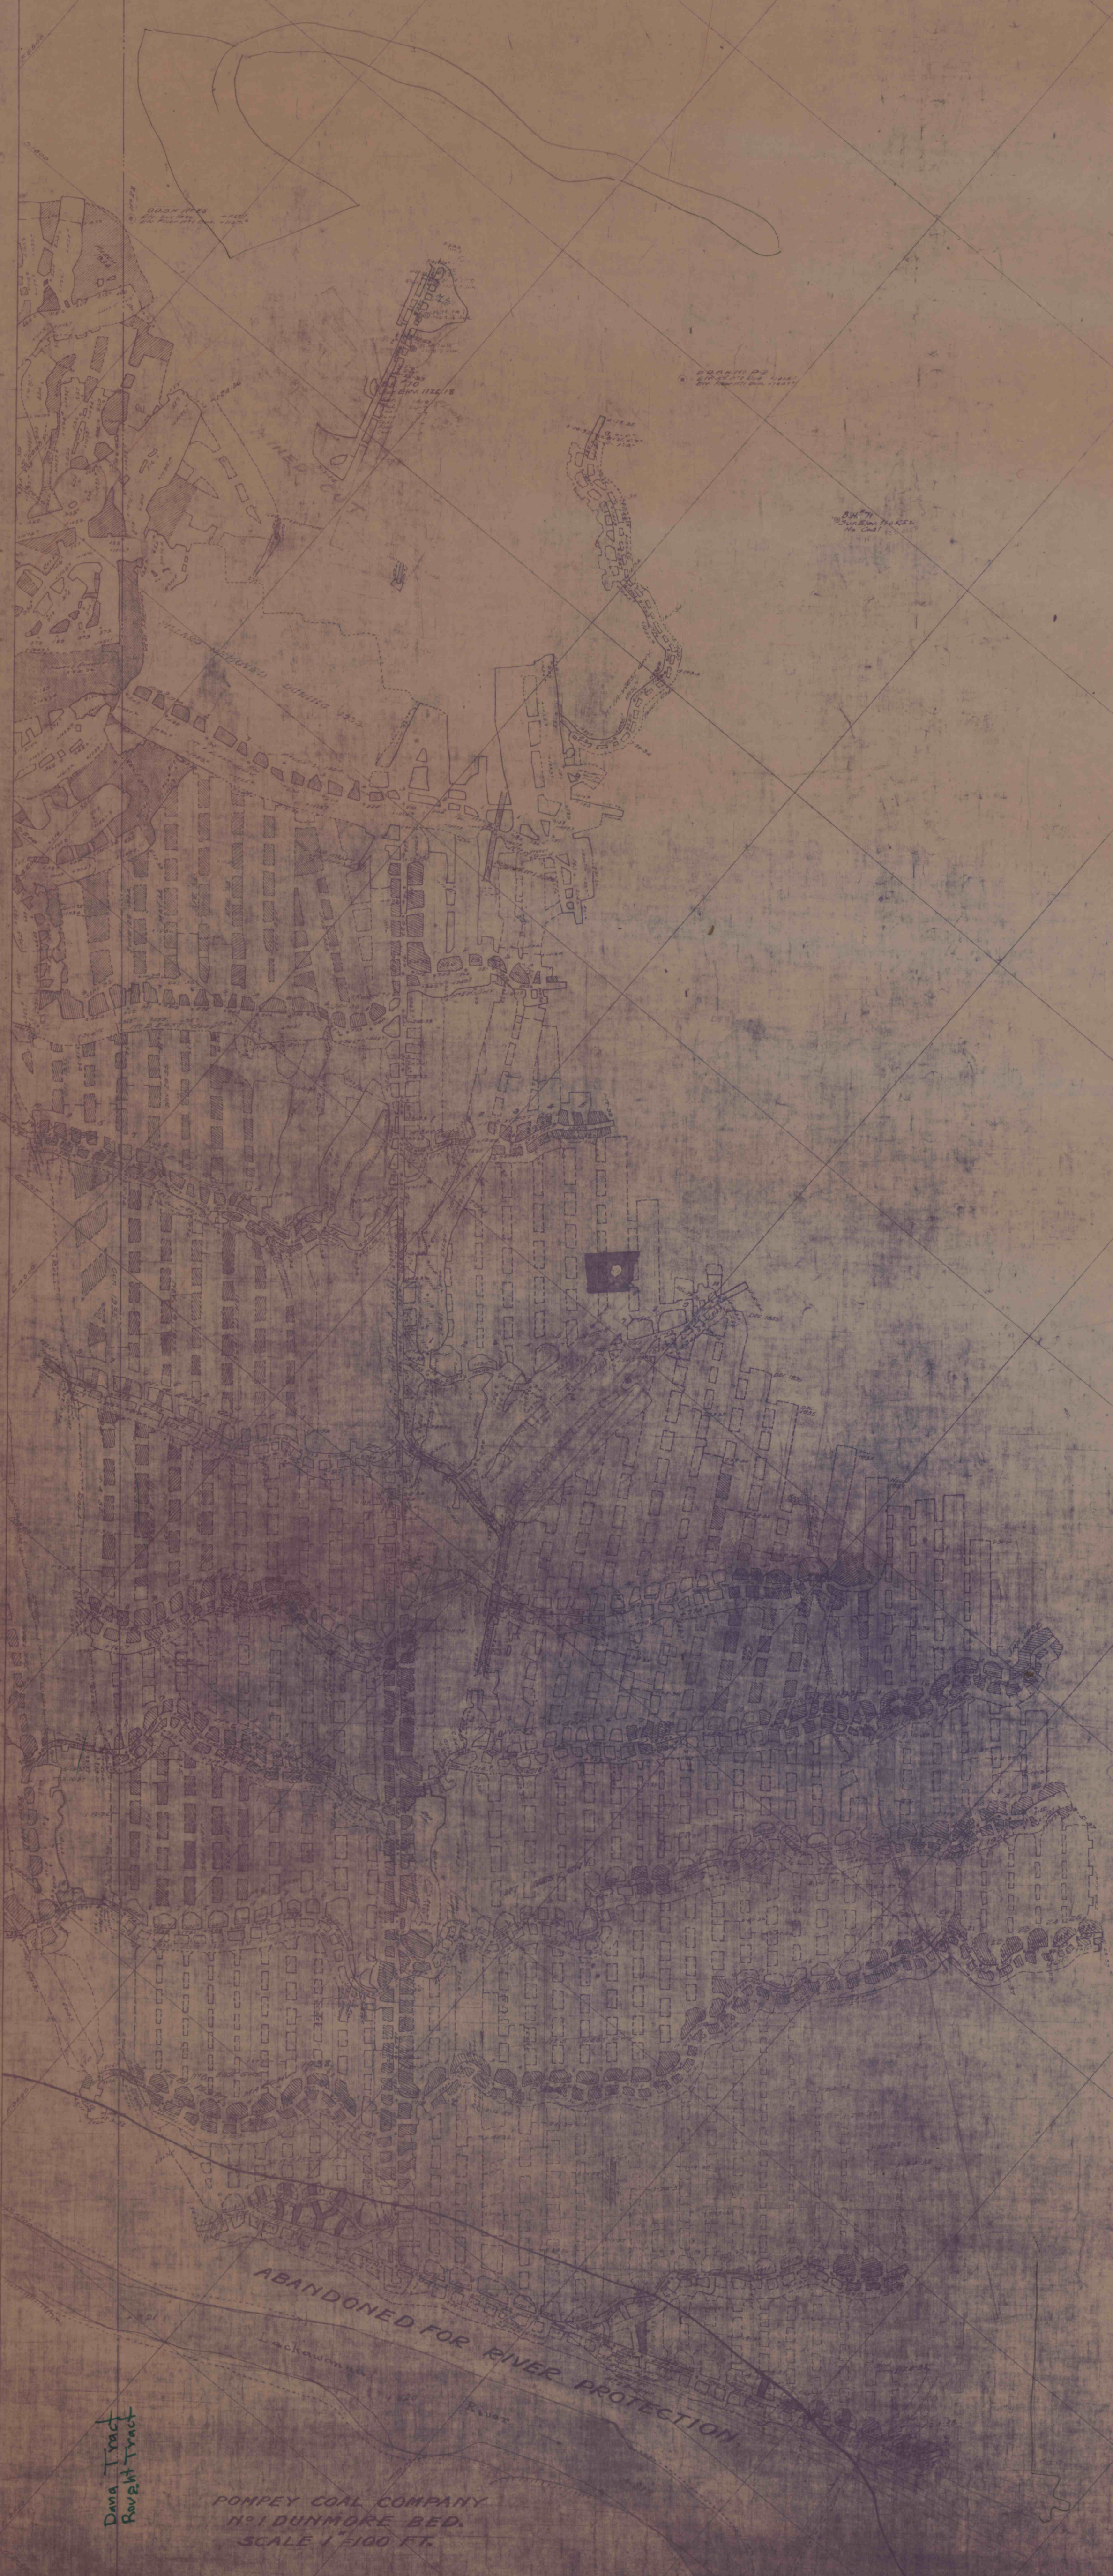

Dana Tract
Rough

POMPEY COAL COMPANY
NO. 1 DUNMORE BED.
SCALE 1"=100 FT.