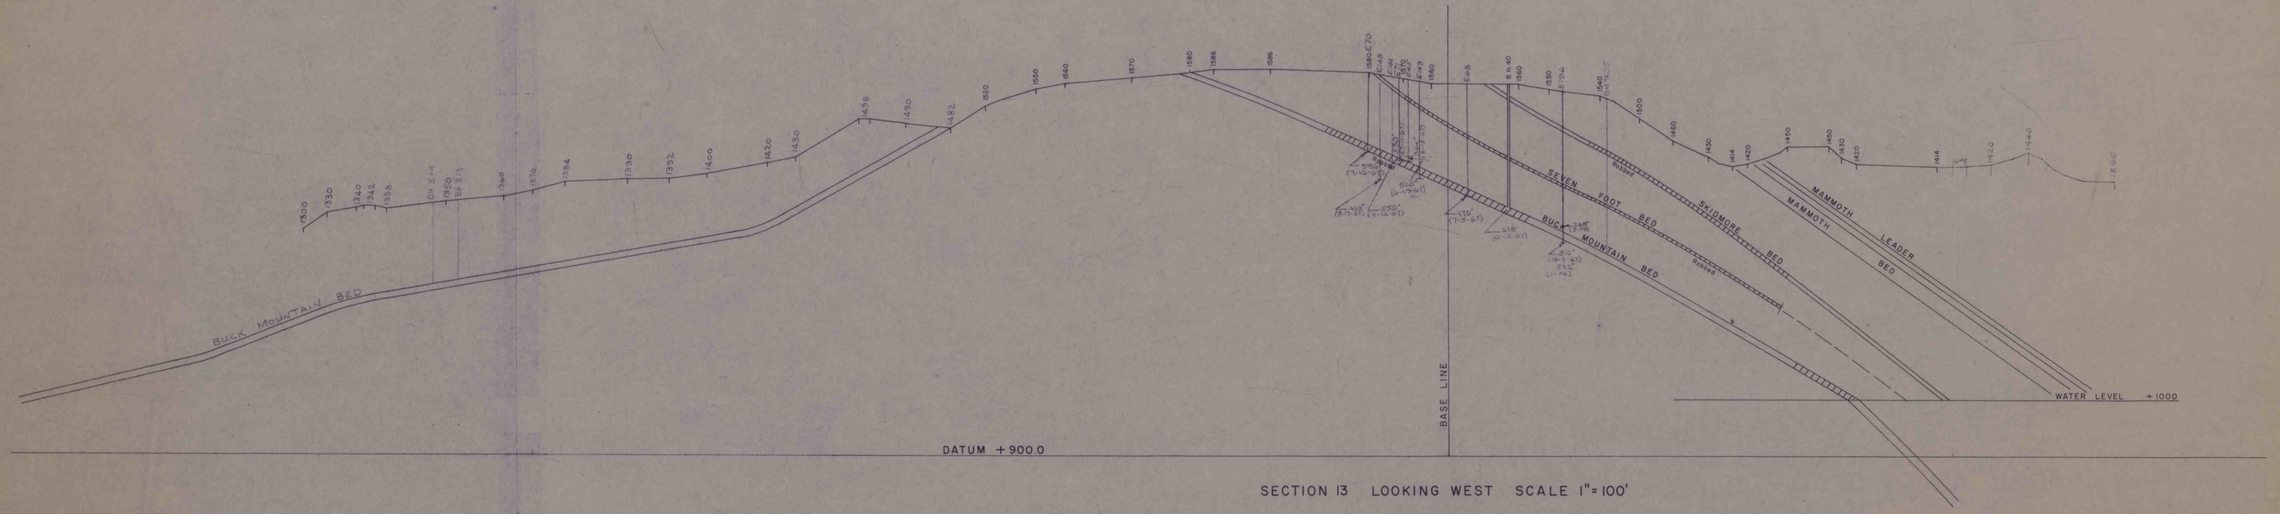

SECTION 13 LOOKING WEST SCALE 1"=100'

CENTRALIA