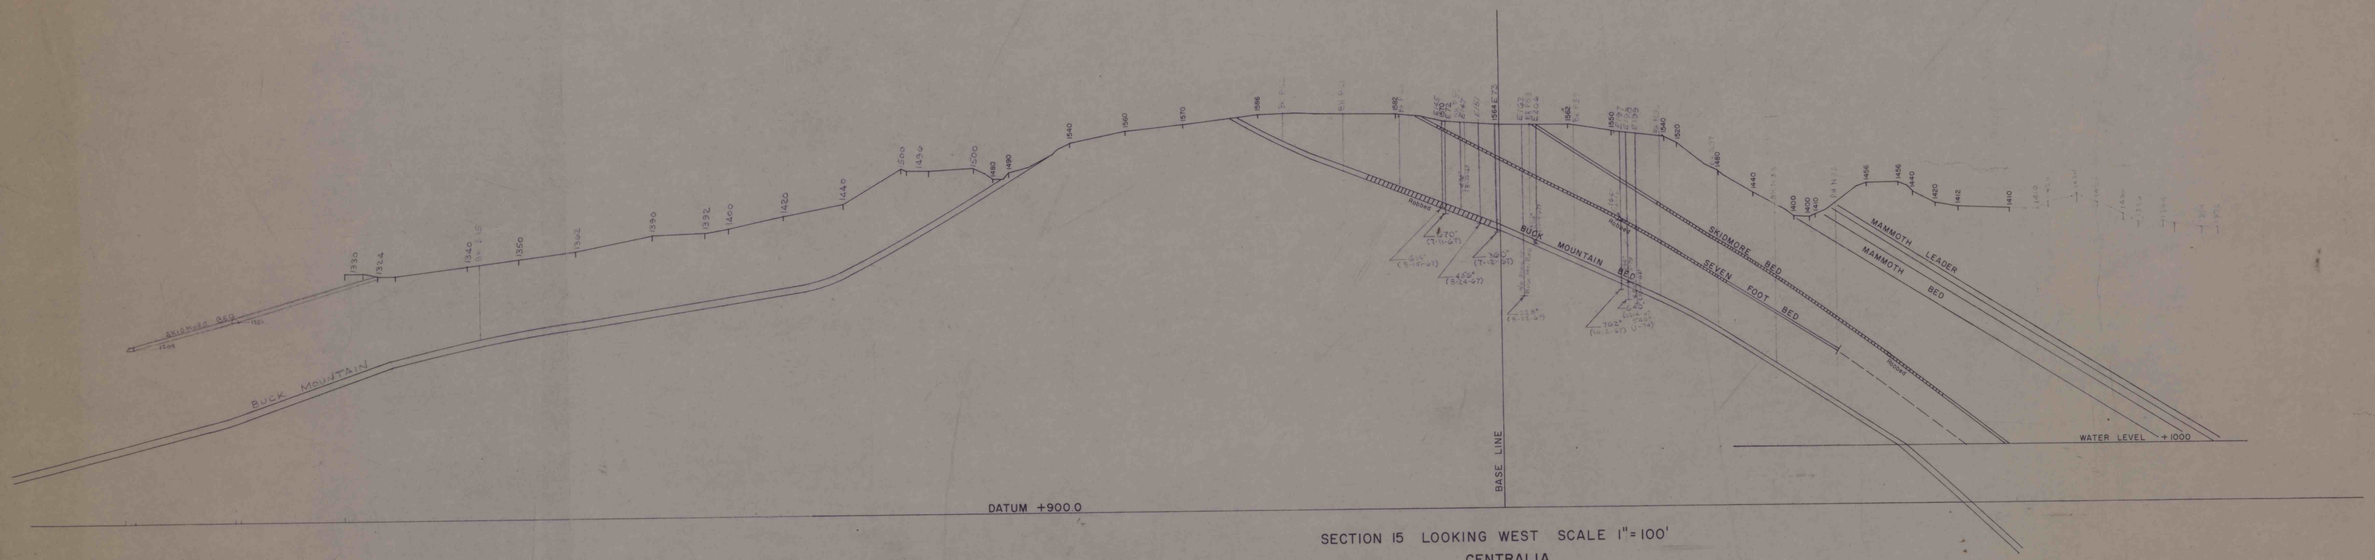

SECTION 15 LOOKING WEST SCALE 1" = 100'
CENTRALIA