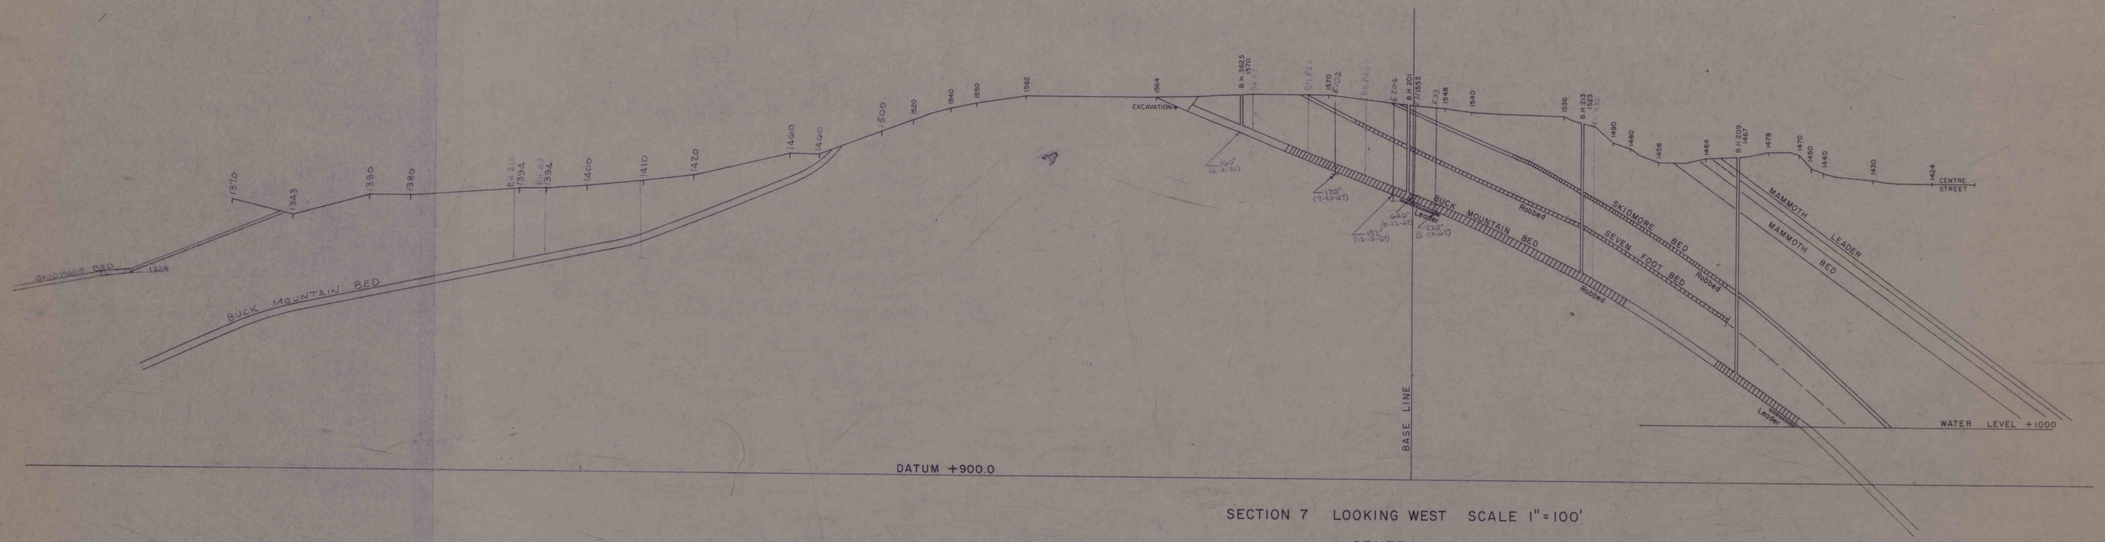

SECTION 7 LOOKING WEST SCALE 1" = 100'

CENTRALIA