


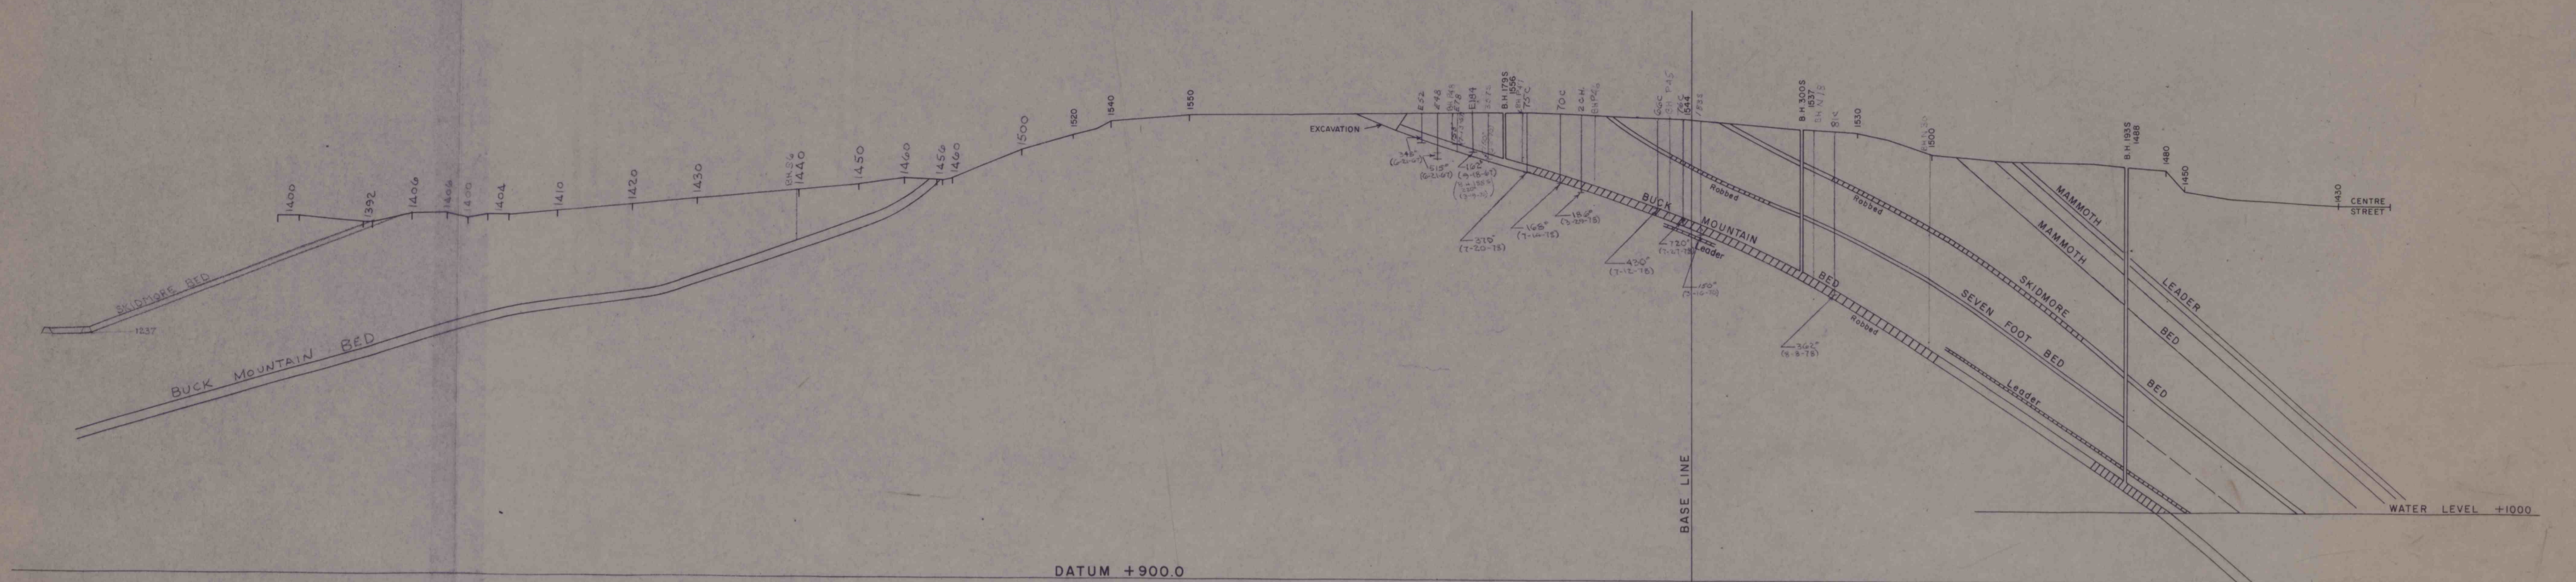

SECTION 3 LOOKING WEST SCALE 1"=100'
CENTRALIA