


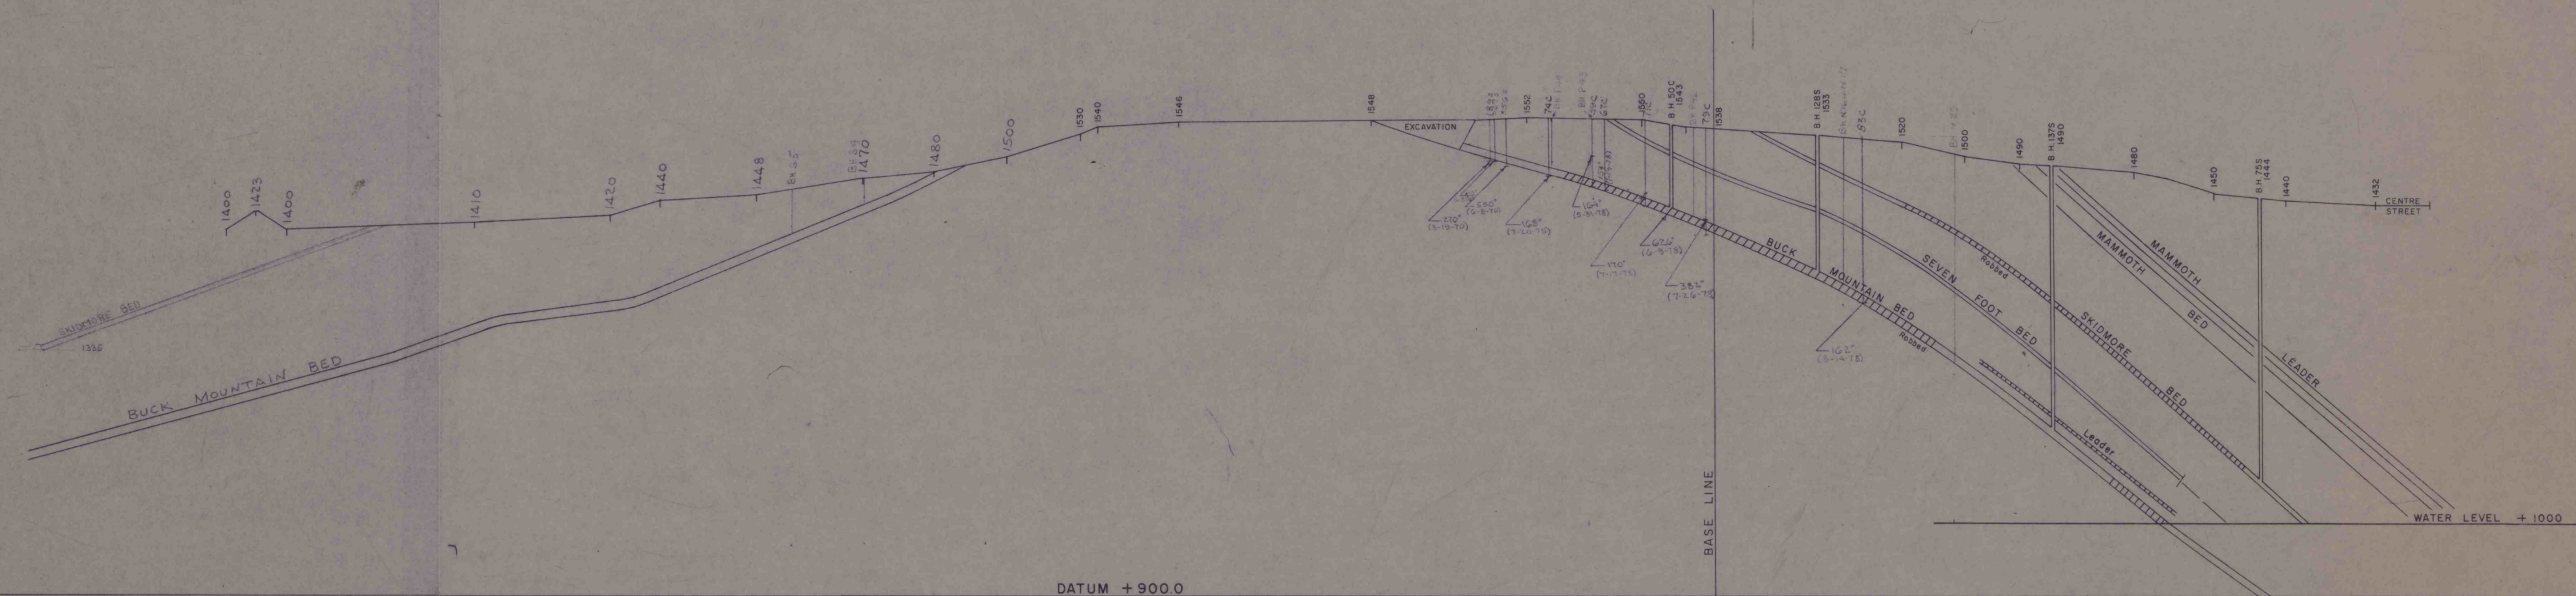

SECTION I LOOKING WEST SCALE 1"=100'  
CENTRALIA

Centralia Colliery  
Lehigh Valley Coal Co.  
Various Veins  
Columbia County  
North Conyngham Township  
Cross Section  
Western Middle Coal Field  
1 1/2 100'  
12 maps  
Centralia Mine Fire

4319