


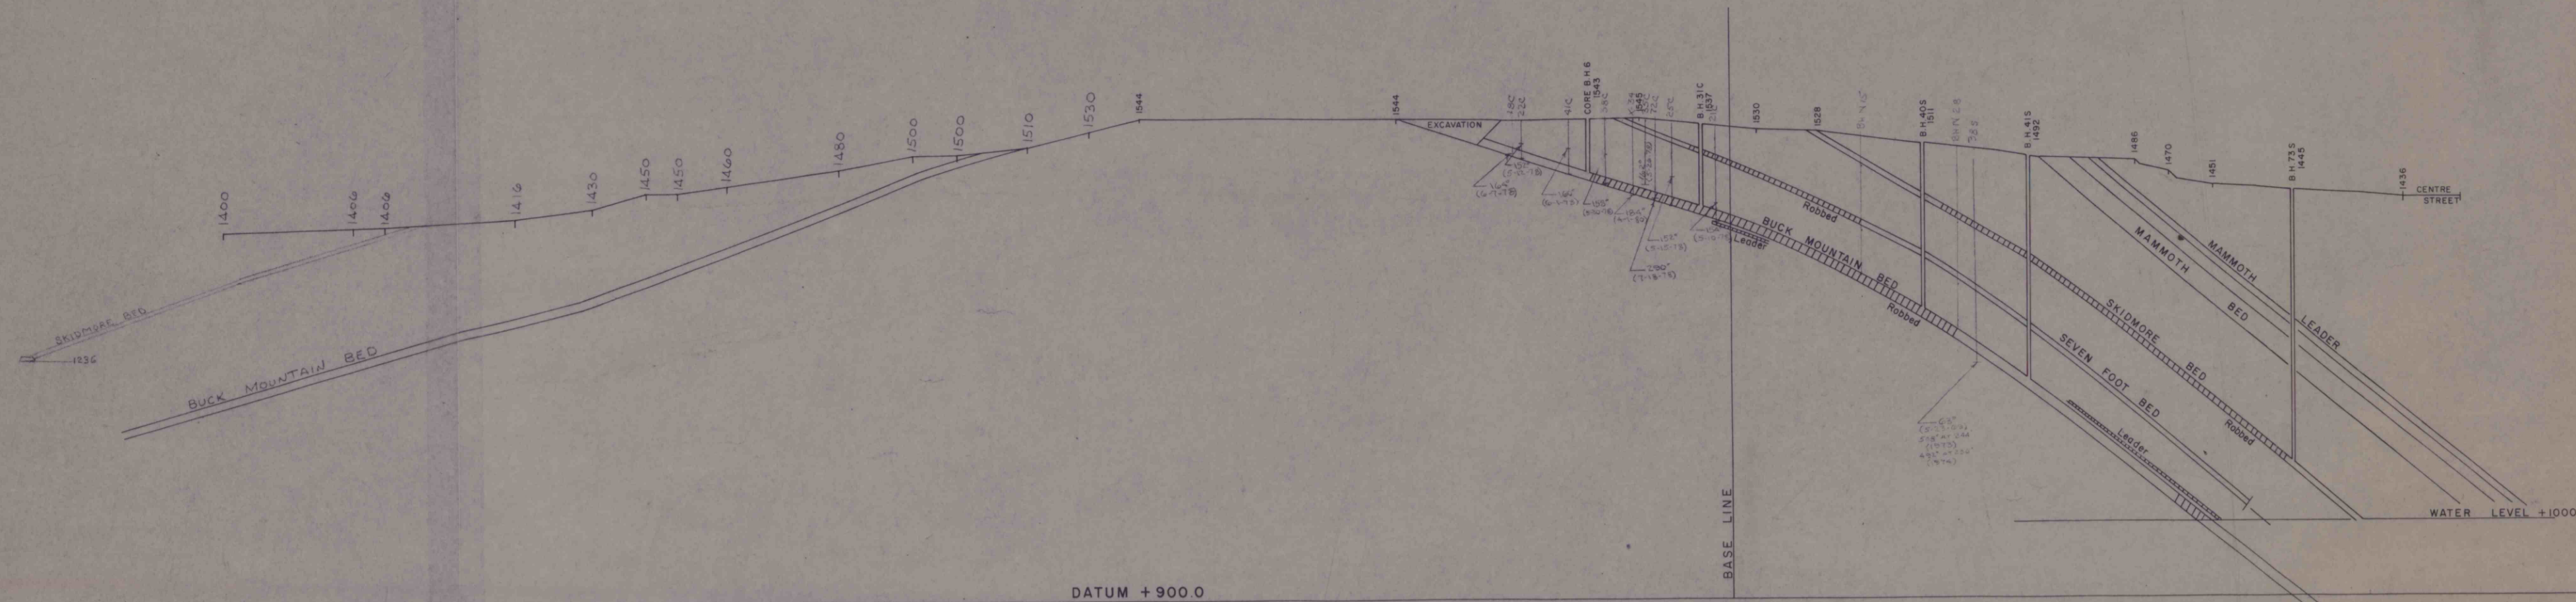

SECTION O LOOKING WEST SCALE 1"=100'
CENTRALIA