



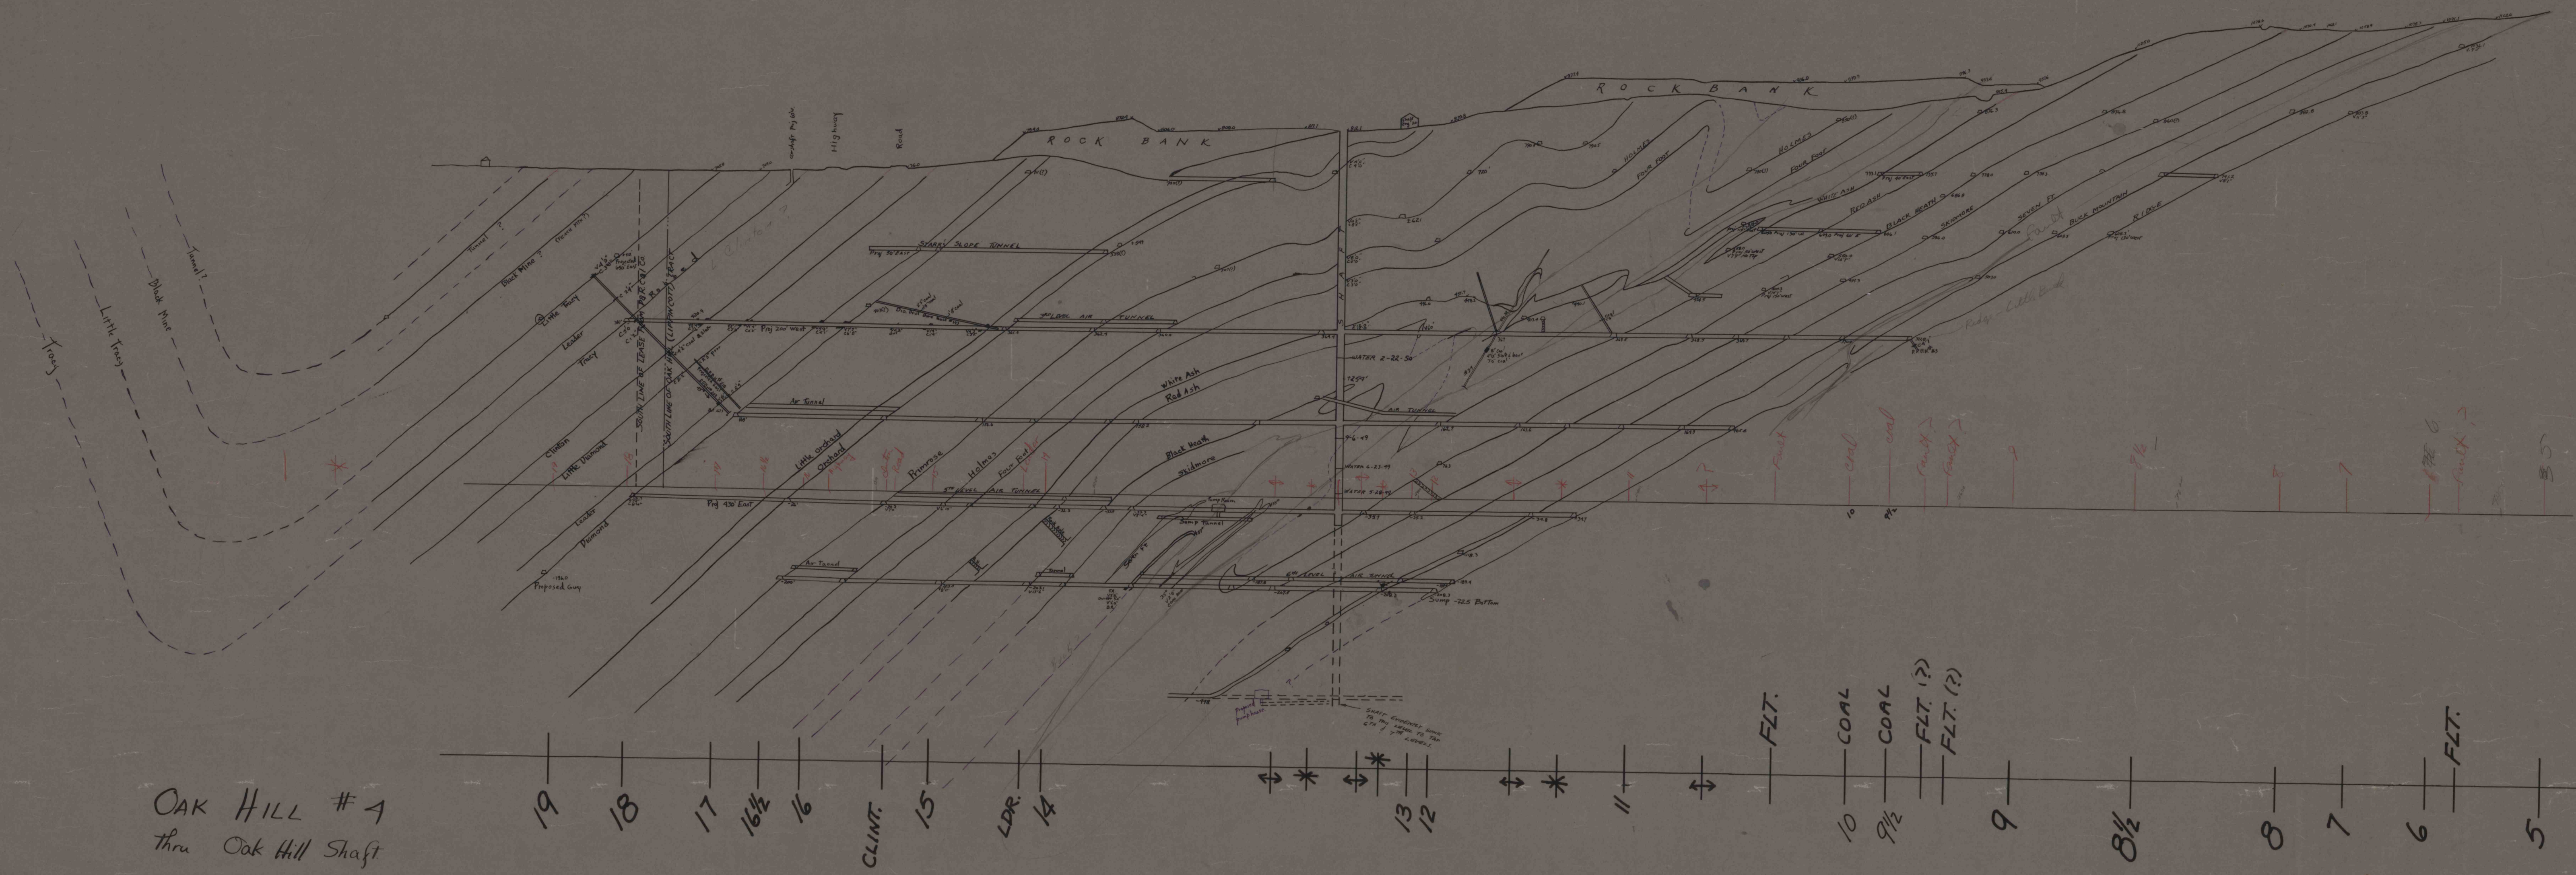

OAK HILL #4
 thru Oak Hill Shaft