


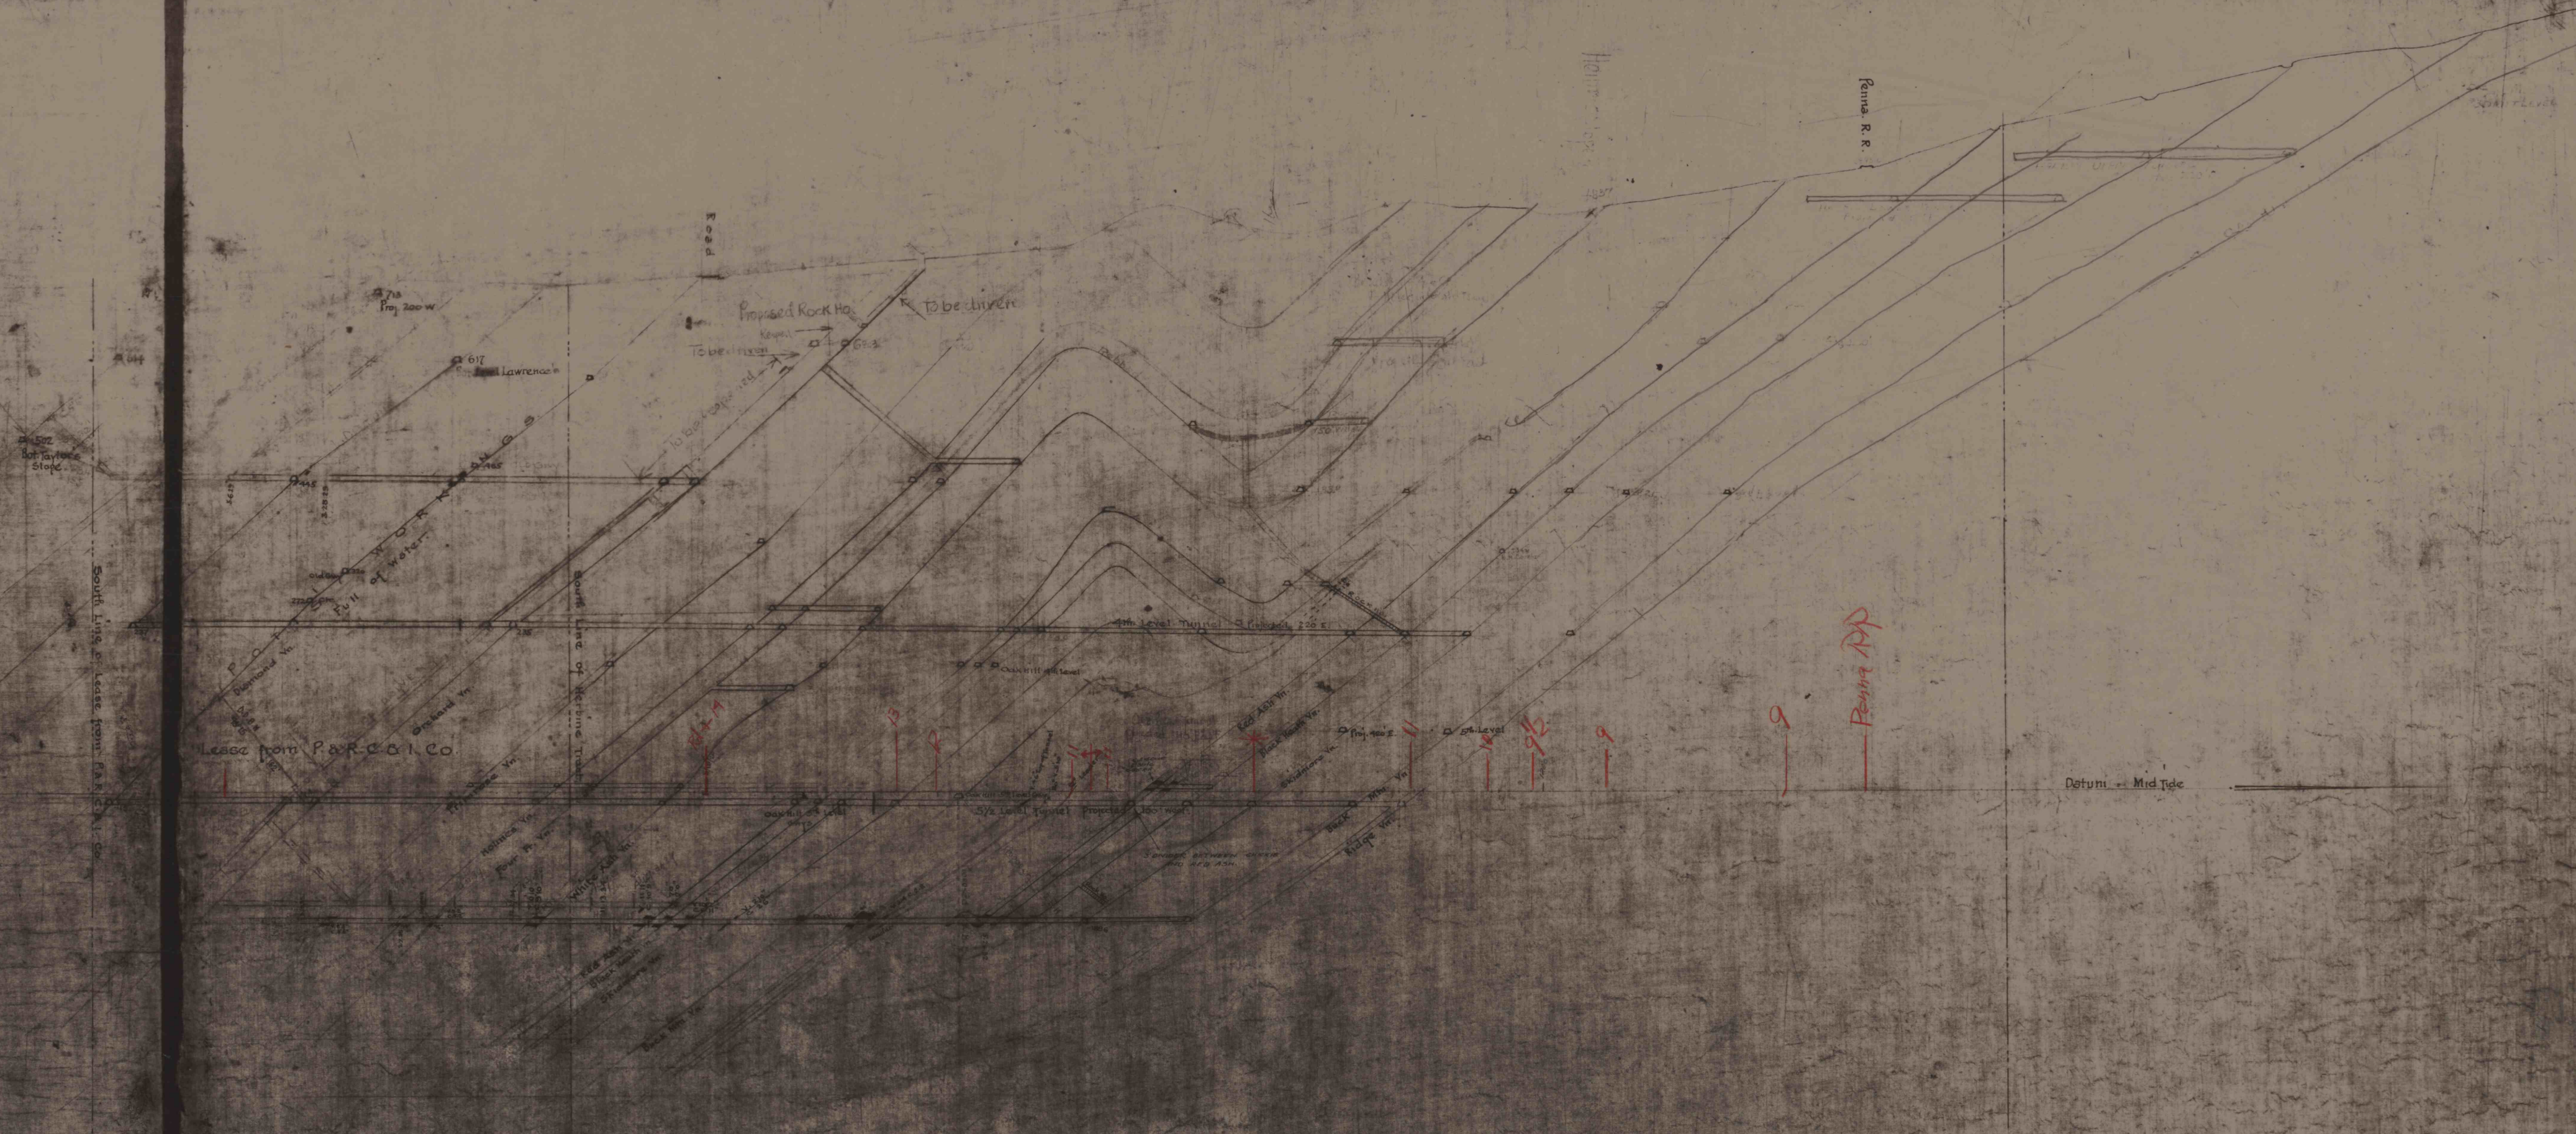

10 1/2

10 1/2 ^{old} original see copy to use extent not shown on original