


Cross Section No. 11

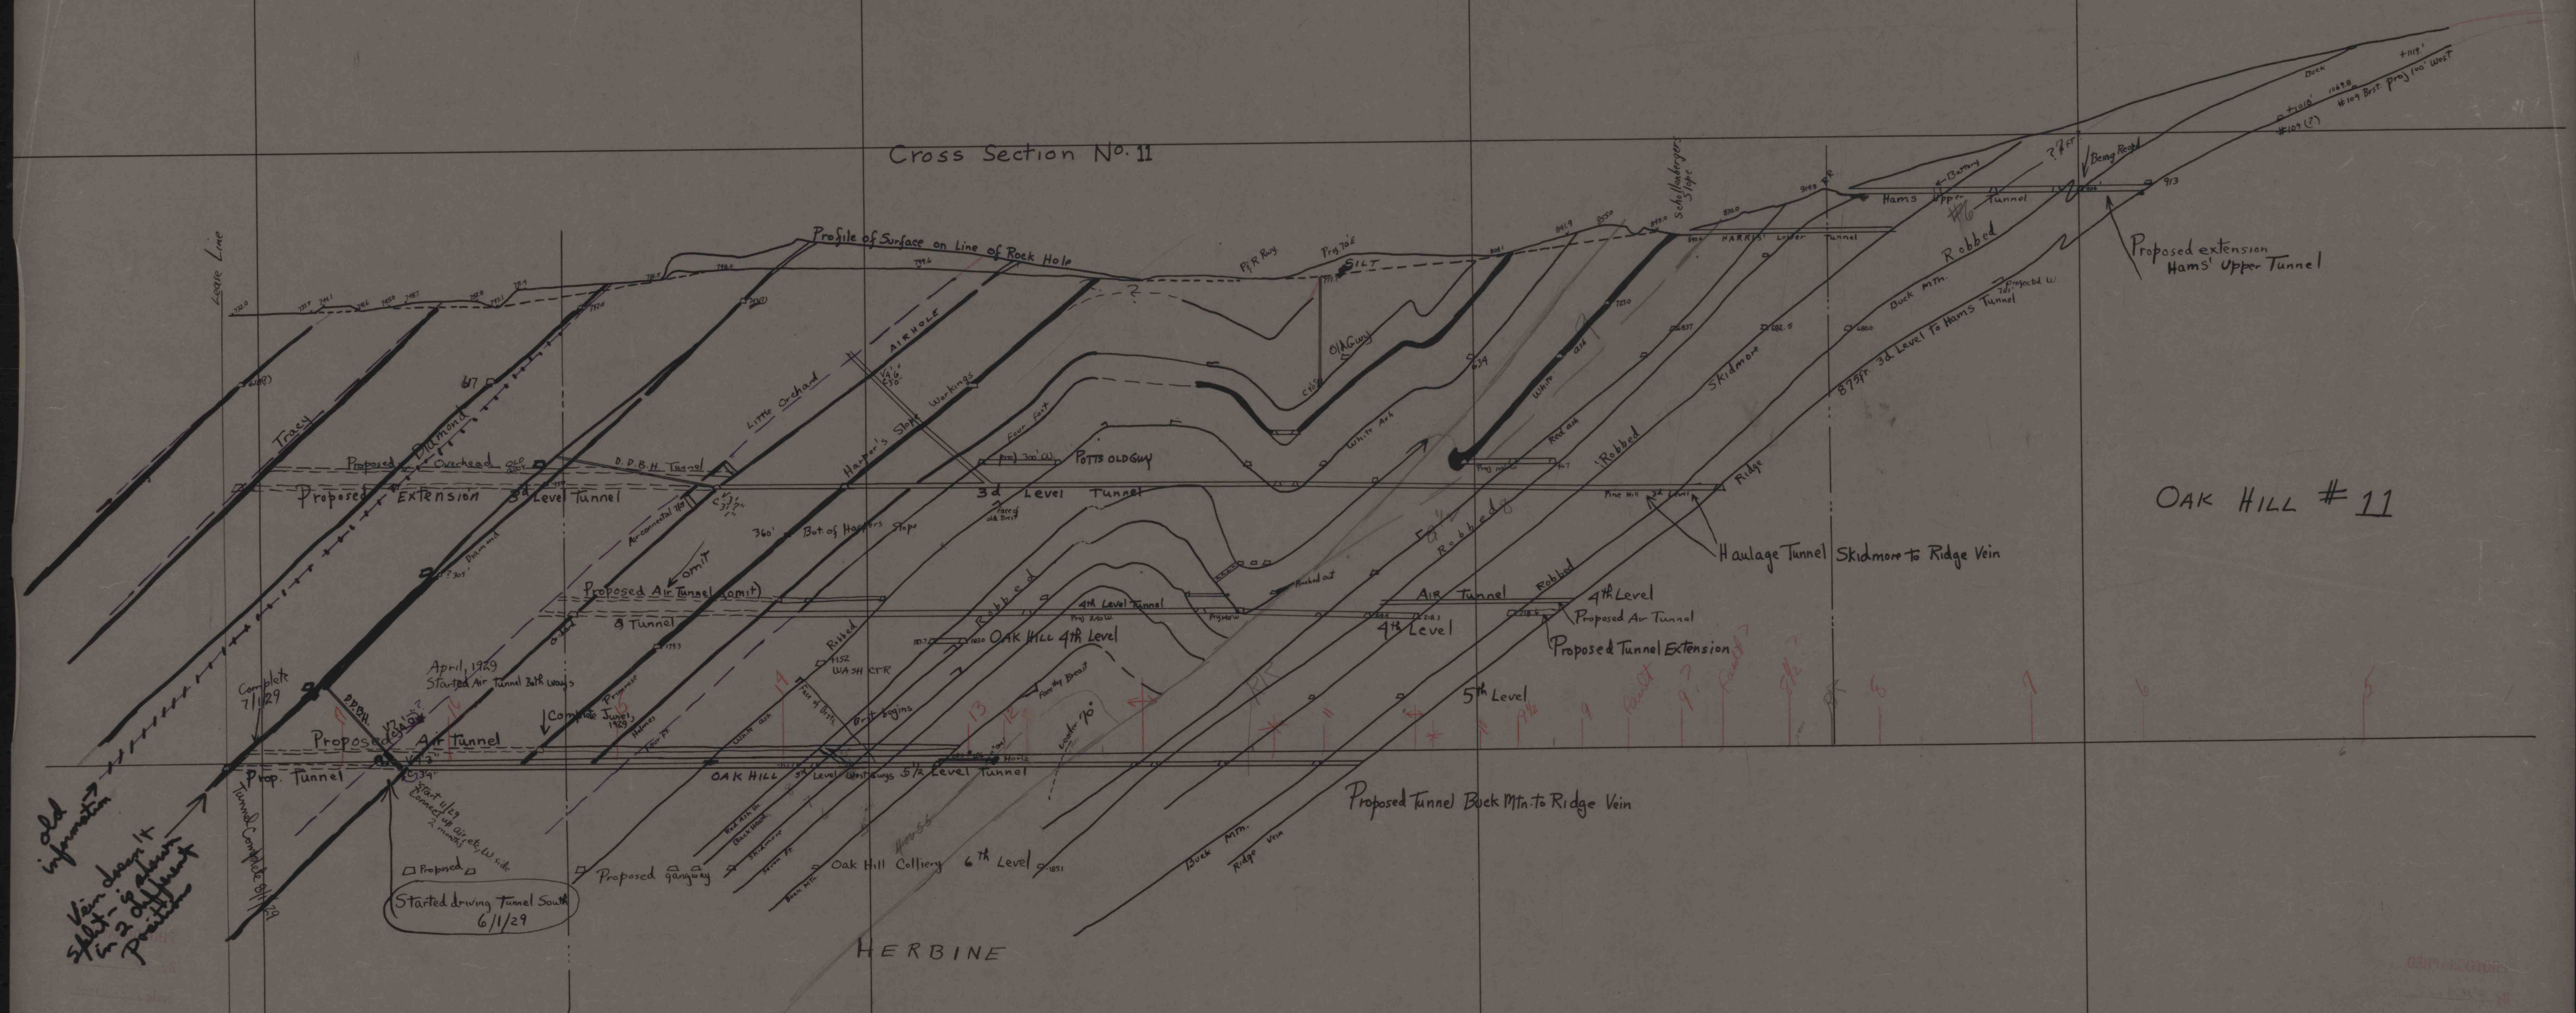

OAK HILL # 11

Oak Hill #11

OAK HILL # 11

COPIED BY TREXLER