


DAM 26" THICK
HITCH 1-6" DEEP
7000 BRICKS
70 BAGS CEMENT
4 TONS SAND

510.5 ELE OVERCAST + 280 HUB-
481.0 " RAIL
27.5 HEAD

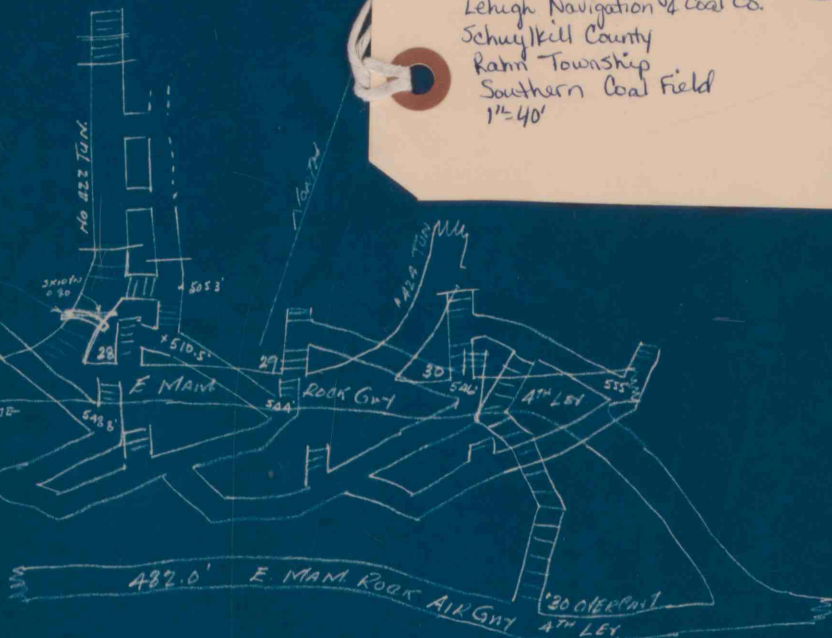

PLAN SHOWING LOCATION OF DAM
IN "422 TUN 4TH LEVEL" "E MAIN"
COALDALE COLLIERY
SCALE 1" = 40'

Coal Dale Colliery
Lehigh Navigation & Coal Co.
Schuylkill County
Rahn Township
Southern Coal Field
1" = 40'

(4321)