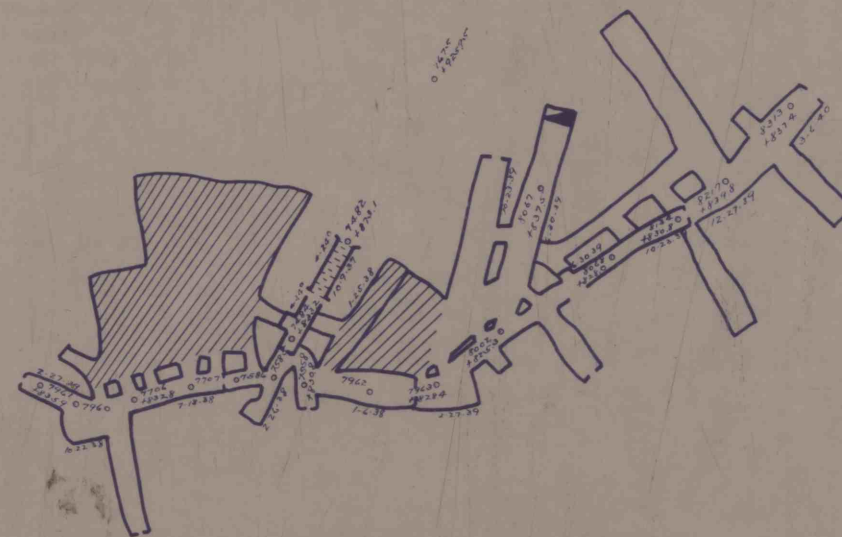
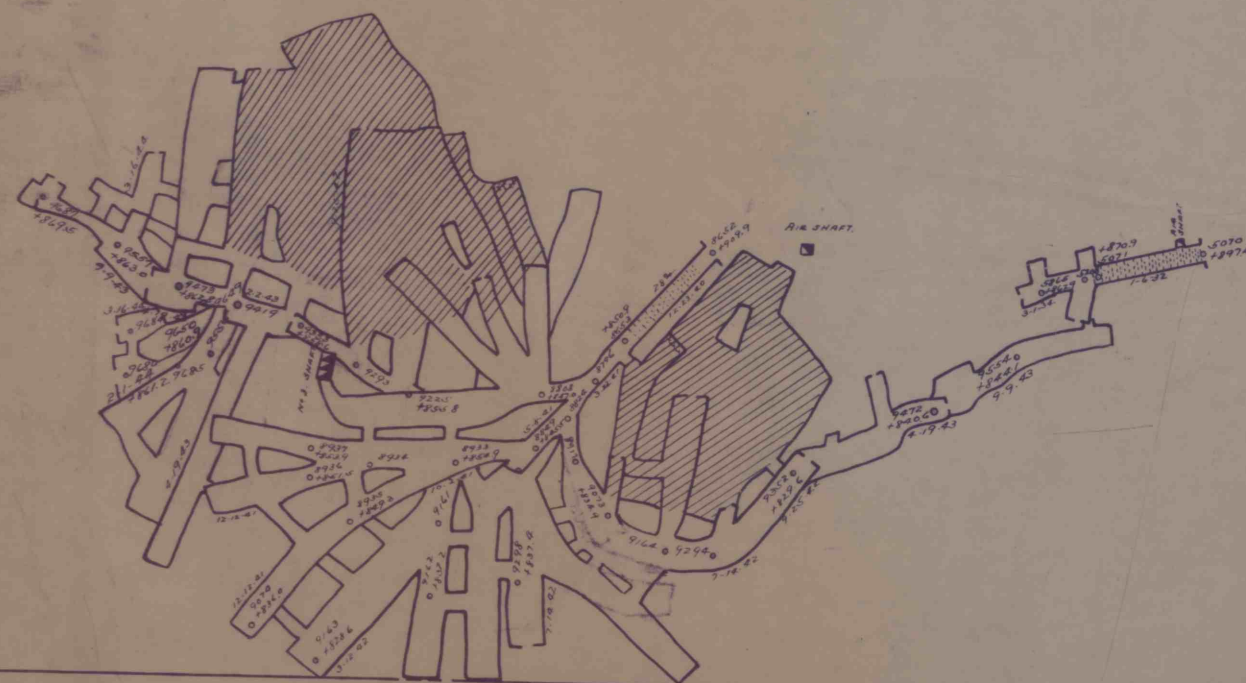


ENKULENKO'S RIDER VEIN.