


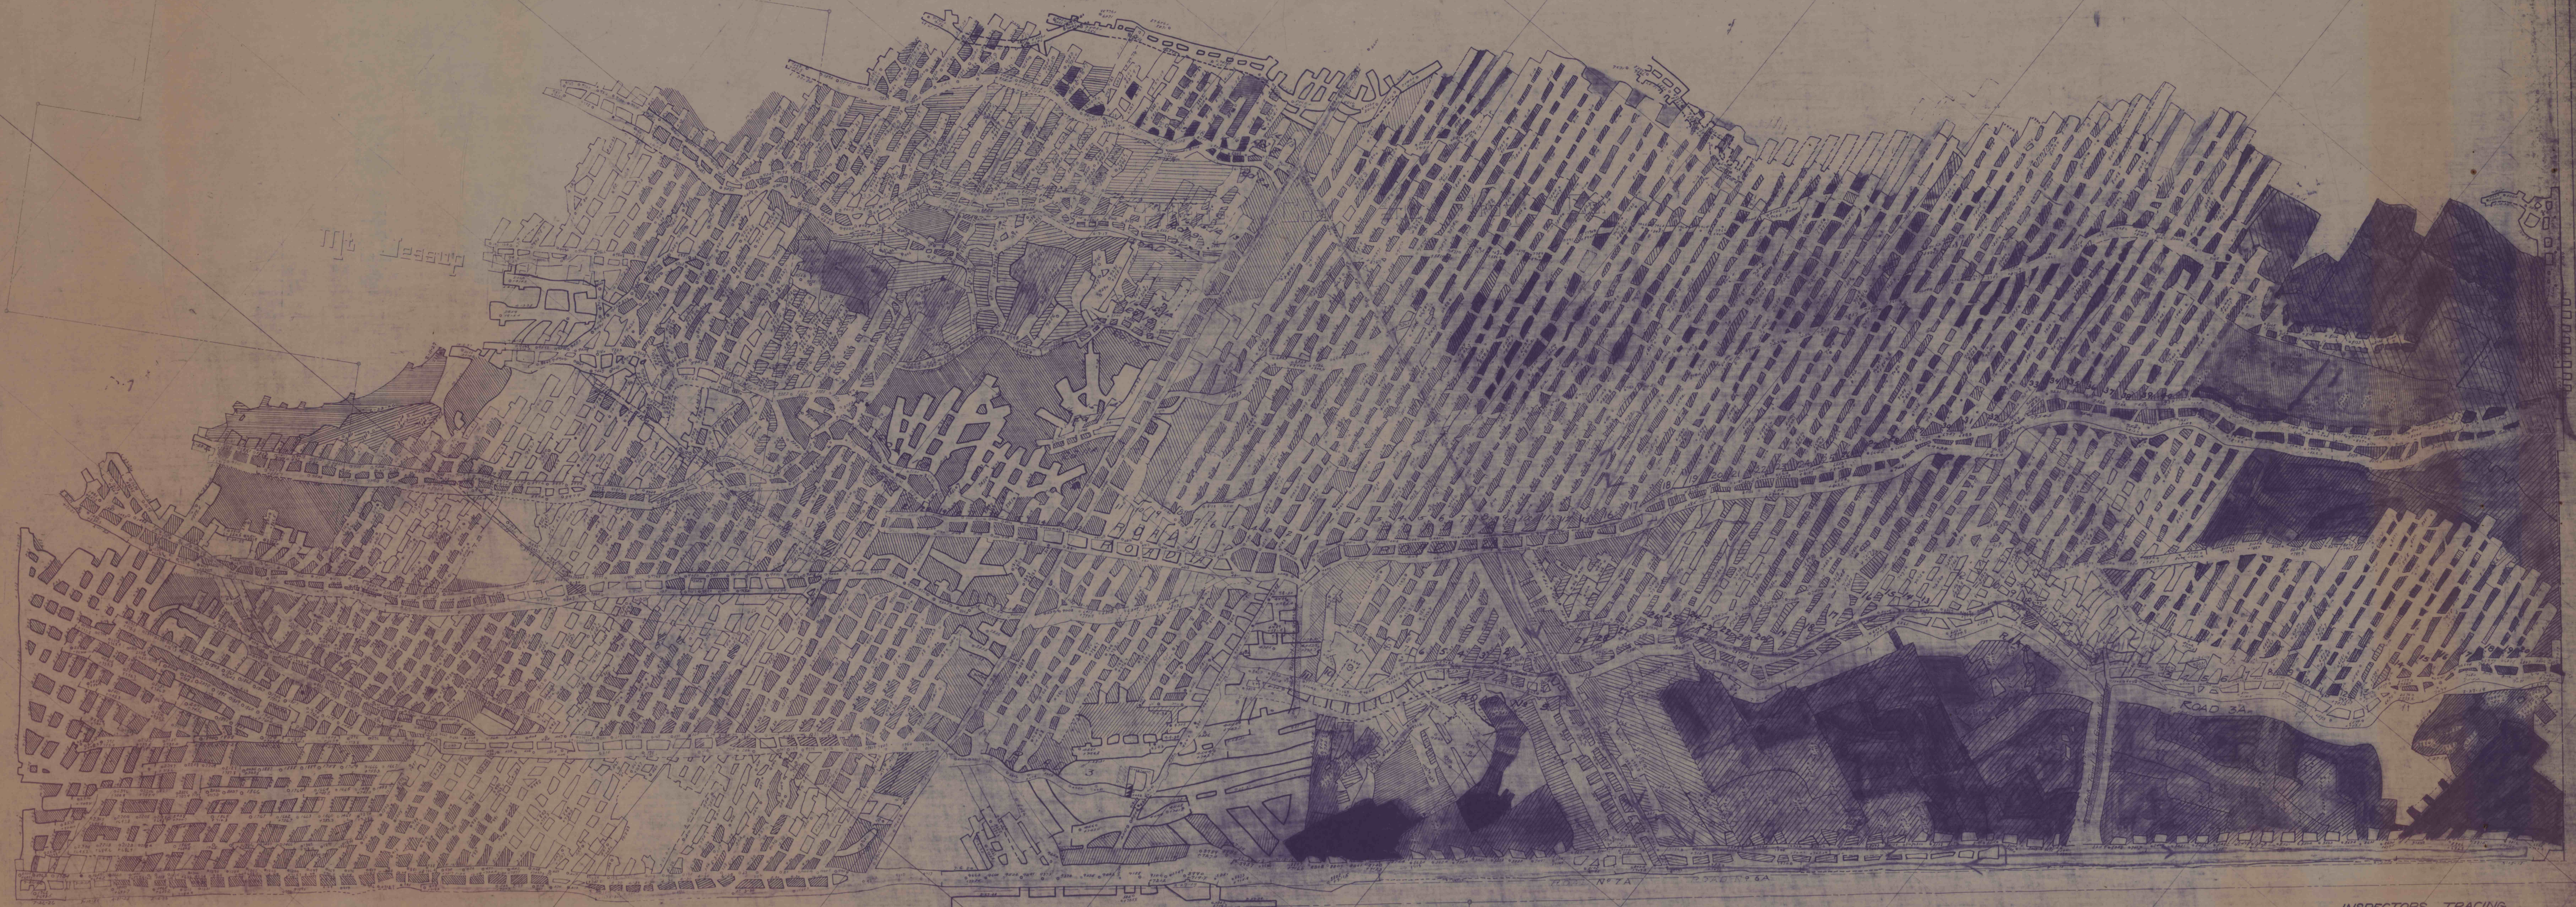

M. Jessup Coal Co.

Delaware and Hudson

INSPECTORS TRACING
ST. CREEK NEW COUNTY VEIN