


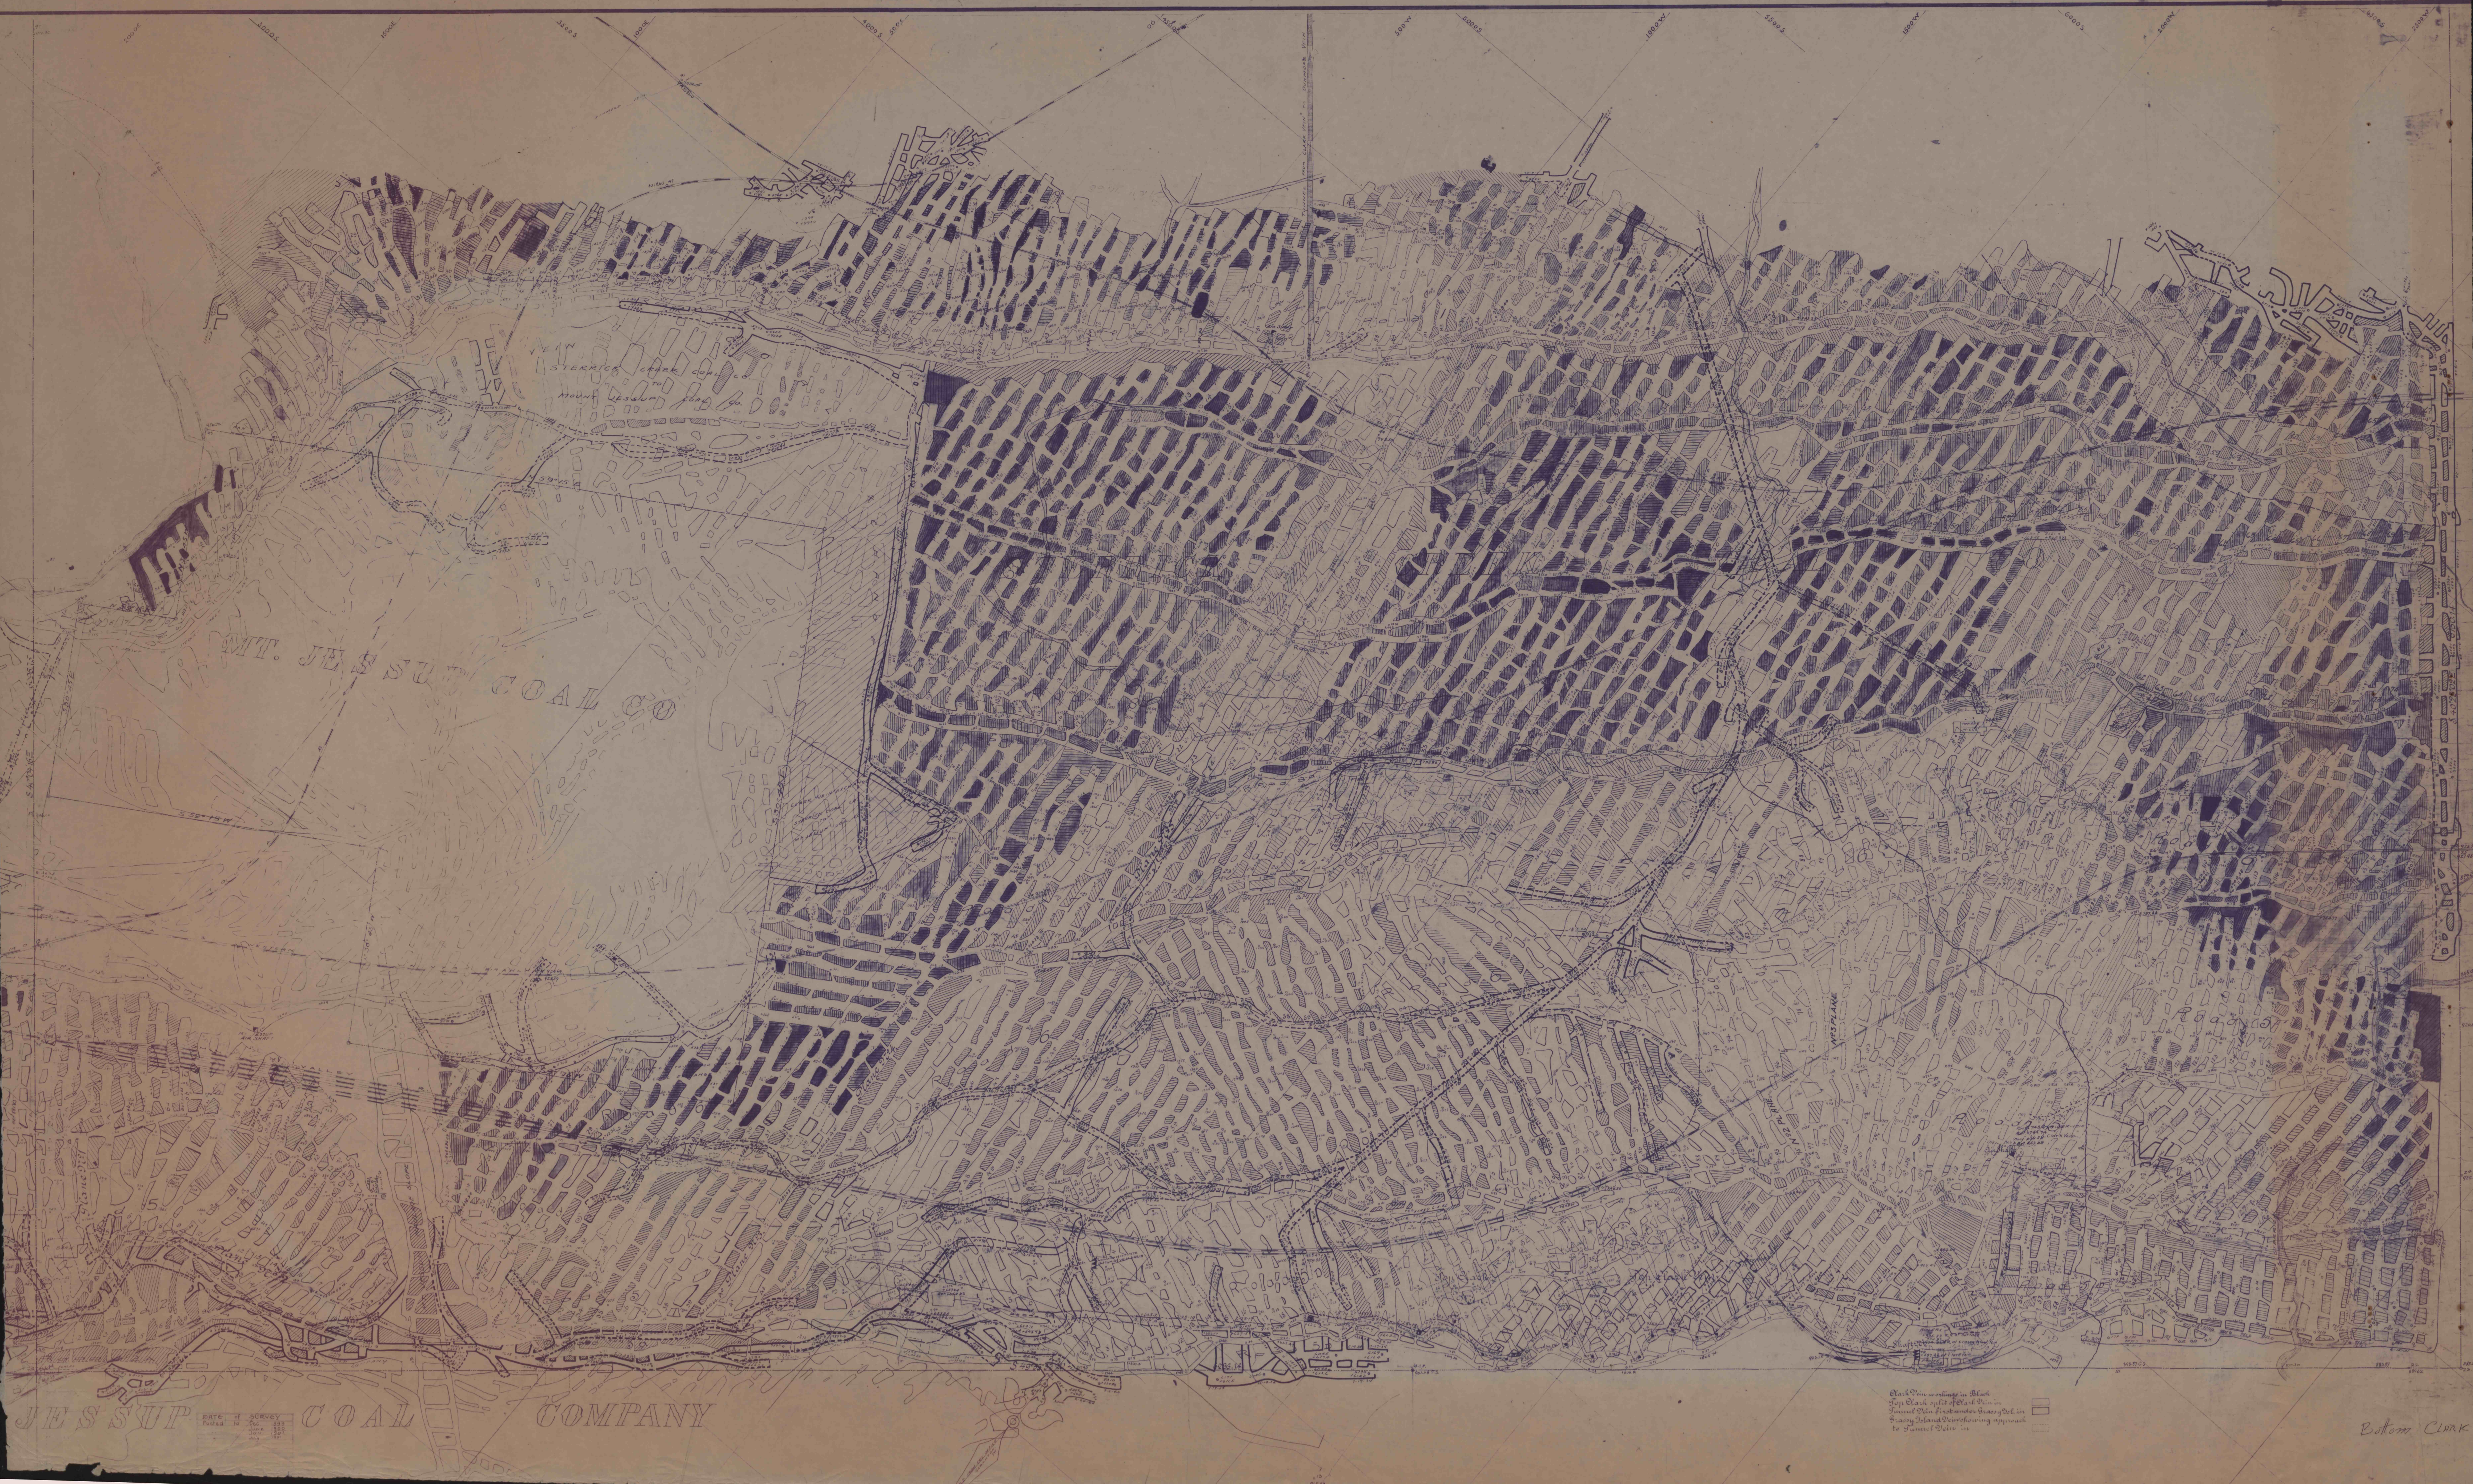

Black line workings in Black

Bottom Clark