


STERRICK CREEK NO. 1 DUNMORE.
MINE INSPECTOR'S TRACING.

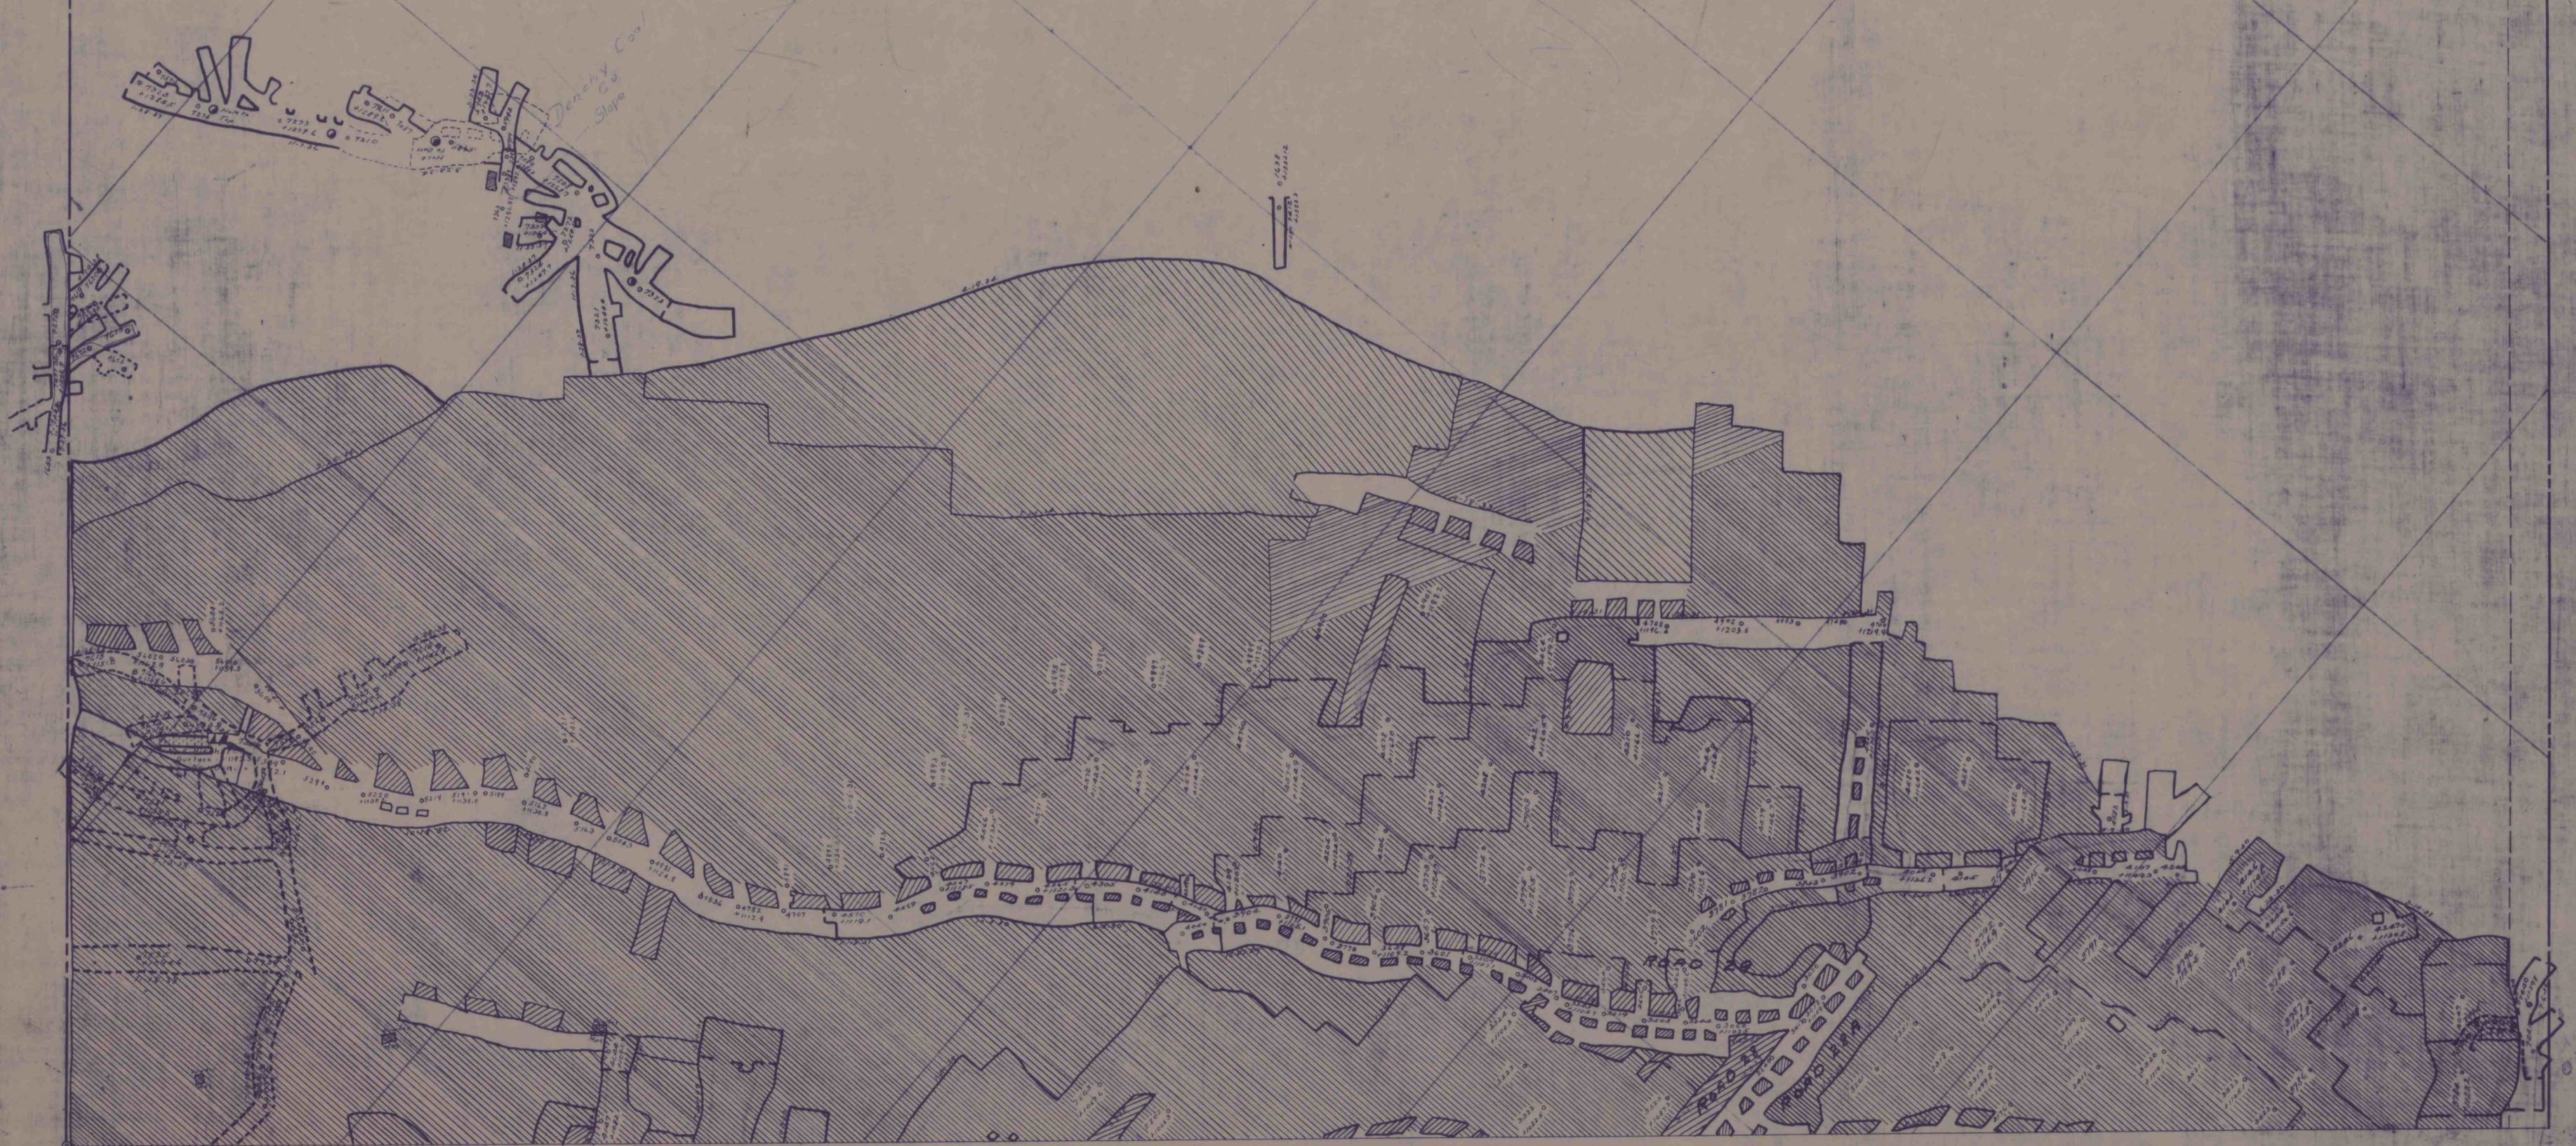

MATCH TRACING ON THIS LINE

No 1 Dunm