


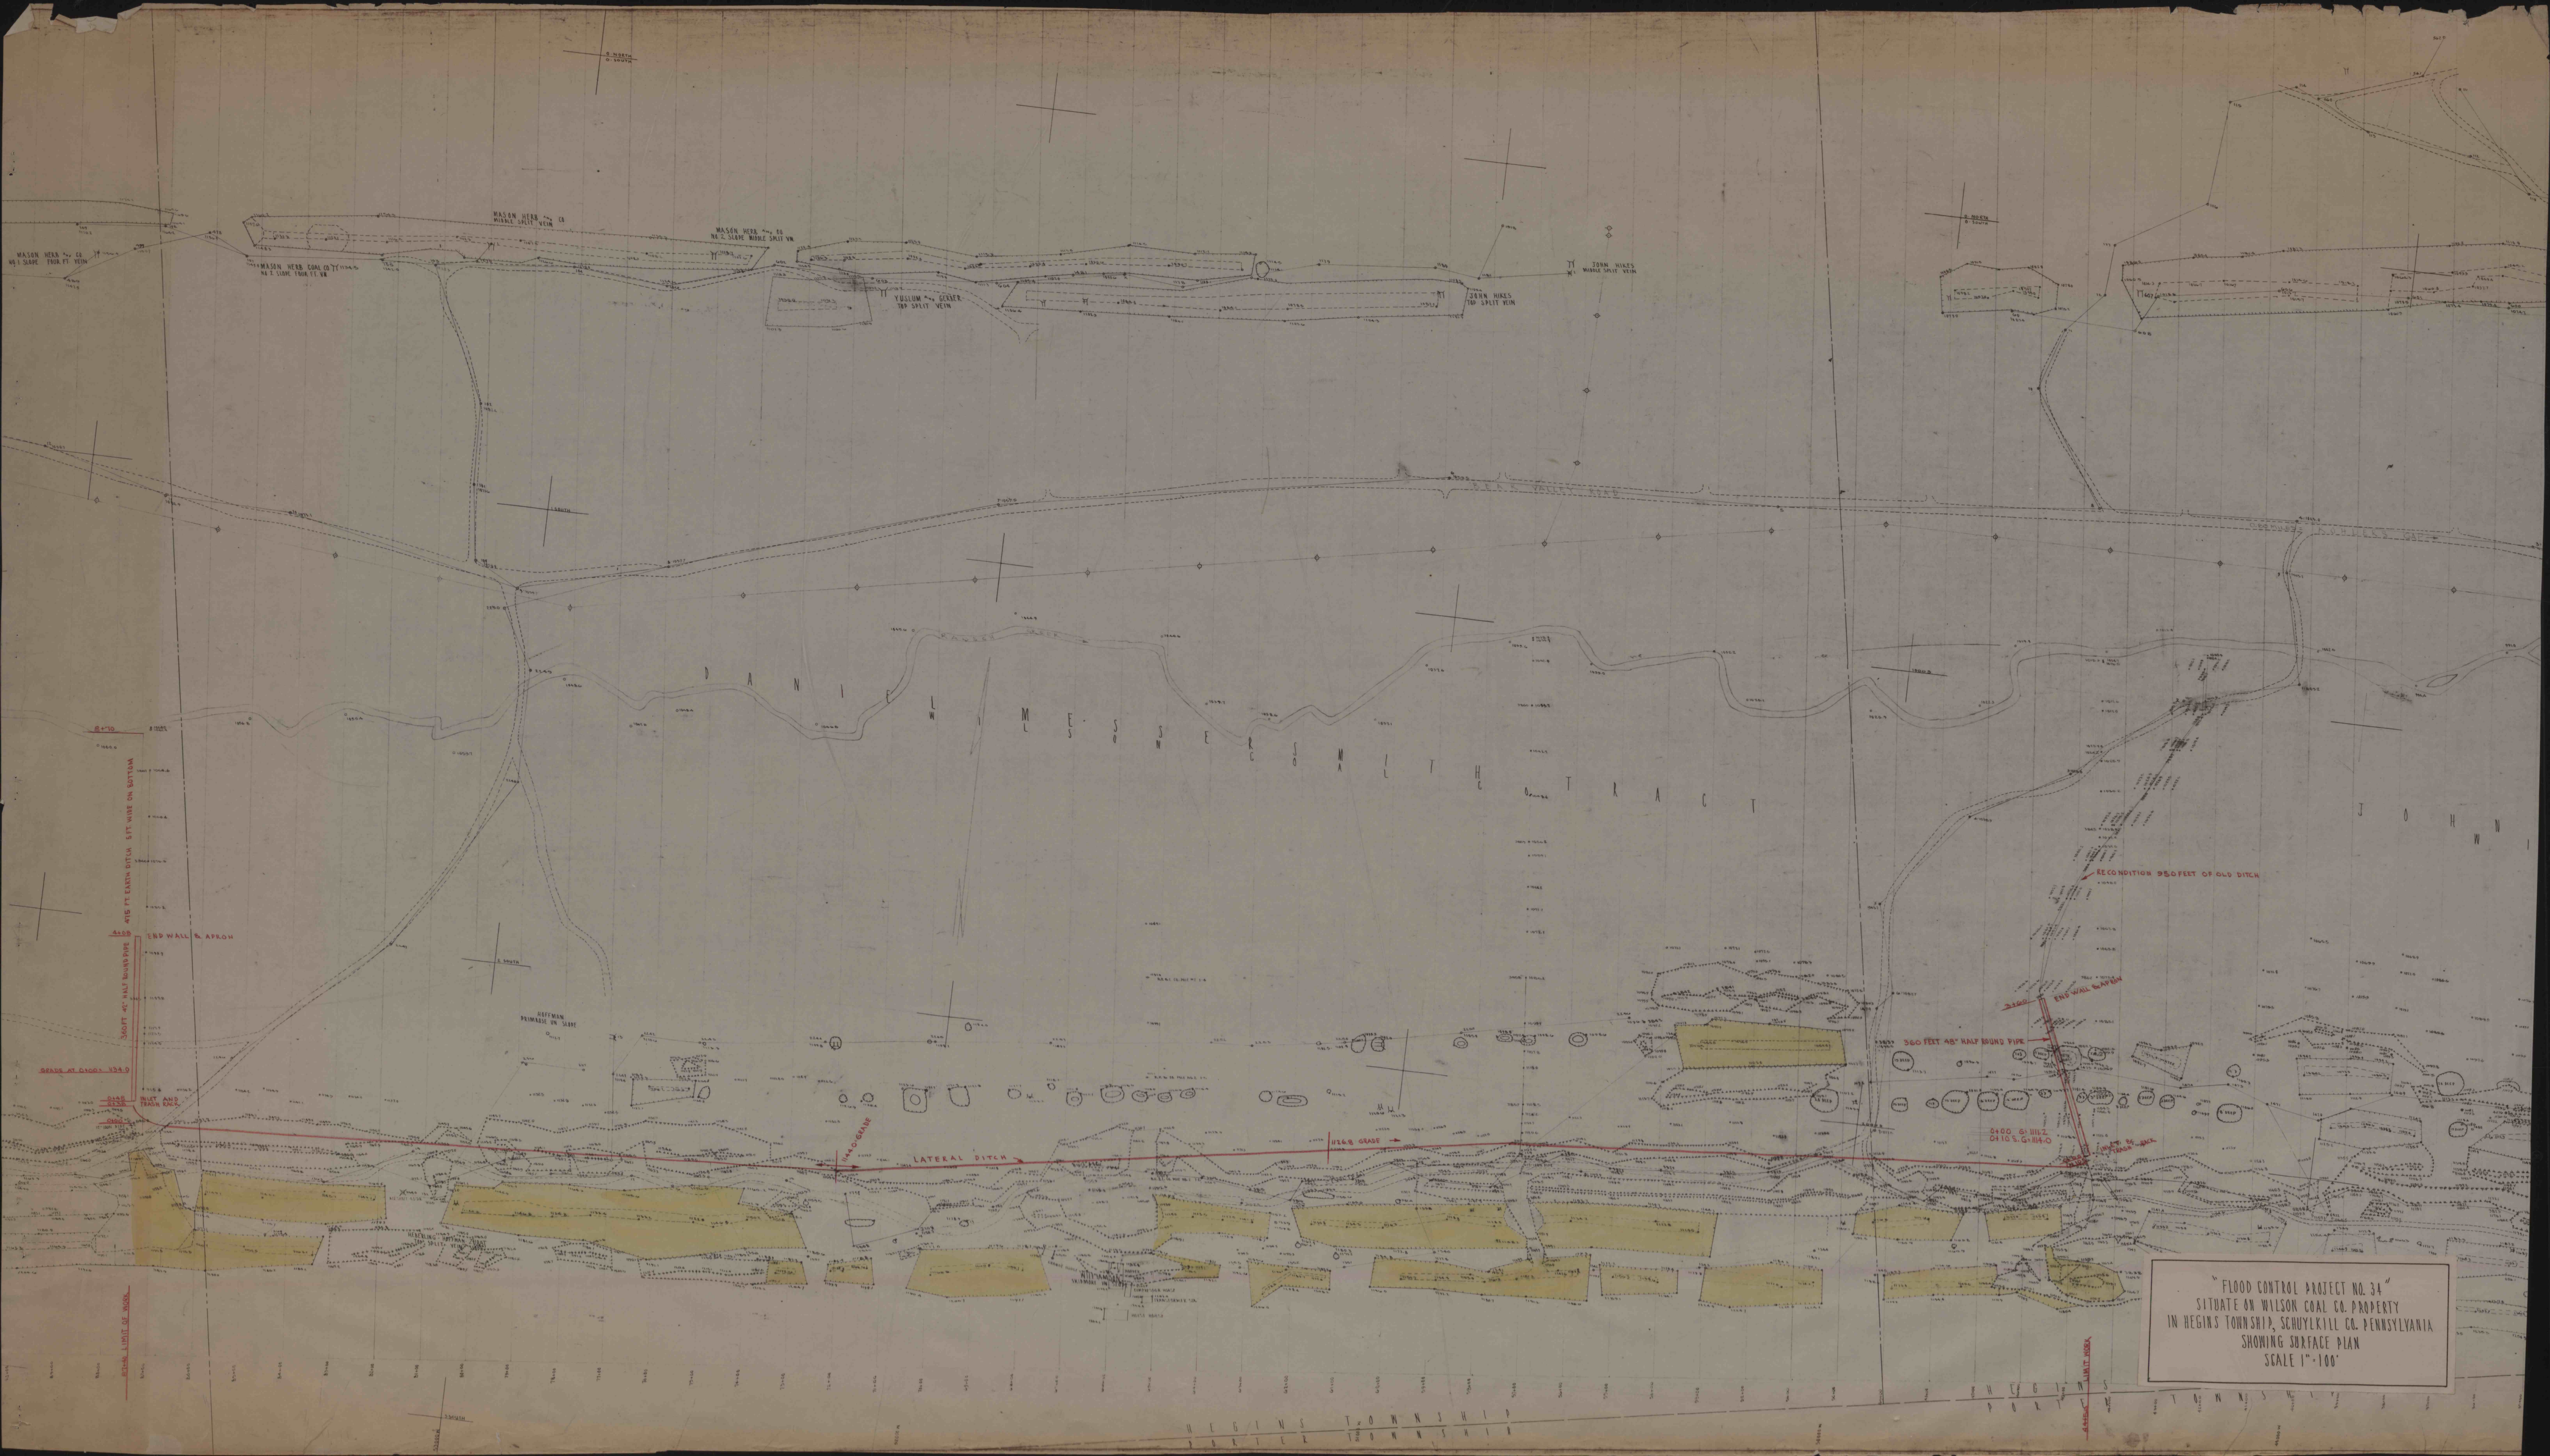

"FLOOD CONTROL PROJECT NO. 34"
SITUATE ON WILSON COAL CO. PROPERTY
IN HEGIN'S TOWNSHIP, SCHUYLKILL CO., PENNSYLVANIA
SHOWING SURFACE PLAN
SCALE 1"=100'