


Dun No 3

Dun No 3

Surface
12 maps

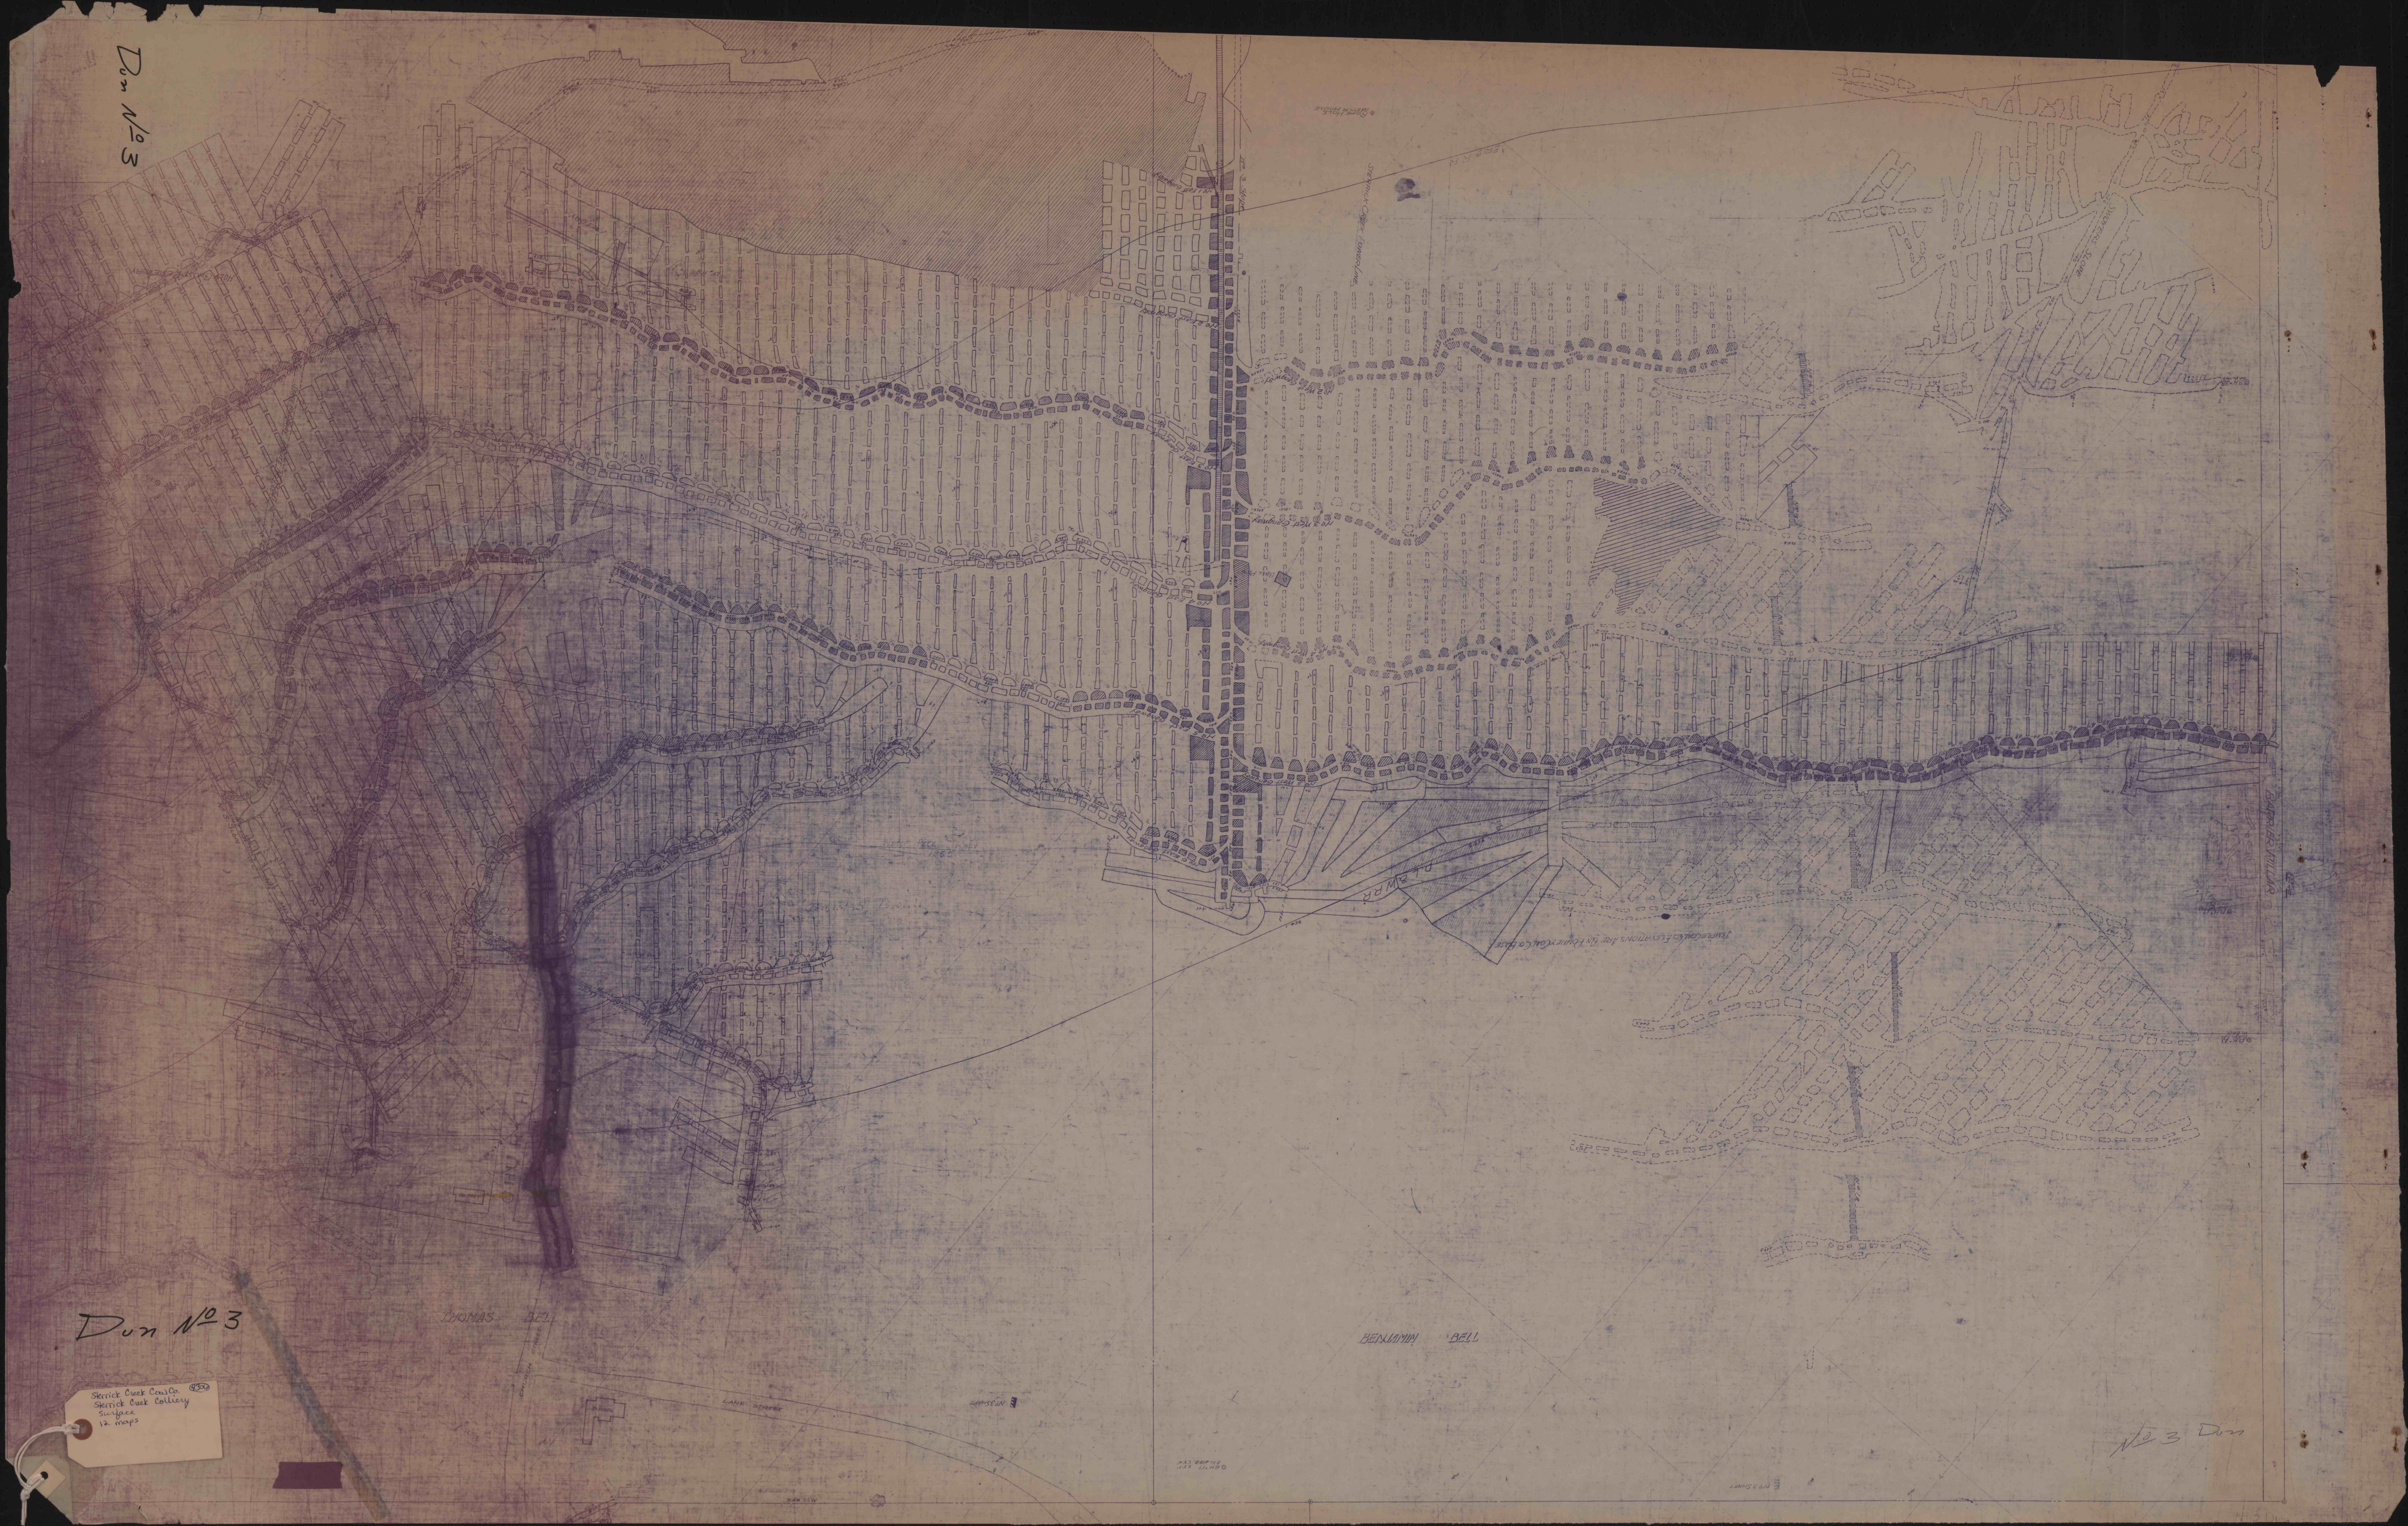

No 3 Dun