



E. ROUGHT TRACT.

NEW COUNTY VN.
Scale 1"=100'

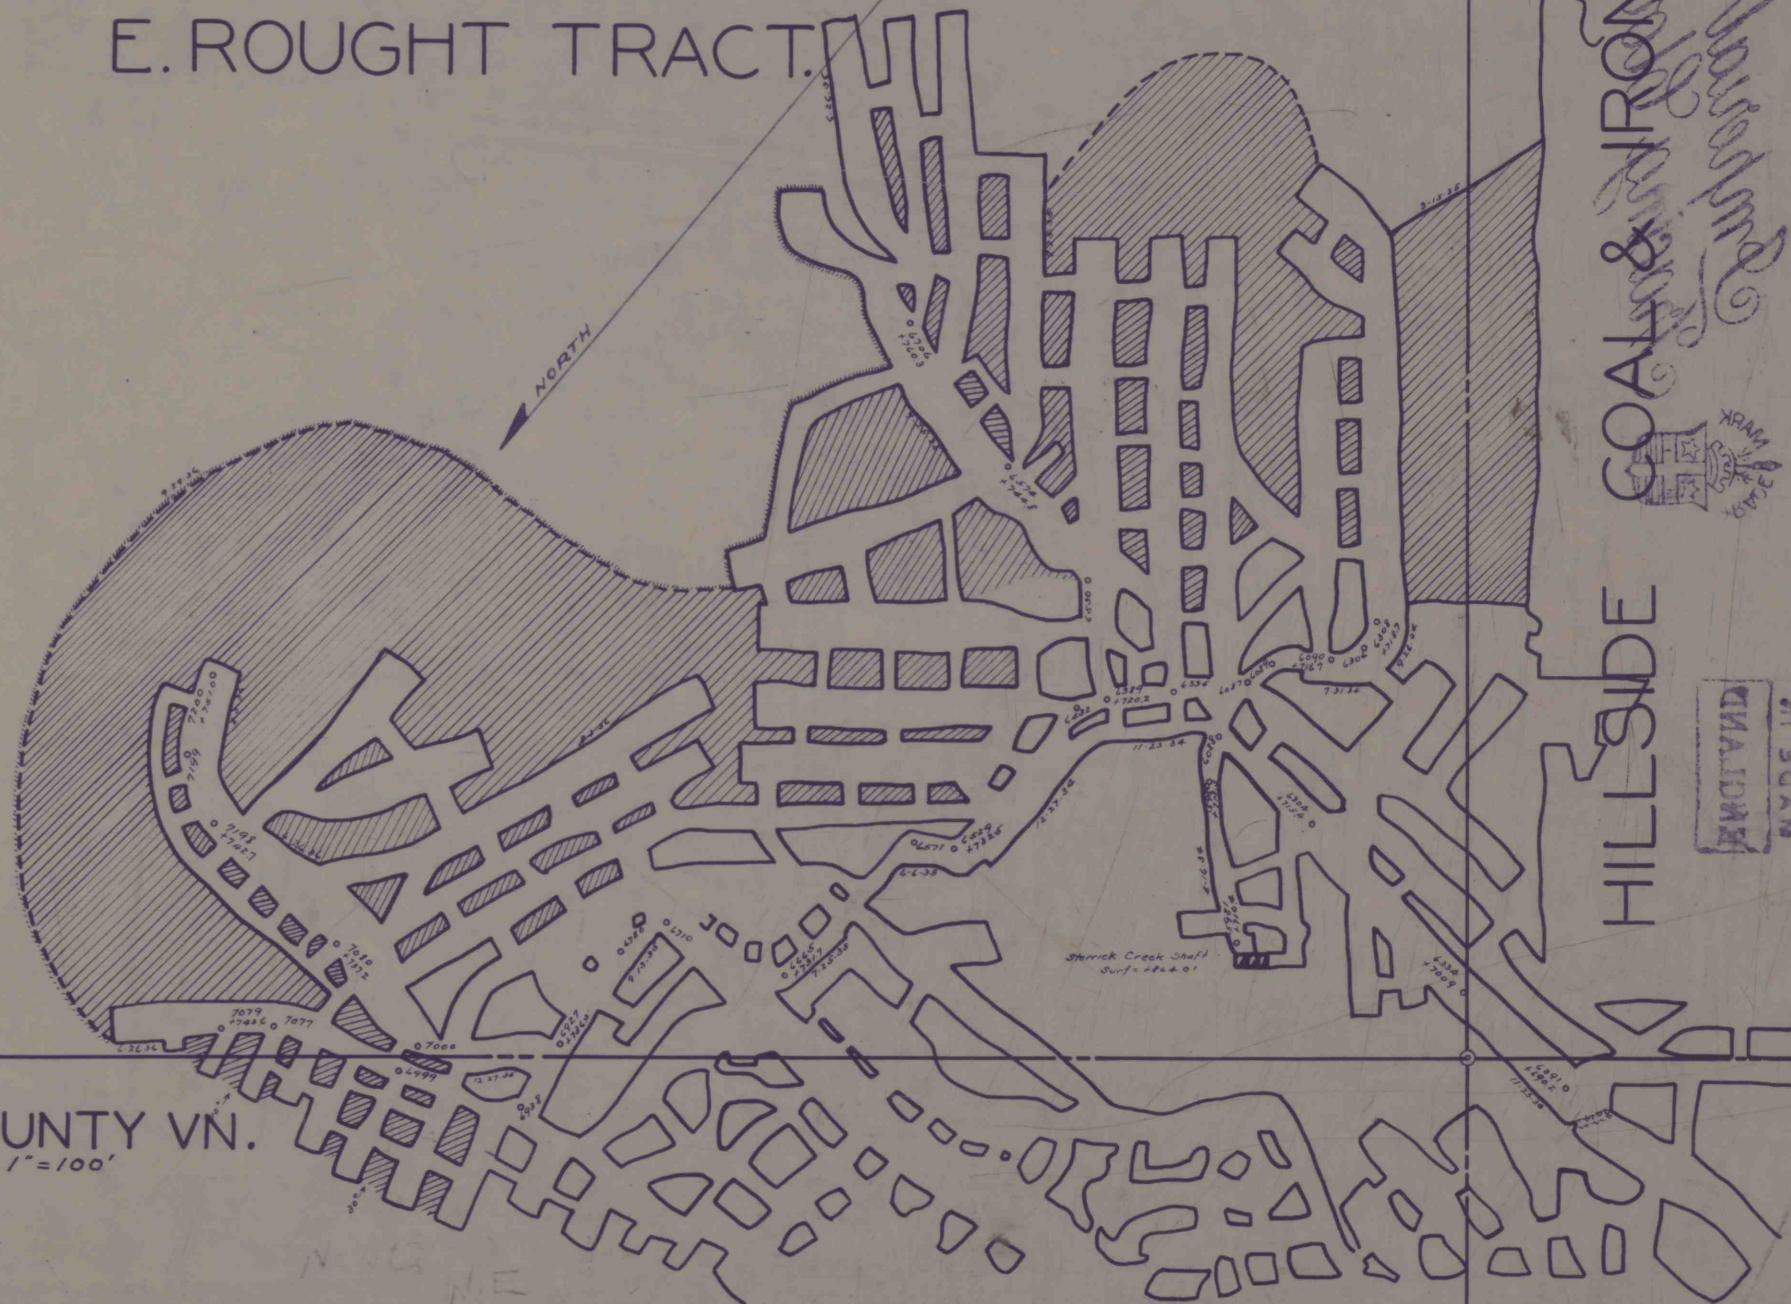

HILLSIDE

COAL & IRON CO.

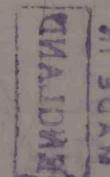

