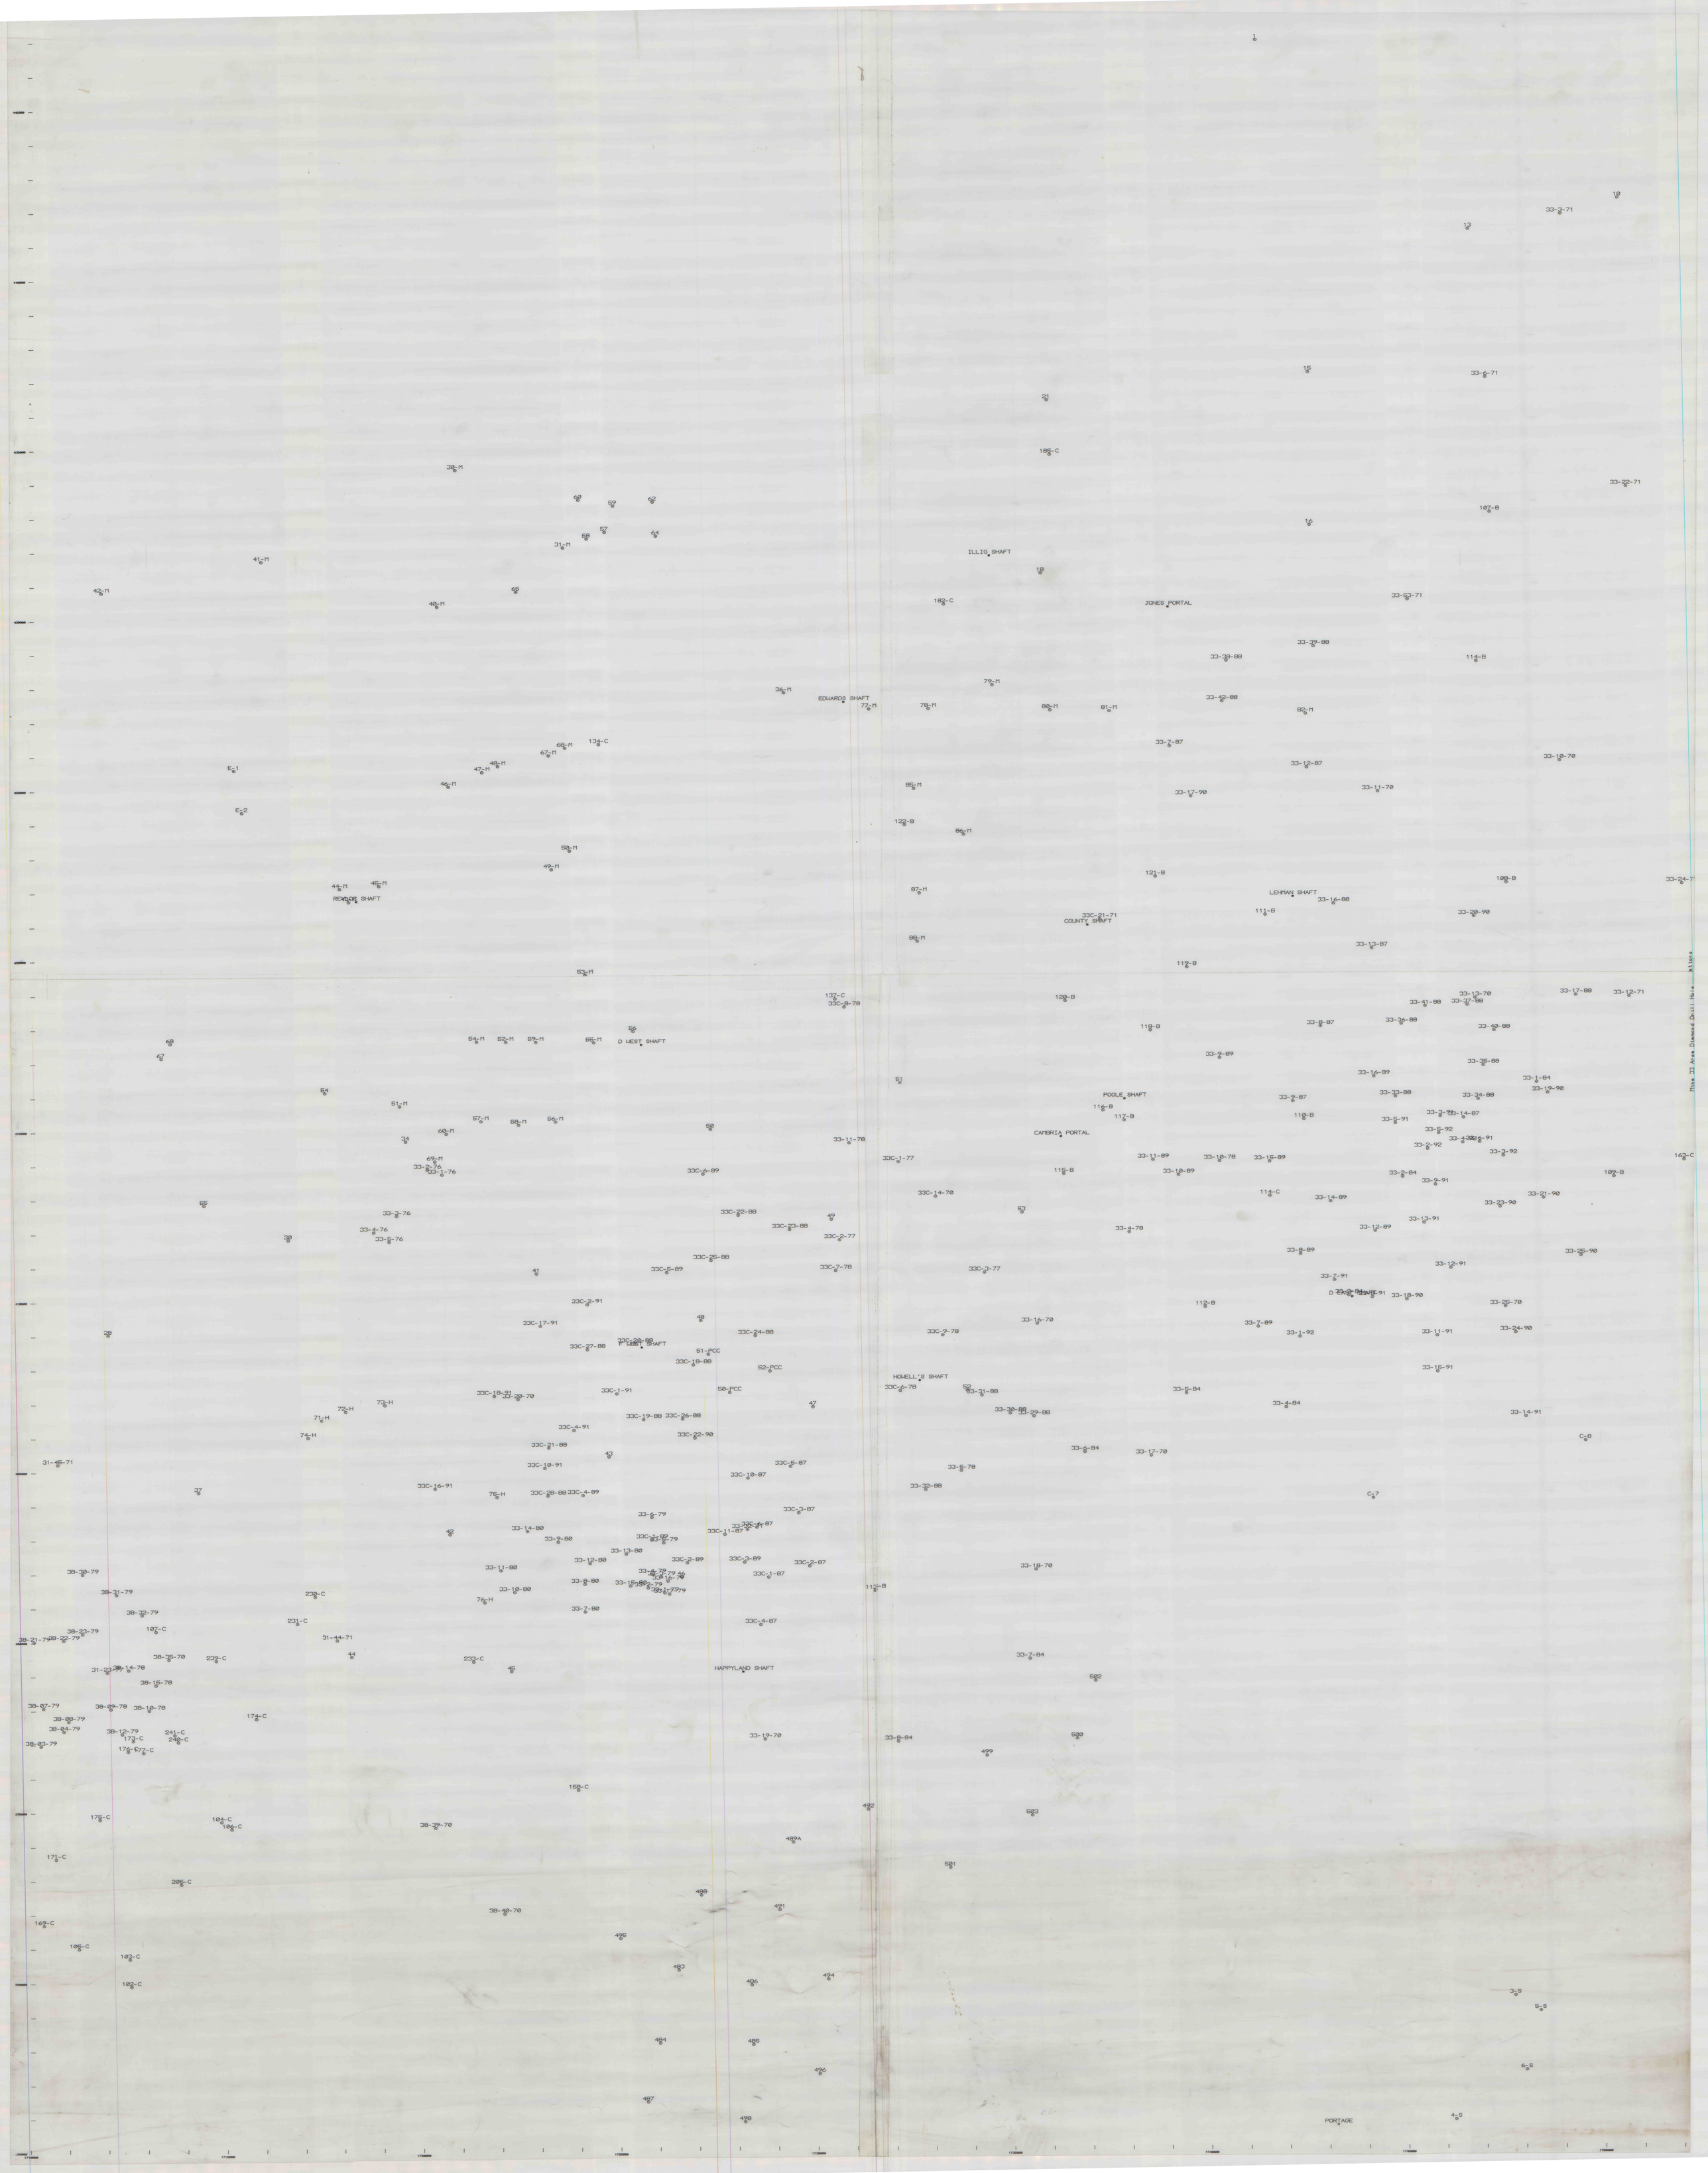
ILLIG SHAFT
JONES PORTAL
EDWARDS SHAFT
REAVLOR SHAFT
D WEST SHAFT
F WEST SHAFT
LEHMAN SHAFT
COUNTY SHAFT
POOLE SHAFT
CAMBRIA PORTAL
HOWELL'S SHAFT
HAPPYLAND SHAFT
PORTAGE
Mine 33 Area Diamond Drill Hole Collars