


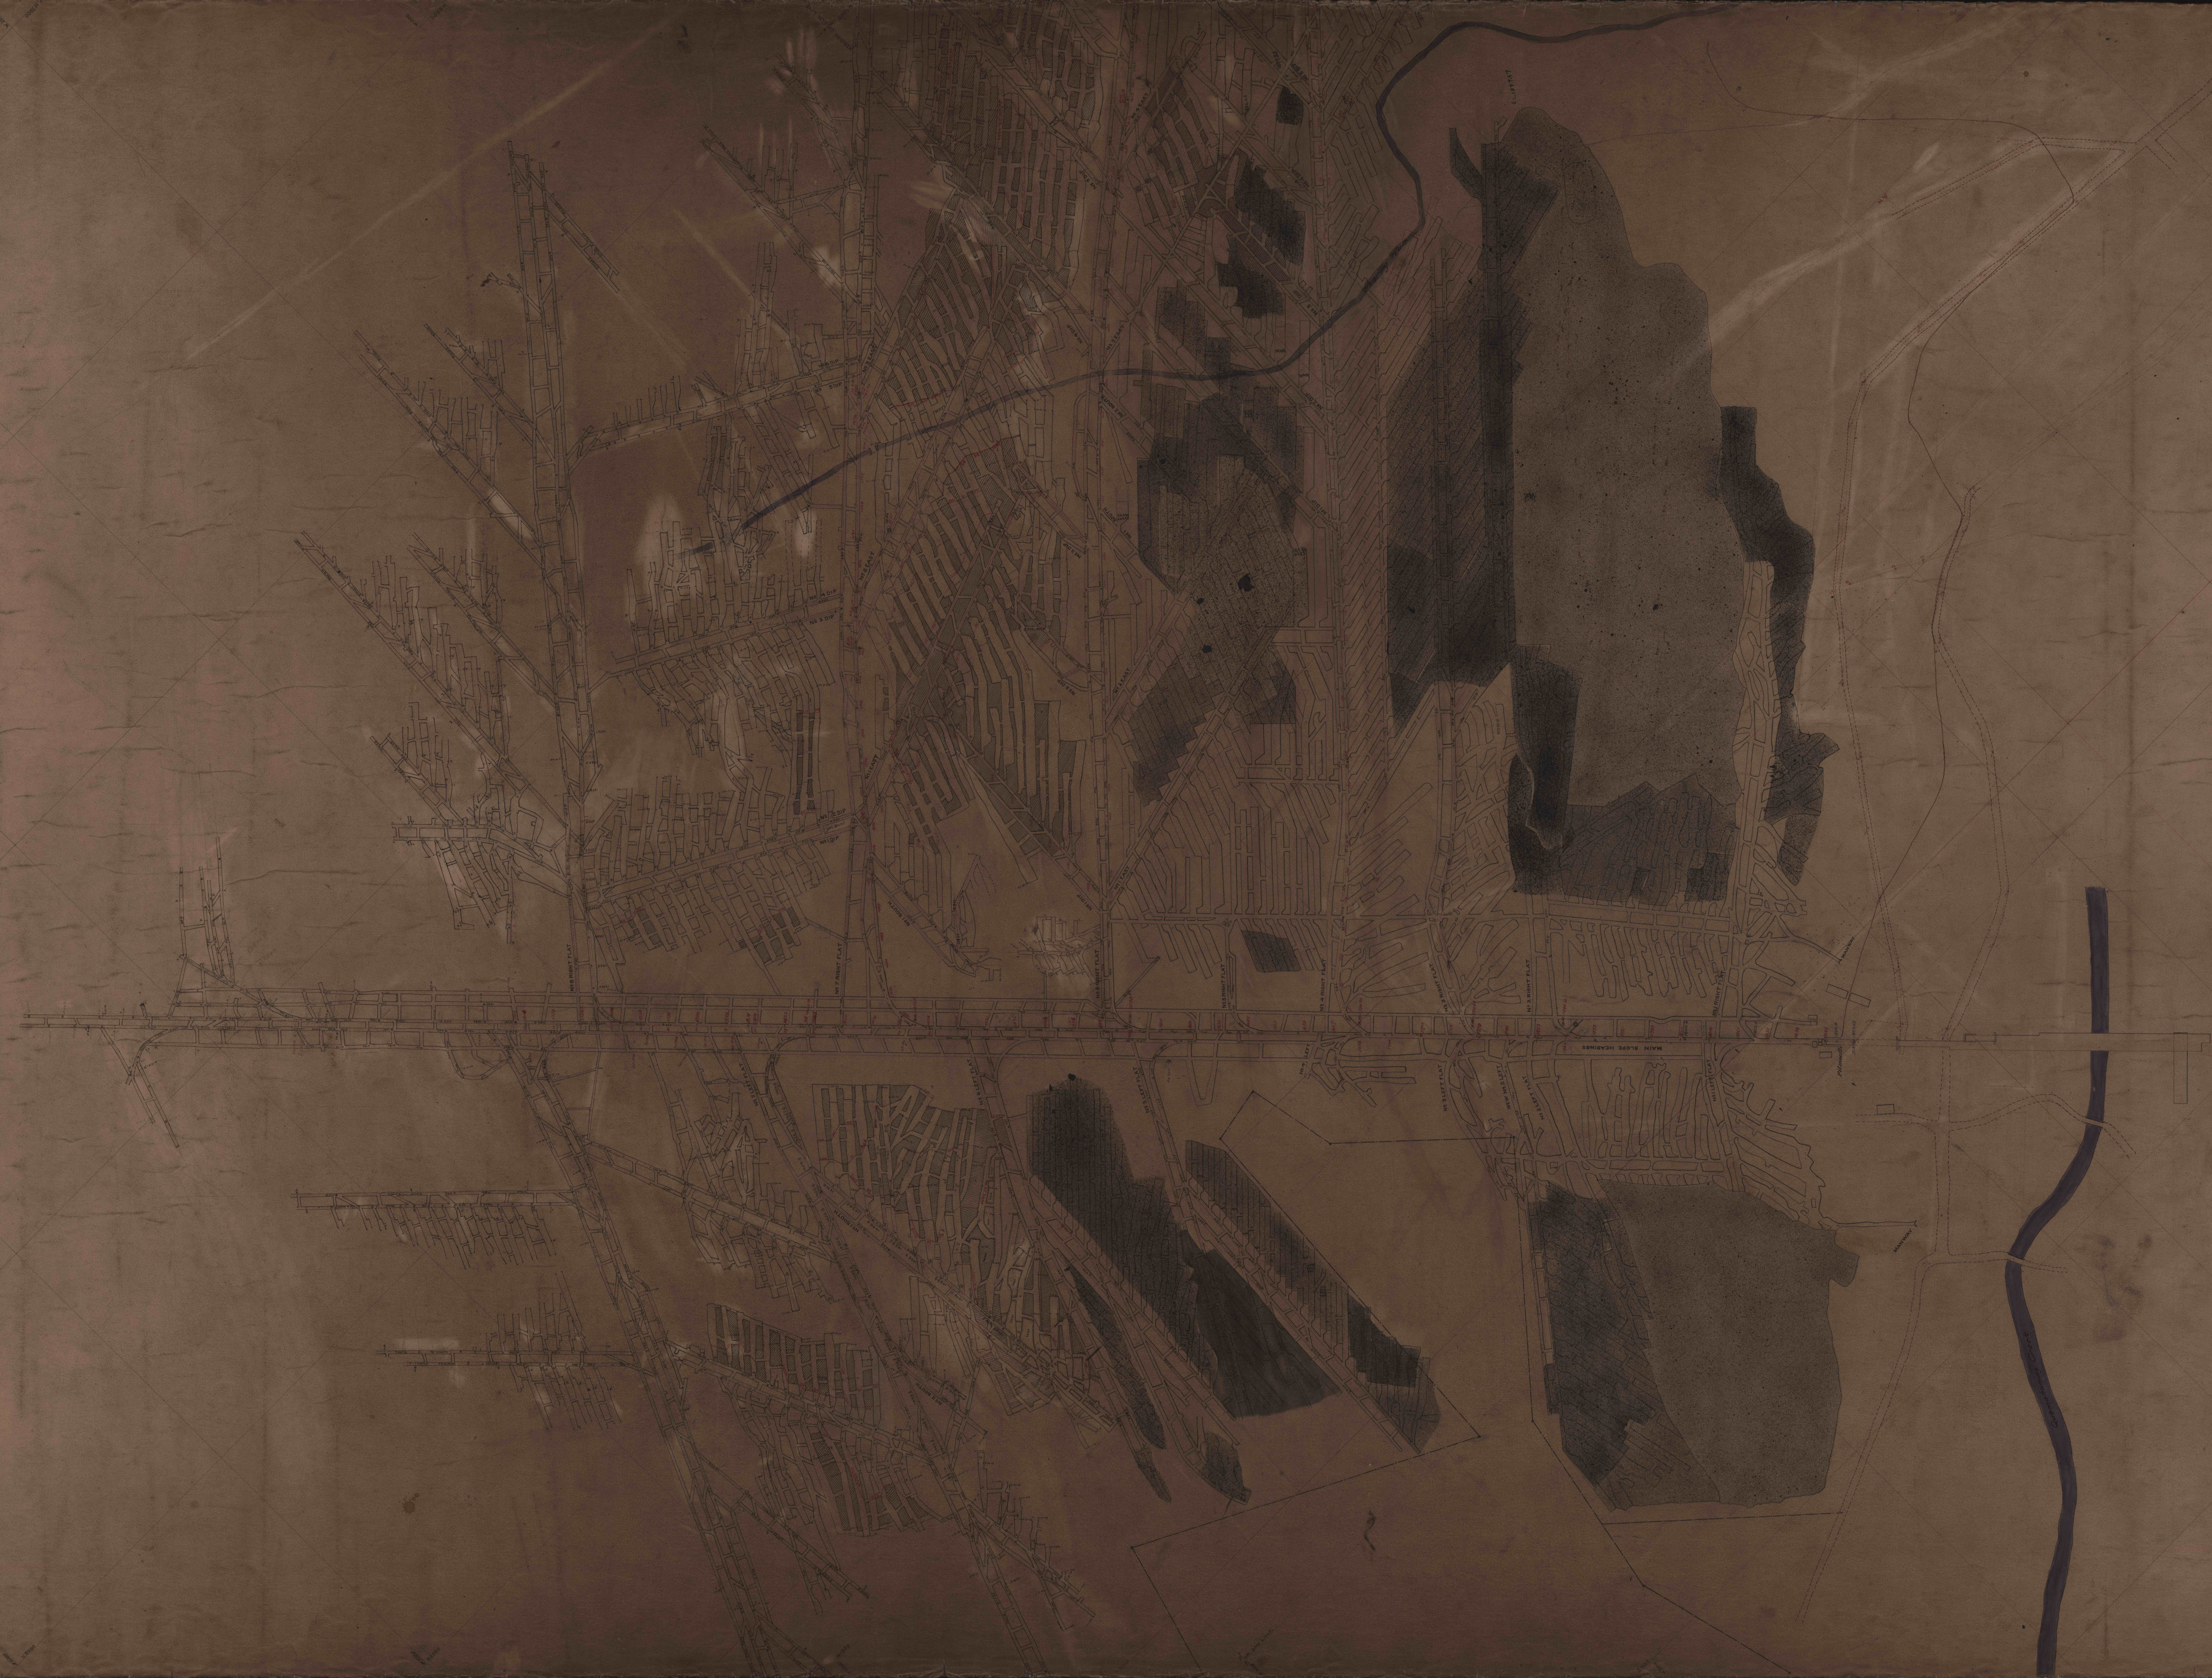

C. SEAM
