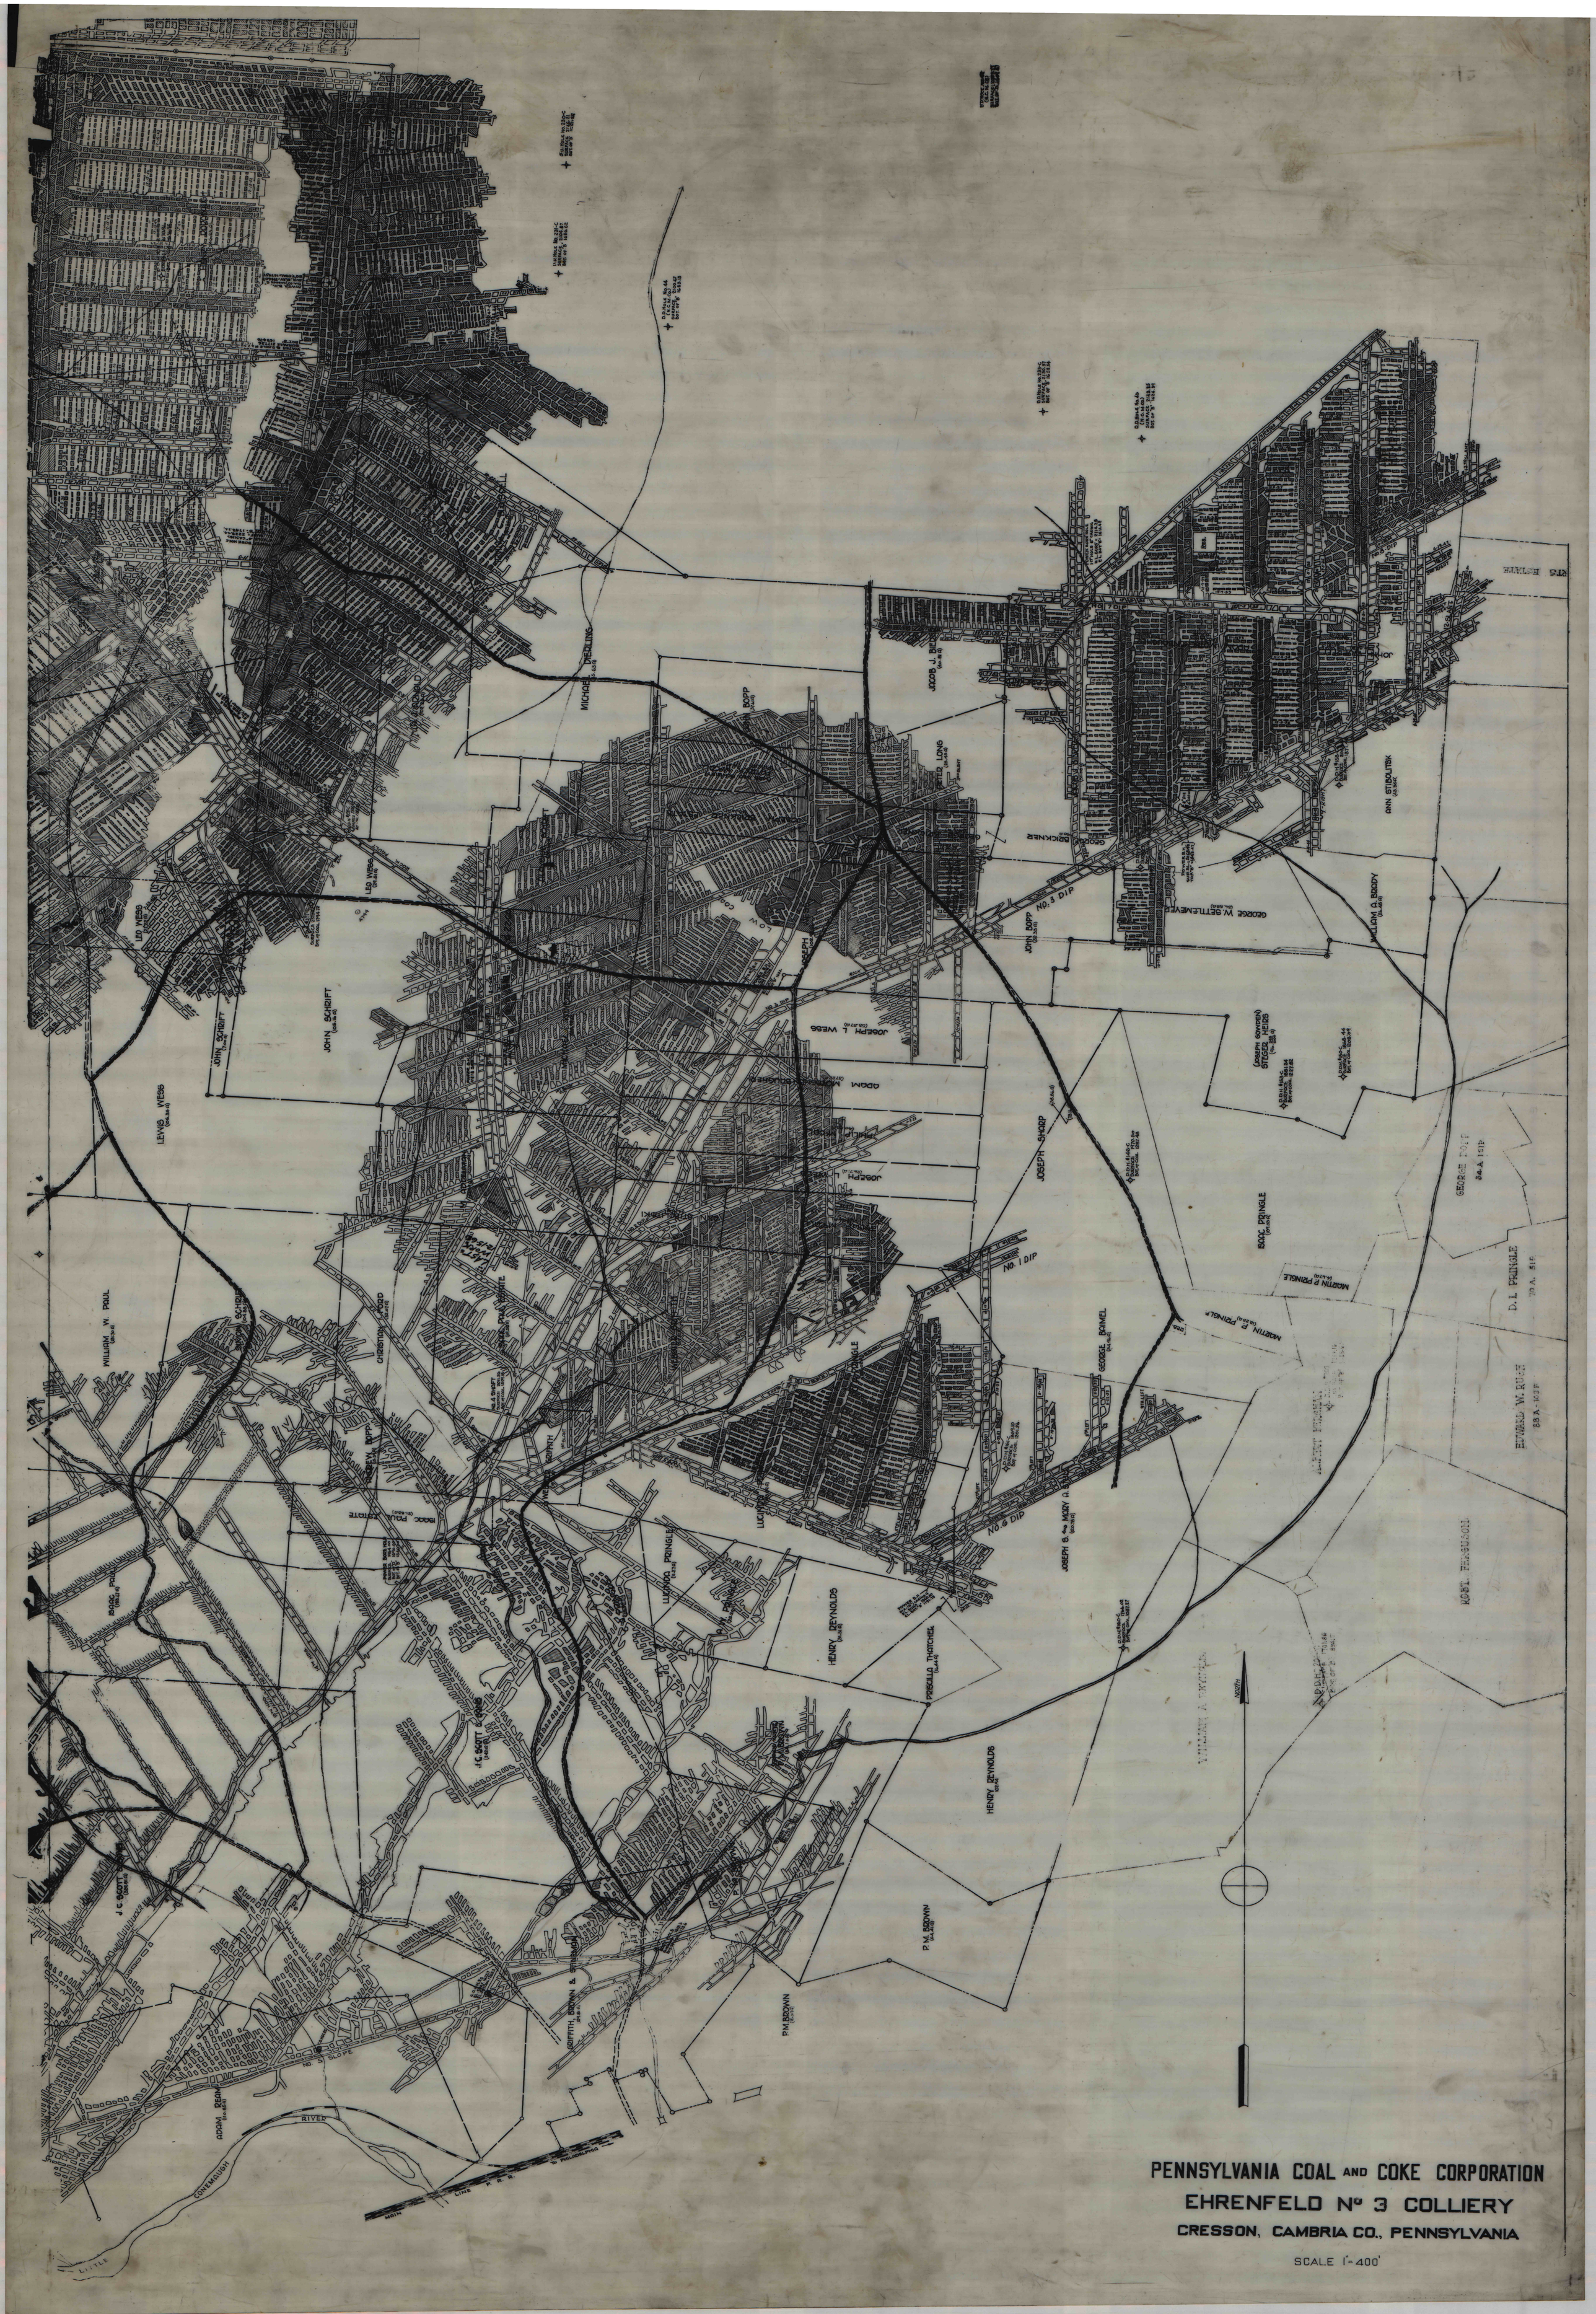
PENNSYLVANIA COAL AND COKE CORPORATION
EHRENFELD Nº 3 COLLIERY
CRESSON, CAMBRIA CO., PENNSYLVANIA
SCALE 1"=400'
NORTH
CONEMAUGH RIVER
LITTLE
MAIN LINE P.R.R.
TO PHILADELPHIA
NO. 5 SLOPE
ADAM REAM
J.C. SCOTT
J.C. SCOTT & SONS
GRIFFITH, BROWN & SCHREMAN
P.M. BROWN
HENRY REYNOLDS
PRISCILLA THATCHER
JOSEPH G. MOORE
LUCINDA PRINGLE
ISAAC PRINGLE
ISAAC POLE ROTATE
REBECA ROPP
CHRISTIAN HOOD
WILLIAM W. PAUL
LEWIS WEBB
JOHN SCHRIFT
JOSEPH L. WEBB
ADAM MOSSER
JOSEPH L. WEBB
PHILIP ROPP
LEO WEBB
MICHAEL DIEDLING
JOHN ROPP
GEORGE PRICKNER
PETER LONG
JACOB J. BIERER
JOSEPH SHARP
NO. 1 DIP
NO. 6 DIP
NO. 3 DIP
GEORGE BAIMEL
MARTIN P. PRINGLE
ISAAC PRINGLE
GEORGE W. SETTLEMEYER
WILLIAM A. BRADY
ANN STIBOLTSKI
JOSEPH SNYDER
STEGER HEIRS
GEORGE ROPP
D.L. PRINGLE
EDWARD W. RUGH
ROBT. FERGUSON