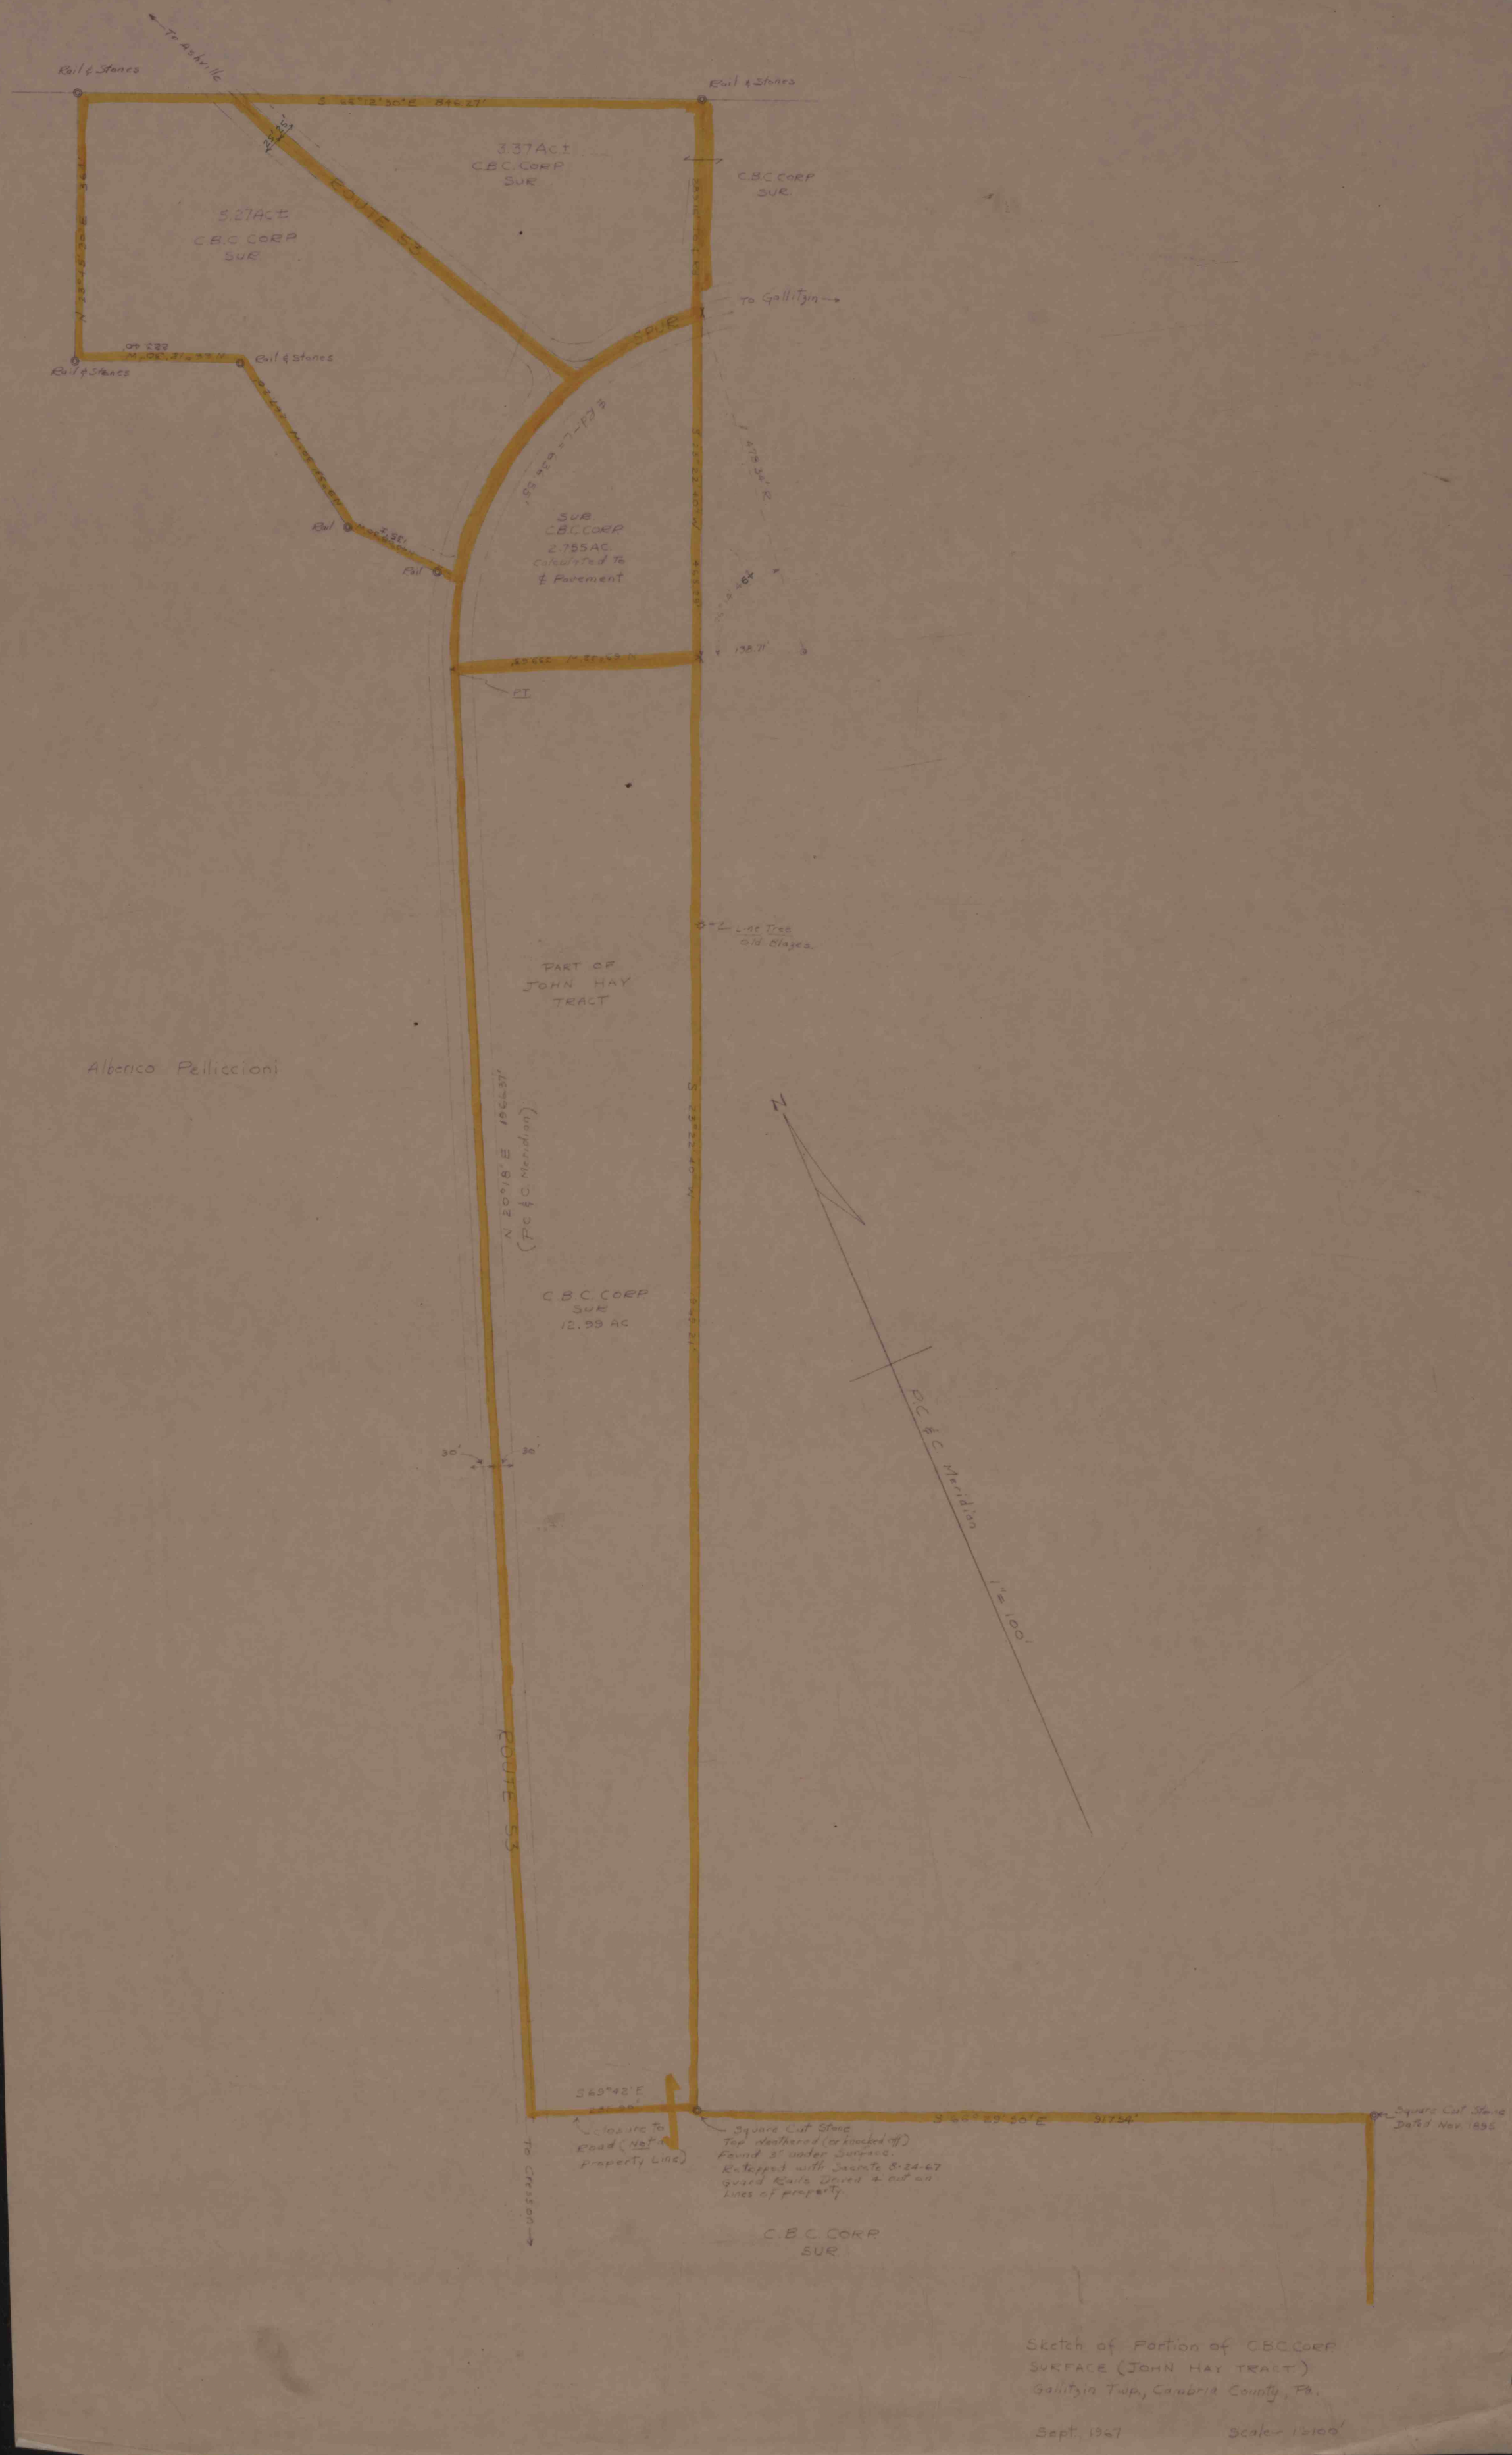

Sketch of Portion of C.B.C. Corp
SURFACE (JOHN HAY TRACT)
Gallitzin Twp., Cambria County, Pa.

Sept. 1967 Scale- 1:100'