


111 2
10

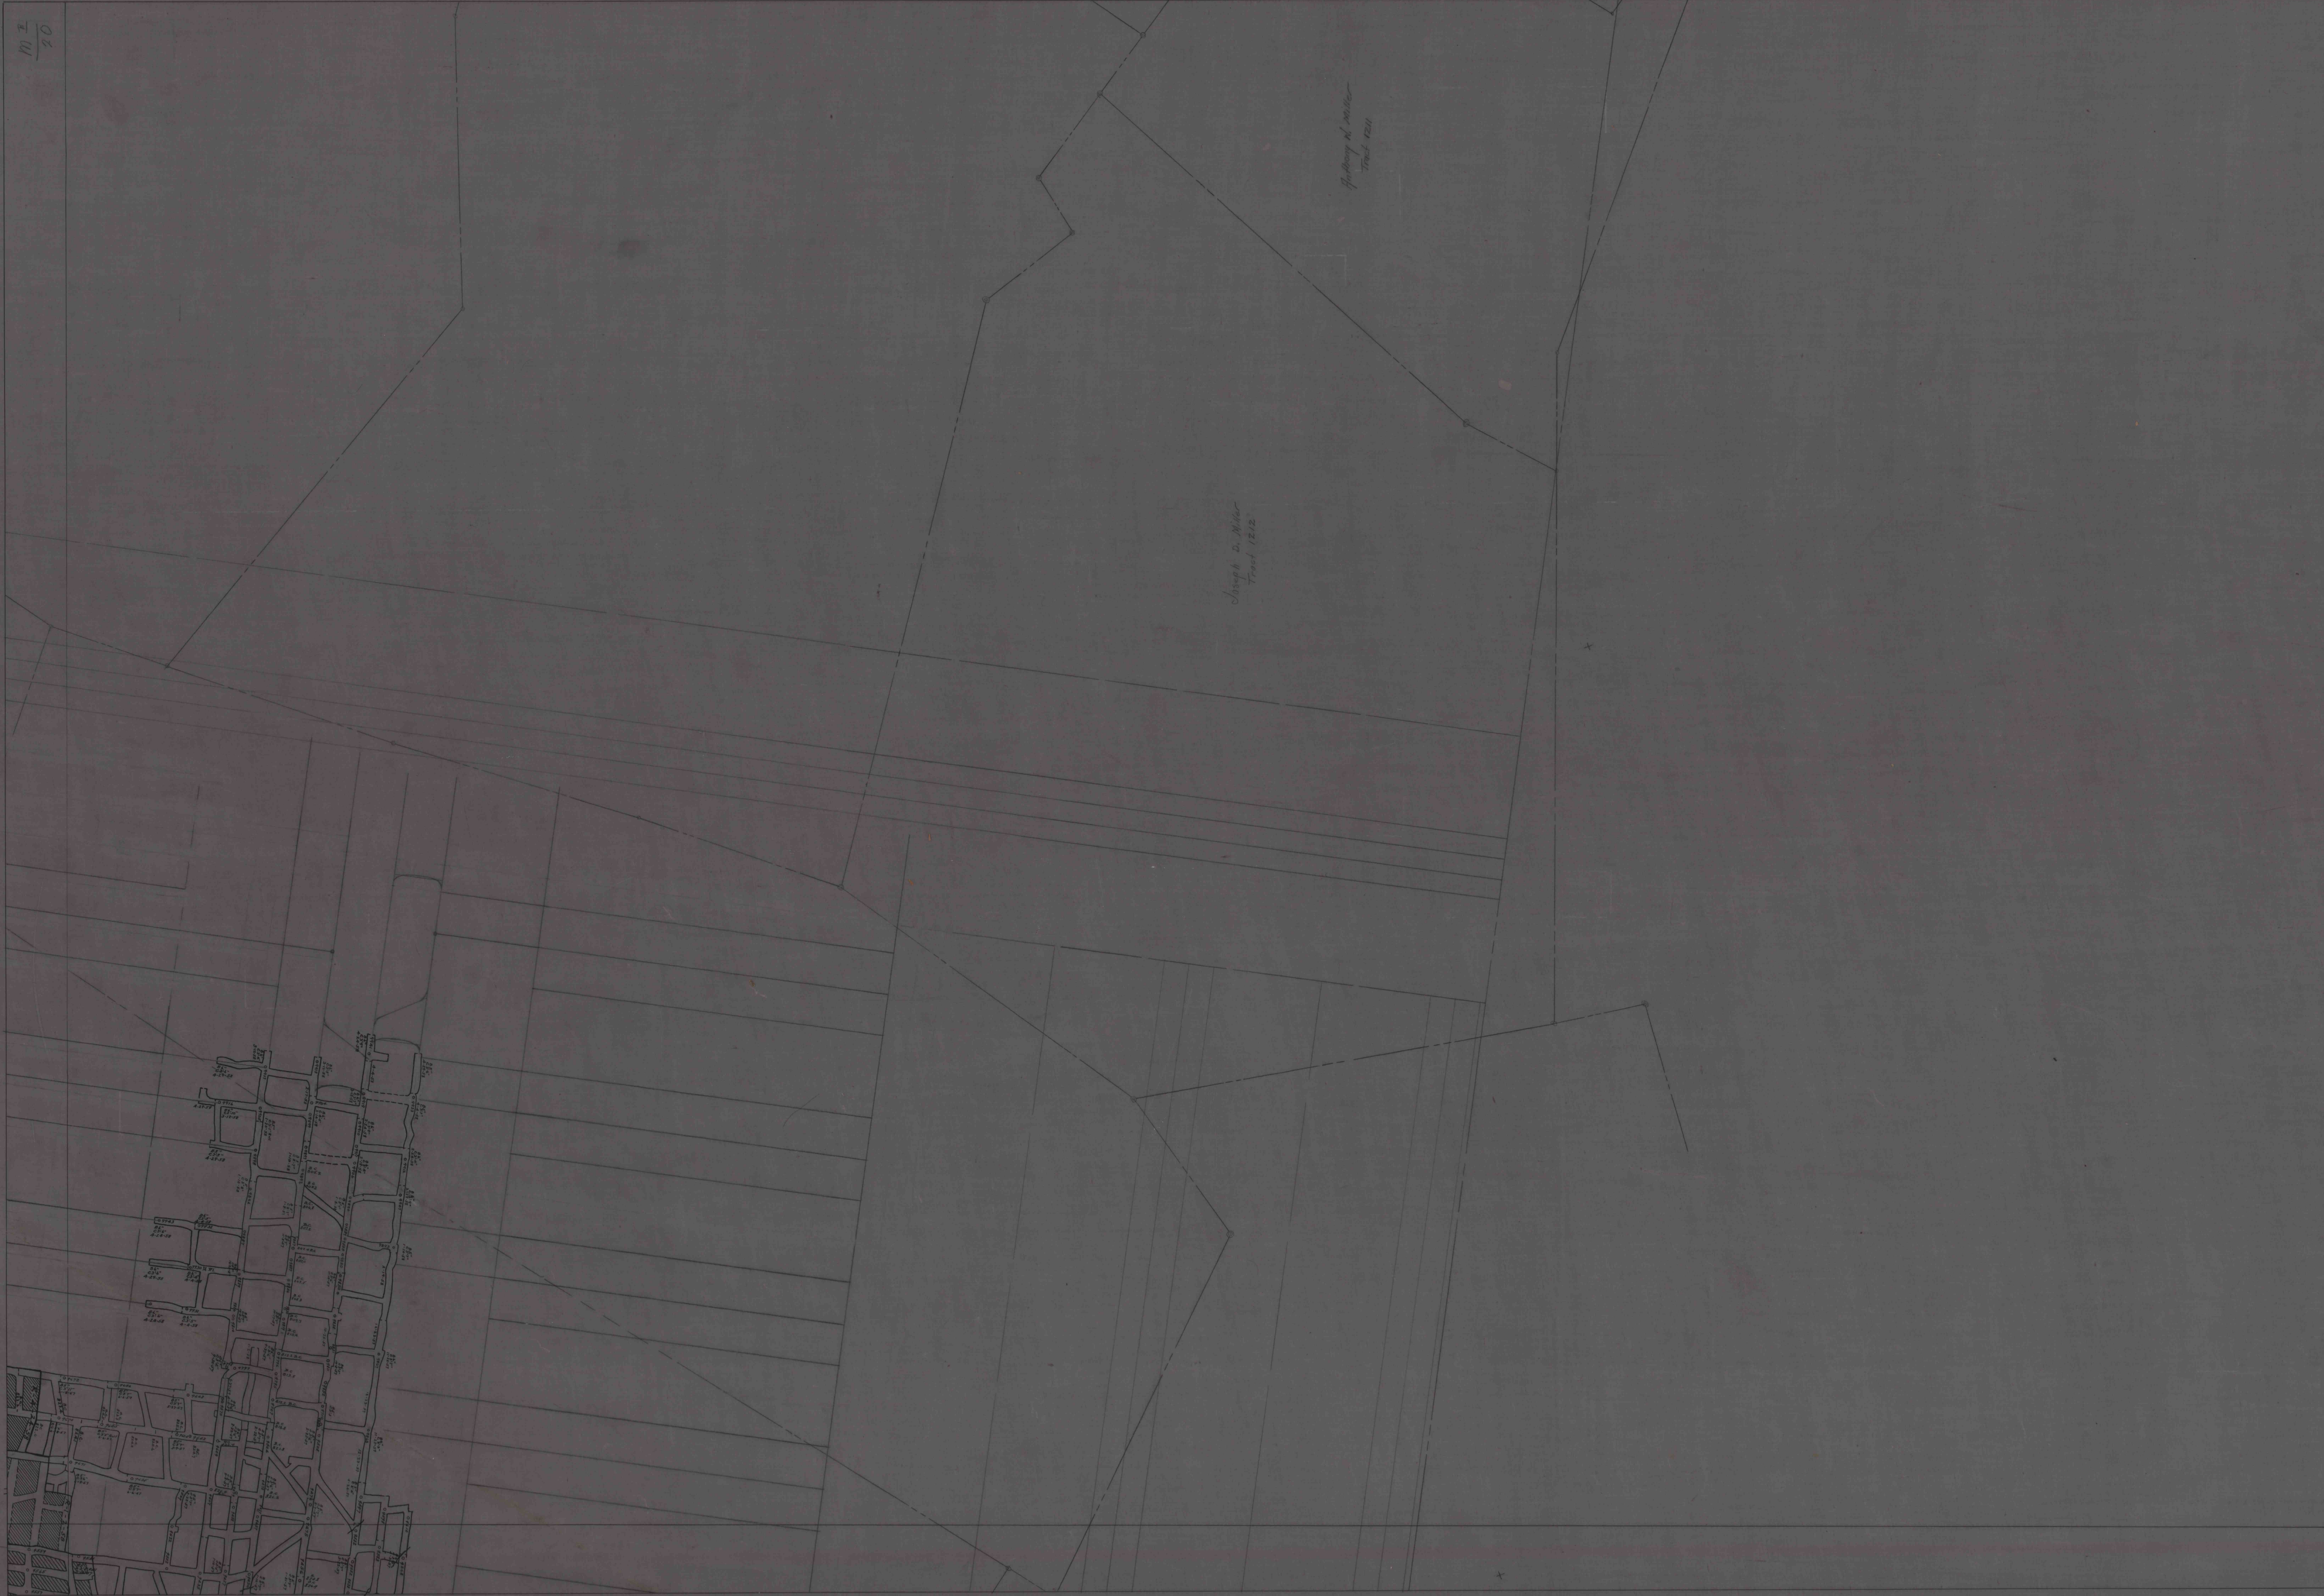

Joseph A. Miller
Tract 1212

