



10/1/40

10/1/40

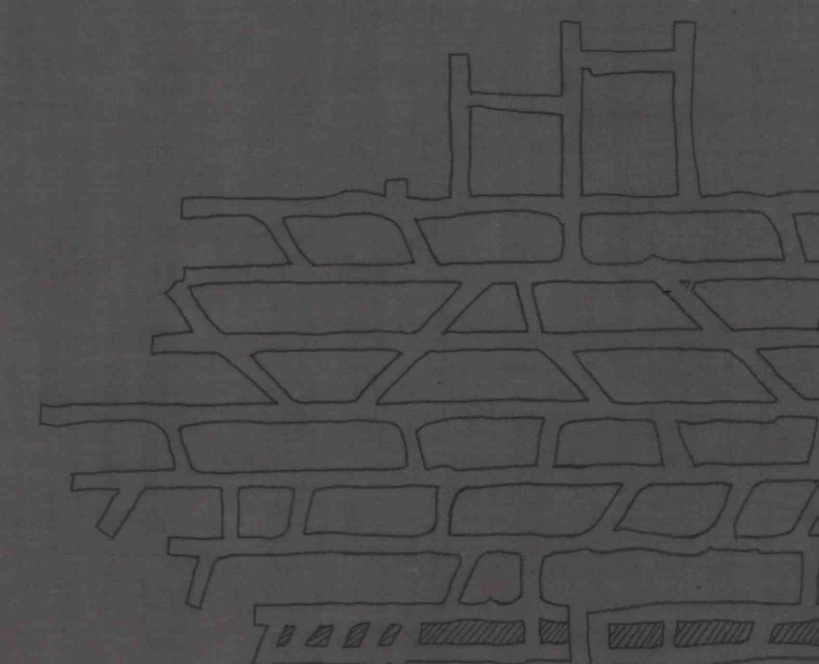

29th St. Tunnel

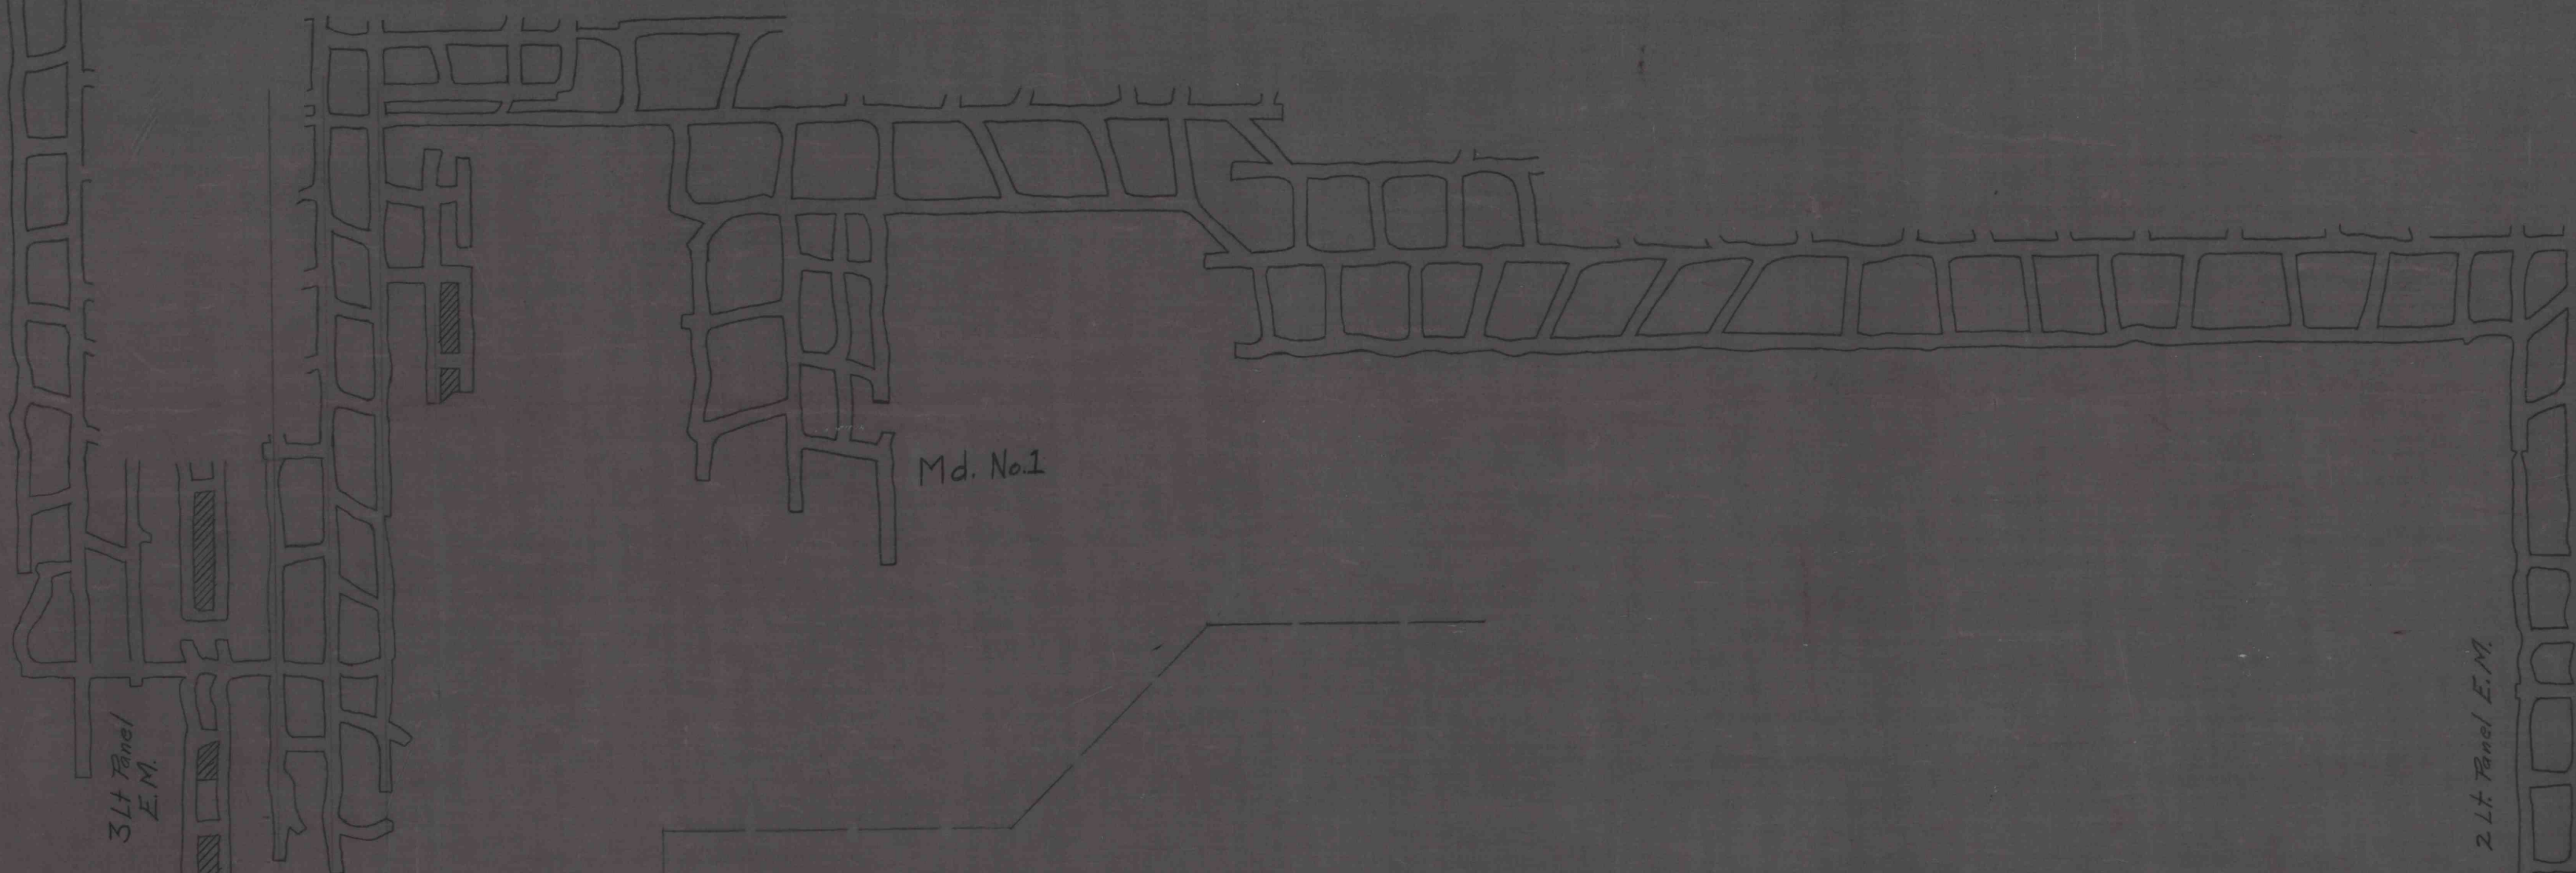


Md. No. 1



No. 2nd Street This Side

Ball

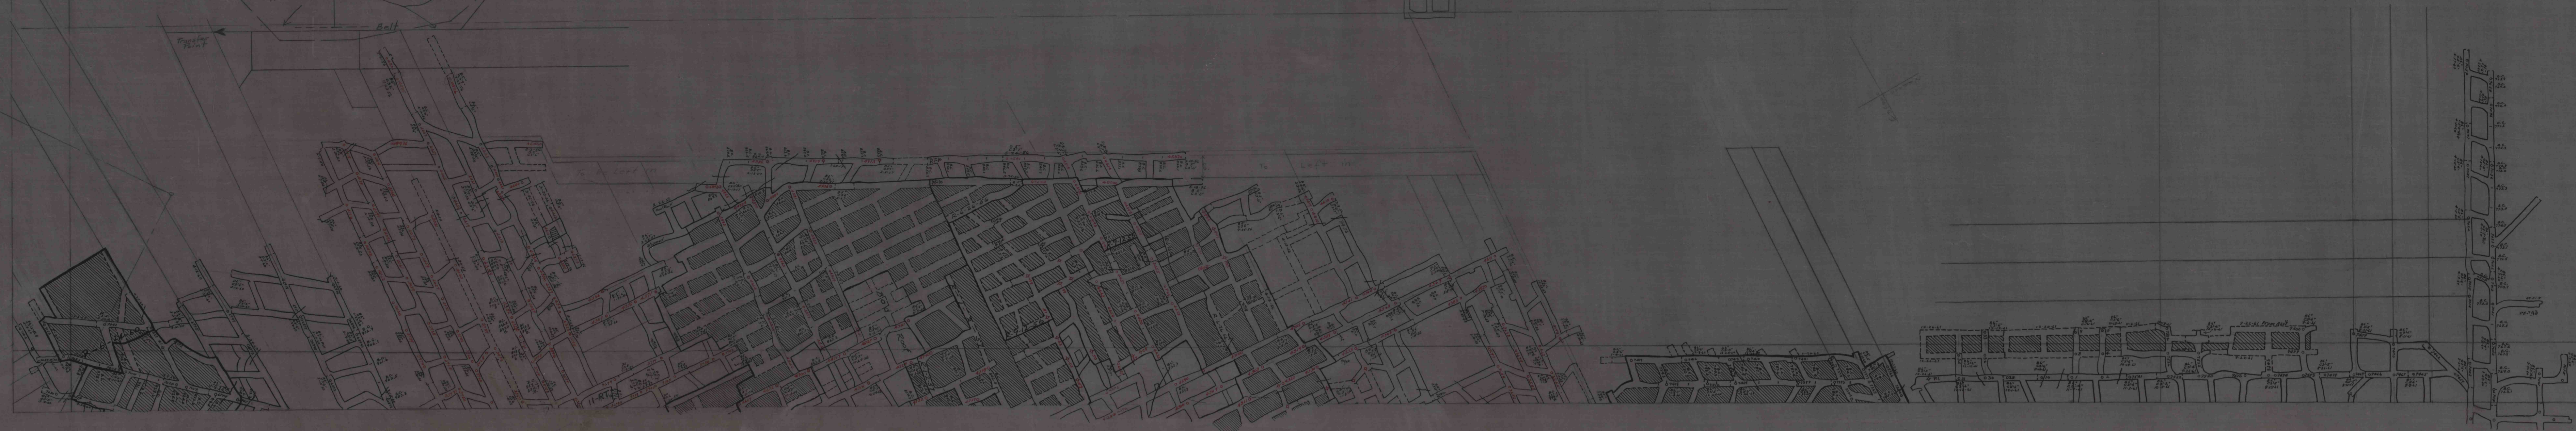

10/1/40