


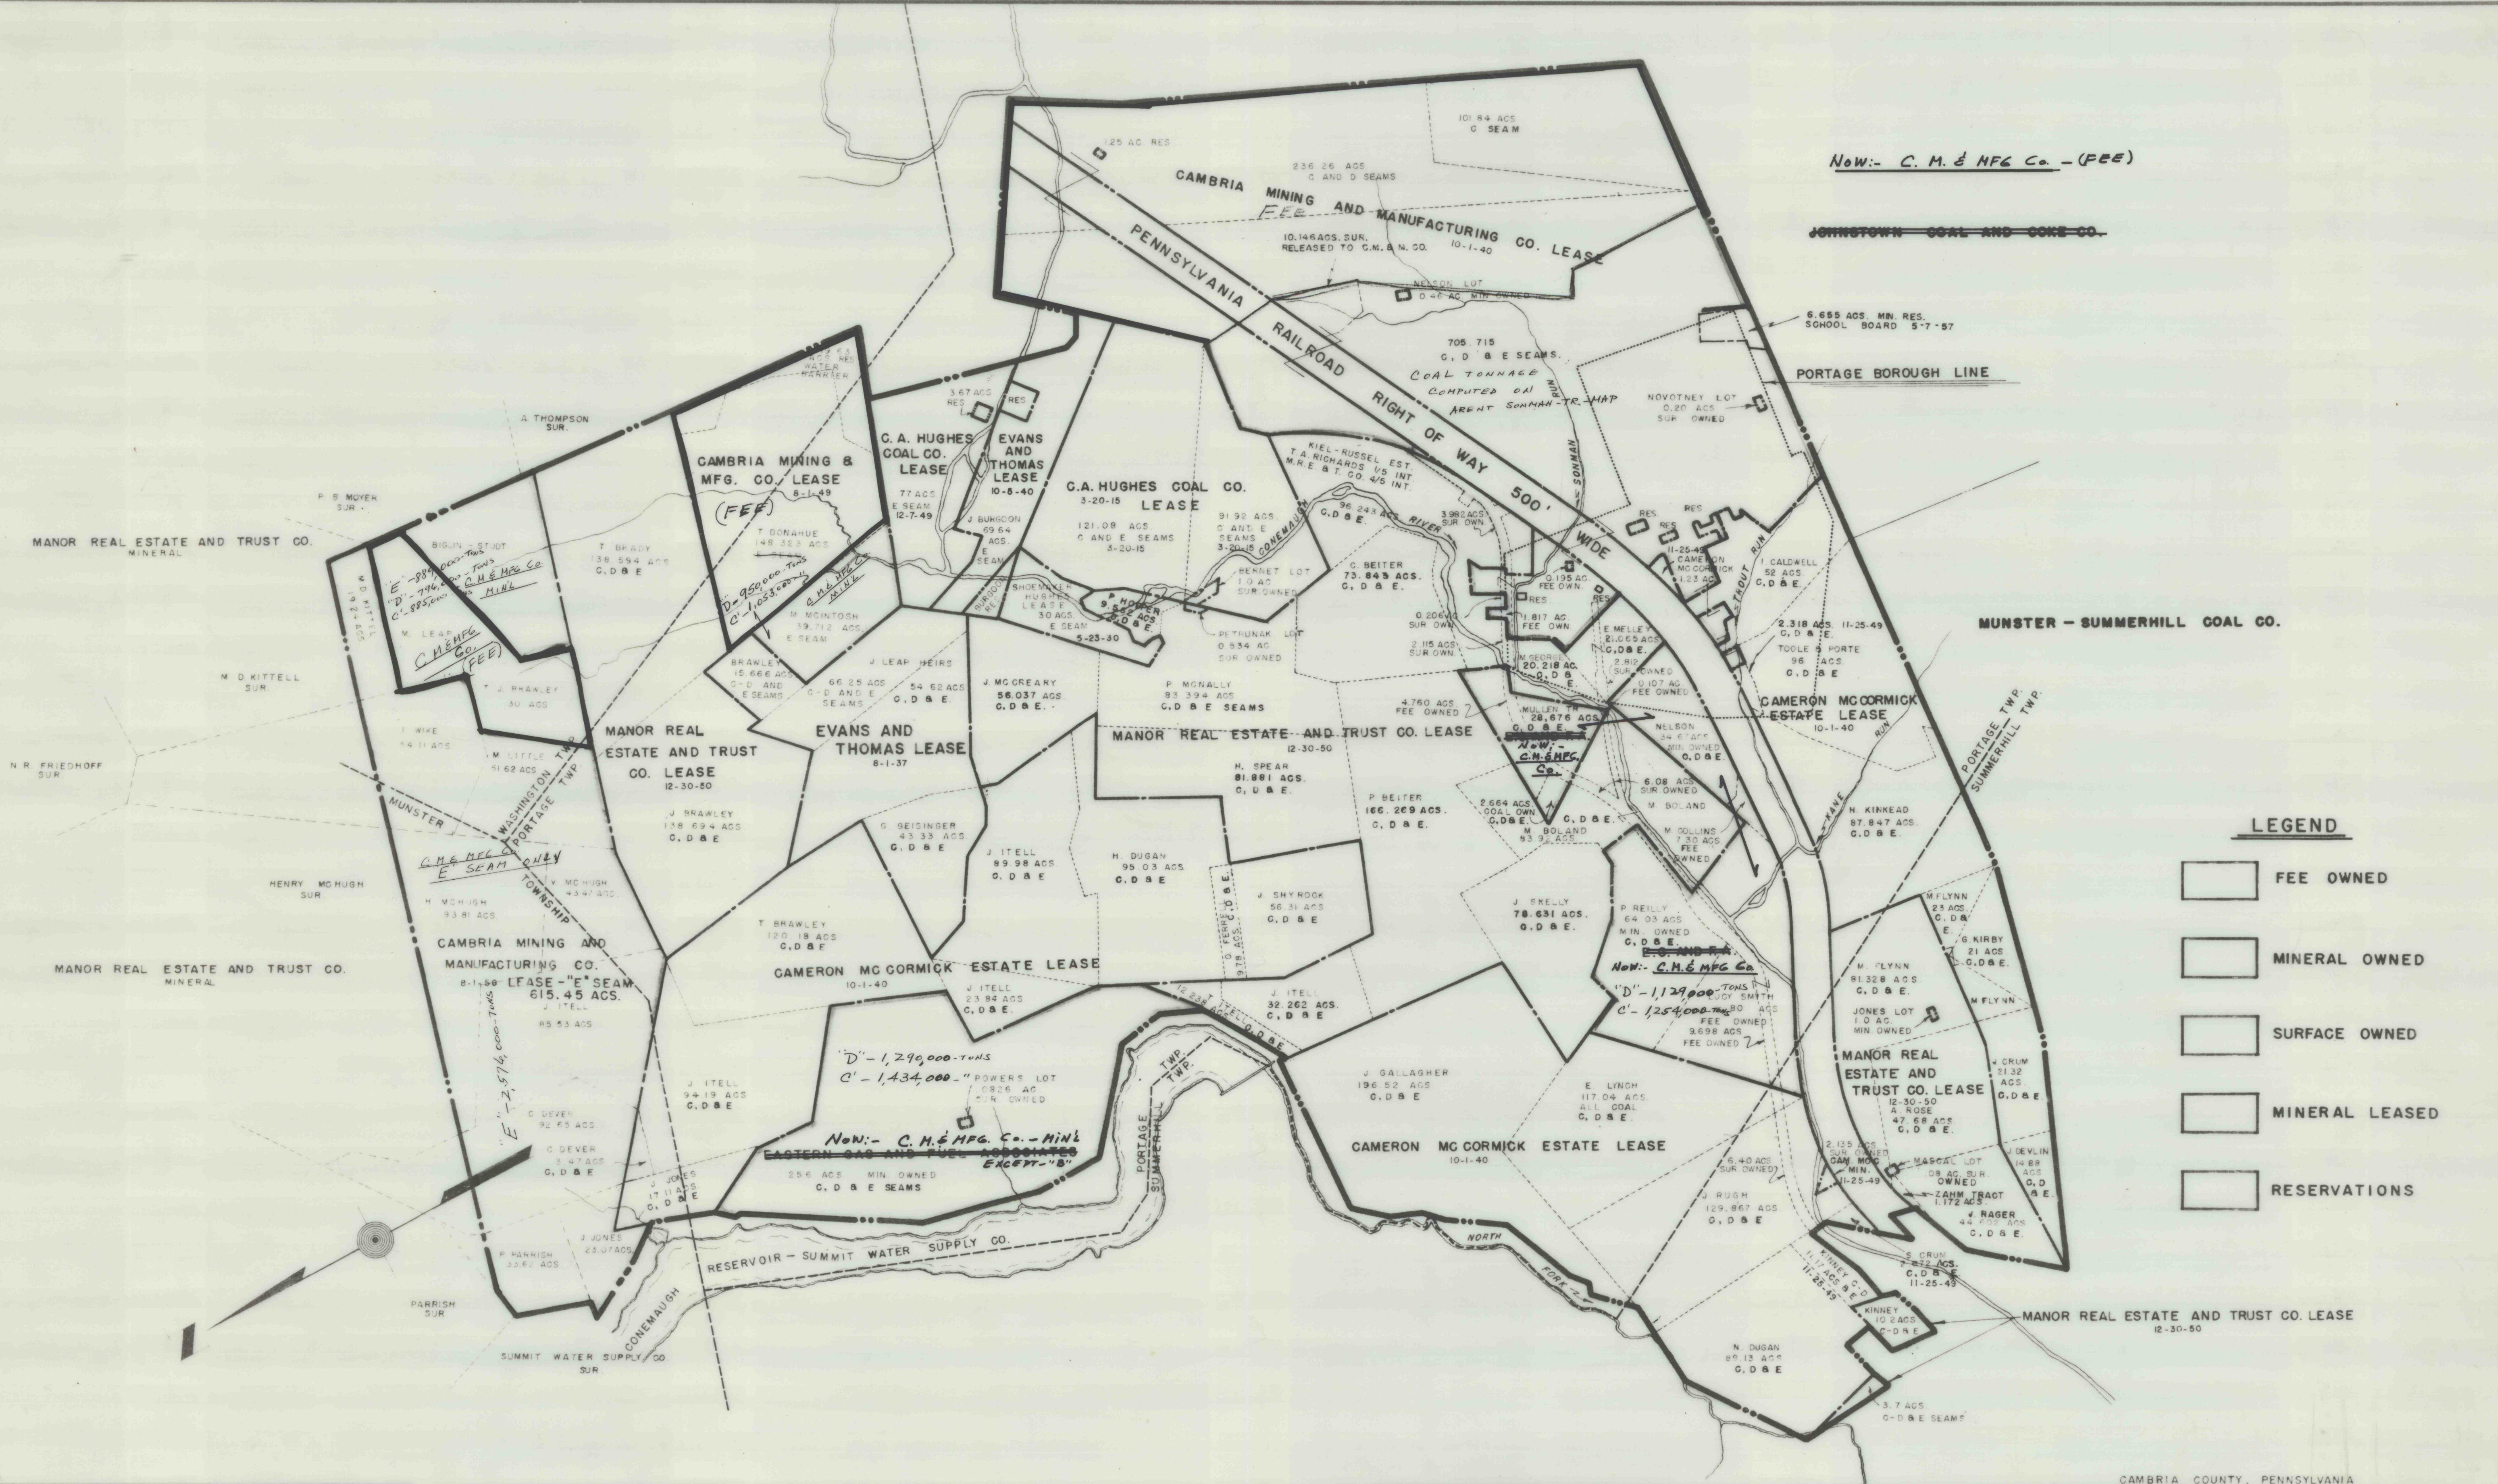

0 1000 2000 3000 4000 5000		FWR		LEASE DATES & TROUT RUN		3-8-63		NAME		DATE		EASTERN GAS AND FUEL ASSOCIATES		SONMAN		SCALE 1"=1000'		B.M. NO.	
POSTED TO 10-6-60		REV.		DESCRIPTION		CHECKED BY		DATE		DRAWN BY V.R.G.		8-23-54		COAL DIVISION		PROPERTY MAP		P-4-11	
REFERENCES		DWG. NO.								APPROVED				PITTSBURGH, PA.					