


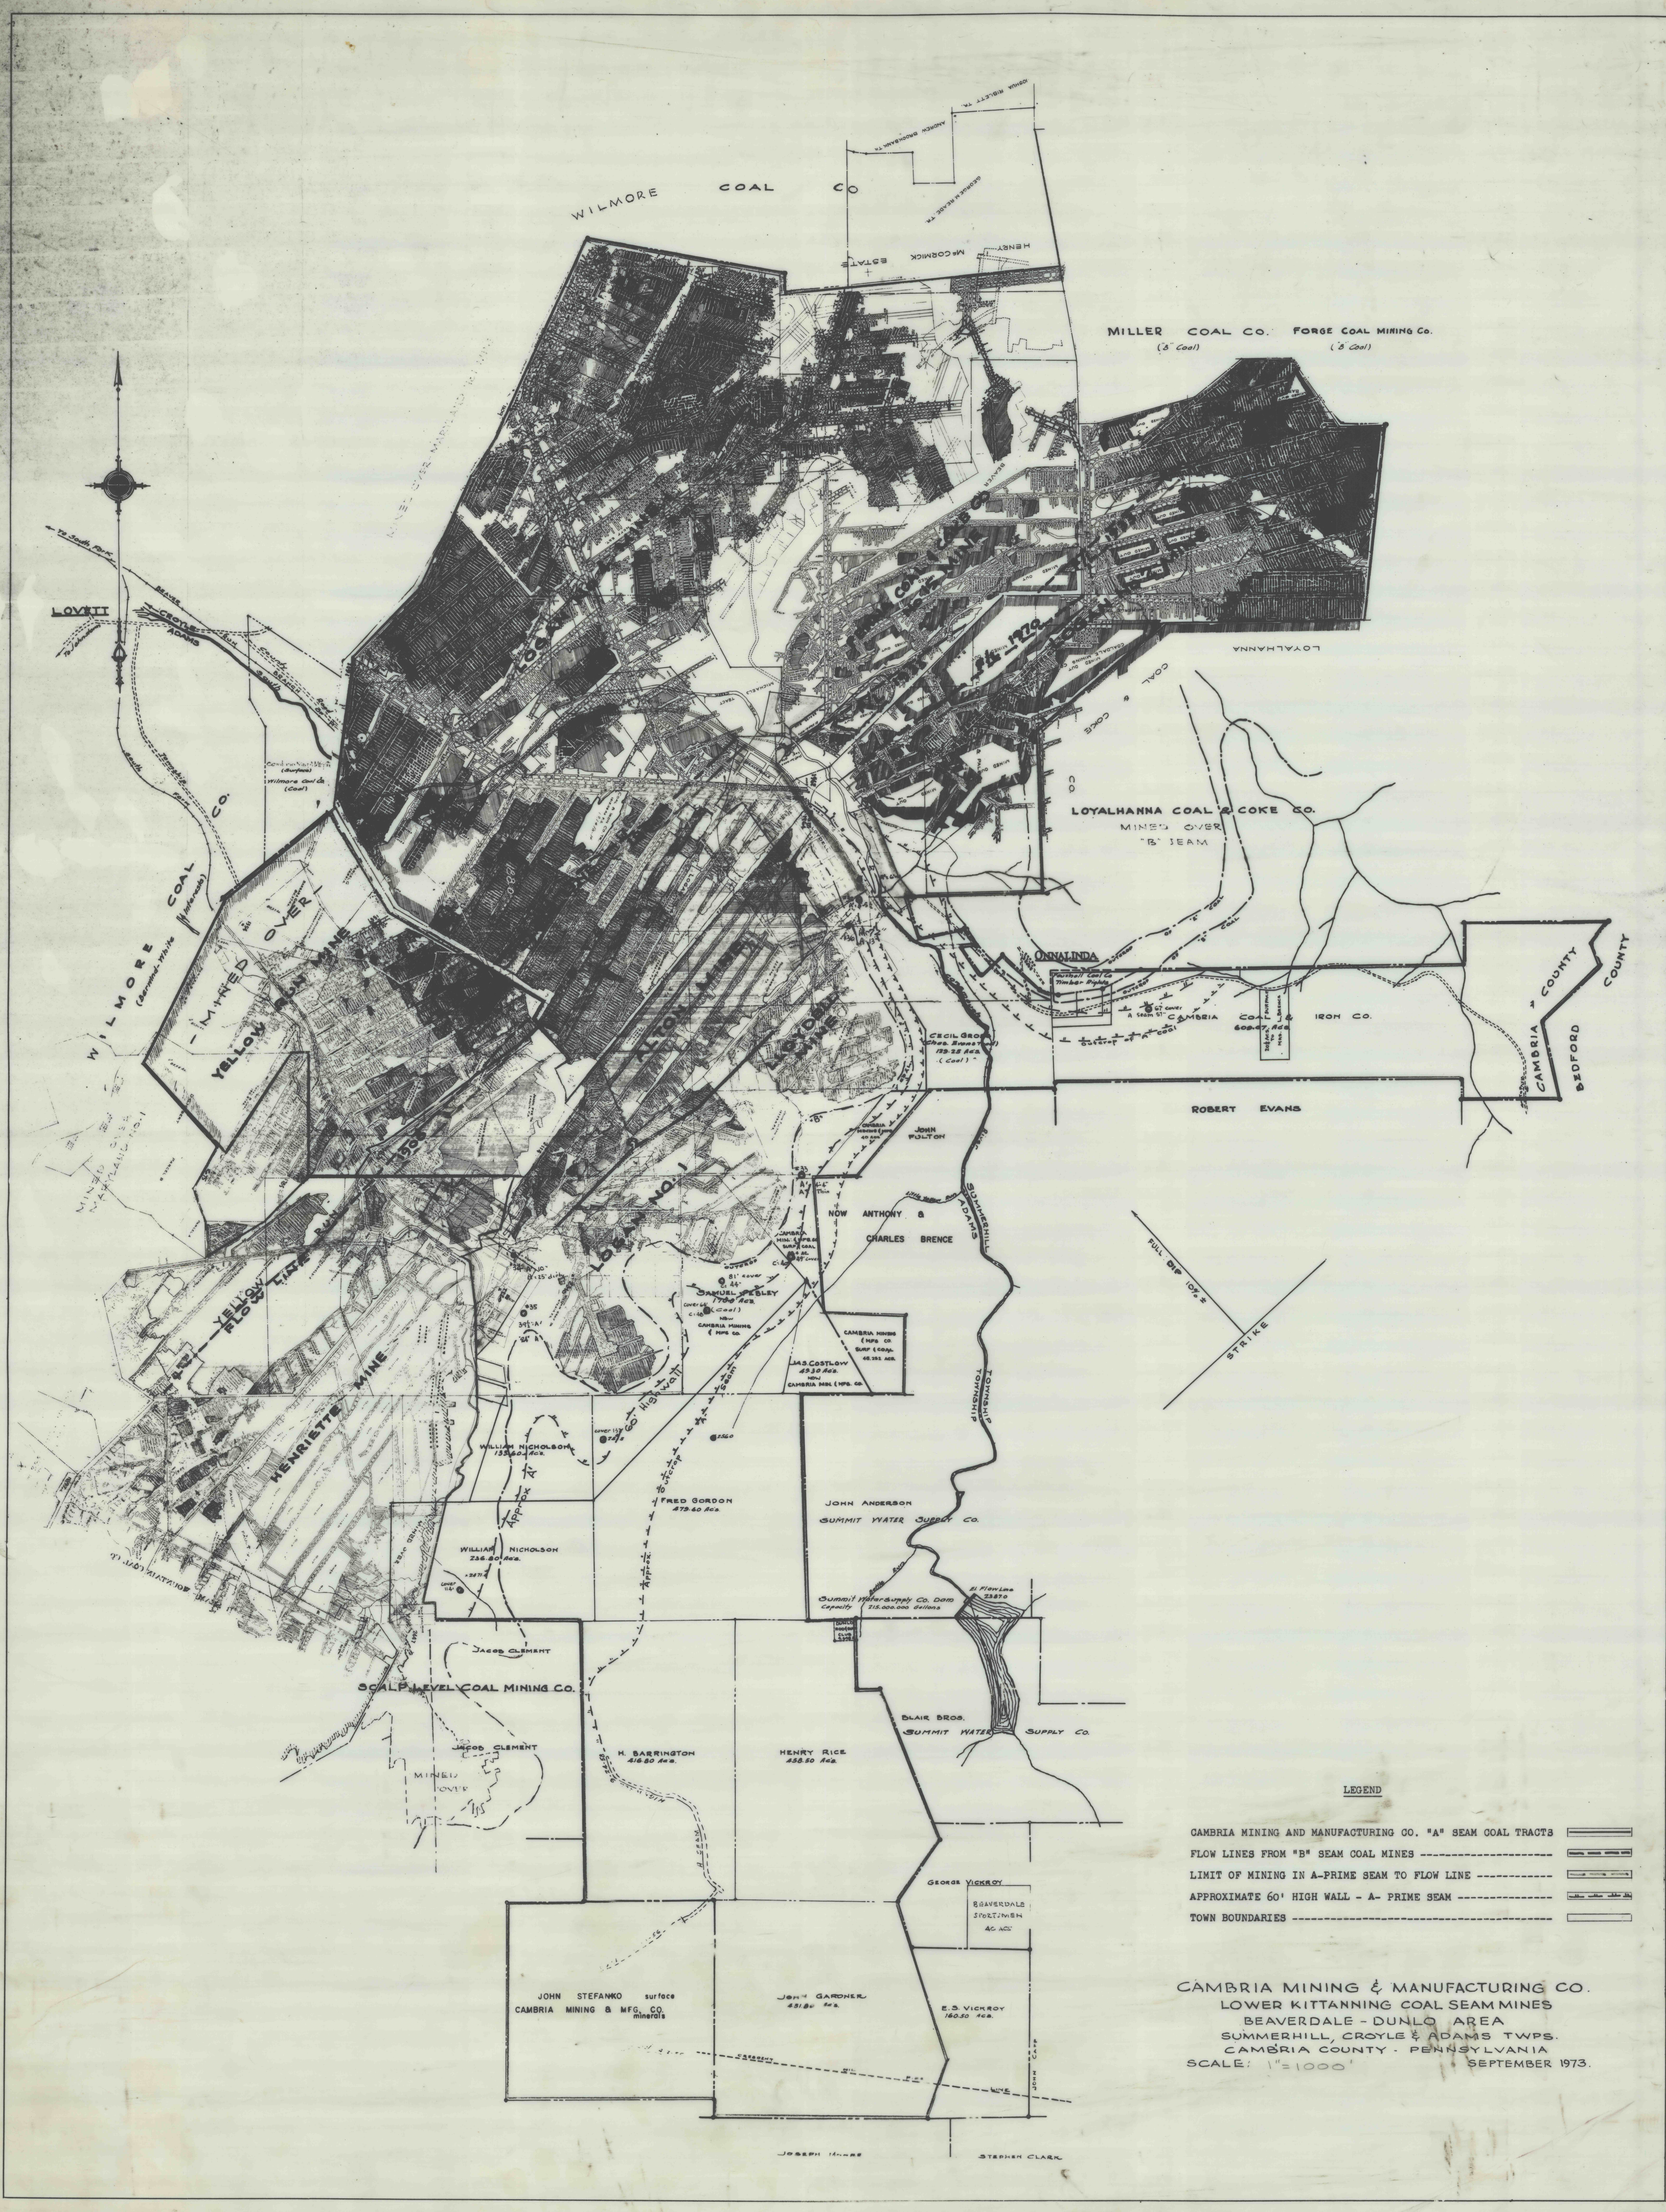

LEGEND

- CAMBRIA MINING AND MANUFACTURING CO. "A" SEAM COAL TRACTS
- FLOW LINES FROM "B" SEAM COAL MINES
- LIMIT OF MINING IN A-PRIME SEAM TO FLOW LINE
- APPROXIMATE 60' HIGH WALL - A-PRIME SEAM
- TOWN BOUNDARIES

CAMBRIA MINING & MANUFACTURING CO.
LOWER KITTANNING COAL SEAM MINES
BEAVERDALE - DUNLO AREA
SUMMERHILL, CROYLE & ADAMS TWPS.
CAMBRIA COUNTY - PENNSYLVANIA
SCALE: 1" = 1000' SEPTEMBER 1973.