REQUIRED LIST								
NO.	NAME	MK.	NO. PCS.	DESCRIPTION	LGTH.	PC. MK.	REMARKS	WT.

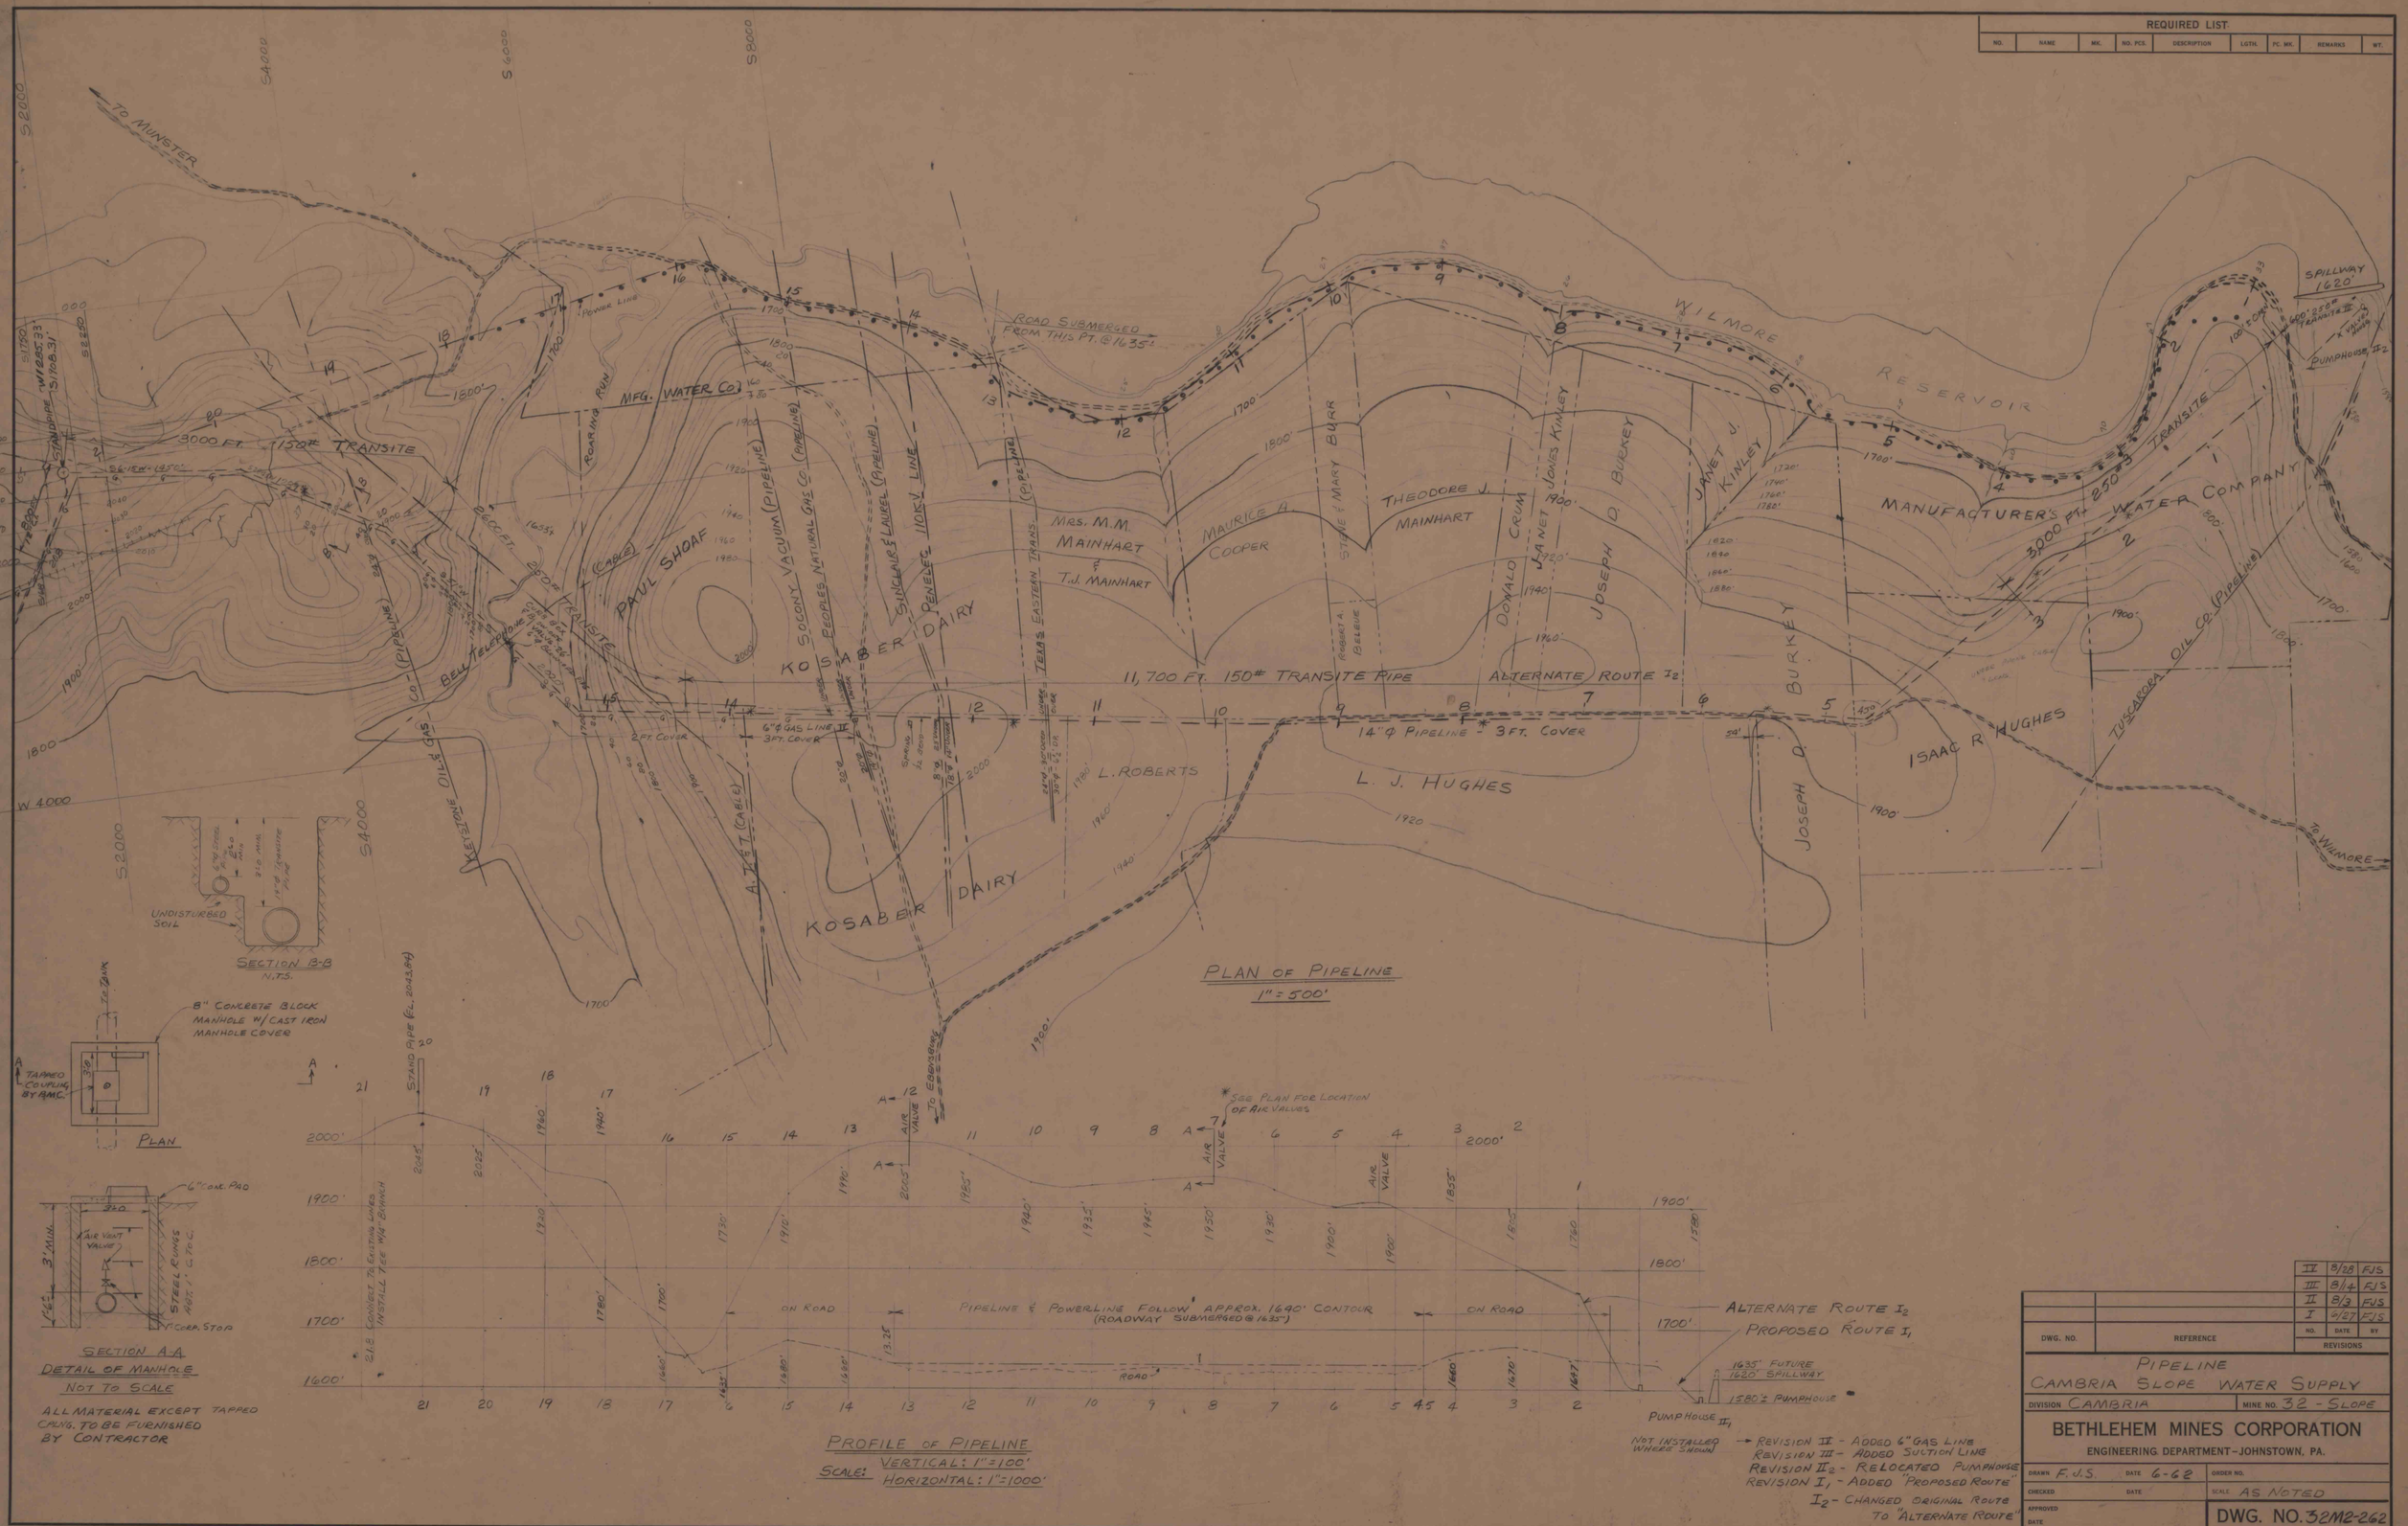

DWG. NO.	REFERENCE	NO.	DATE	BY
		IV	8/28	F.J.S.
		III	8/14	F.J.S.
		II	8/3	F.J.S.
		I	4/27	F.J.S.

REVISIONS

→ REVISION II - ADDED 6" GAS LINE
REVISION III - ADDED SUCTION LINE
REVISION II2 - RELOCATED PUMPHOUSE
REVISION I1 - ADDED "PROPOSED ROUTE"
I2 - CHANGED ORIGINAL ROUTE TO "ALTERNATE ROUTE"

PIPELINE
CAMBRIA SLOPE WATER SUPPLY

DIVISION CAMBRIA — MINE NO. 32 - SLOPE

BETHLEHEM MINES CORPORATION
ENGINEERING DEPARTMENT - JOHNSTOWN, PA.

DRAWN F.J.S.	DATE 6-62	ORDER NO.	
CHECKED	DATE	SCALE AS NOTED	
APPROVED	DATE	DWG. NO. 32M2-262	